

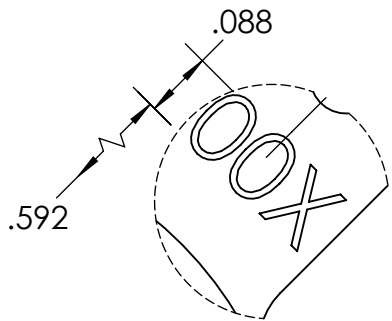
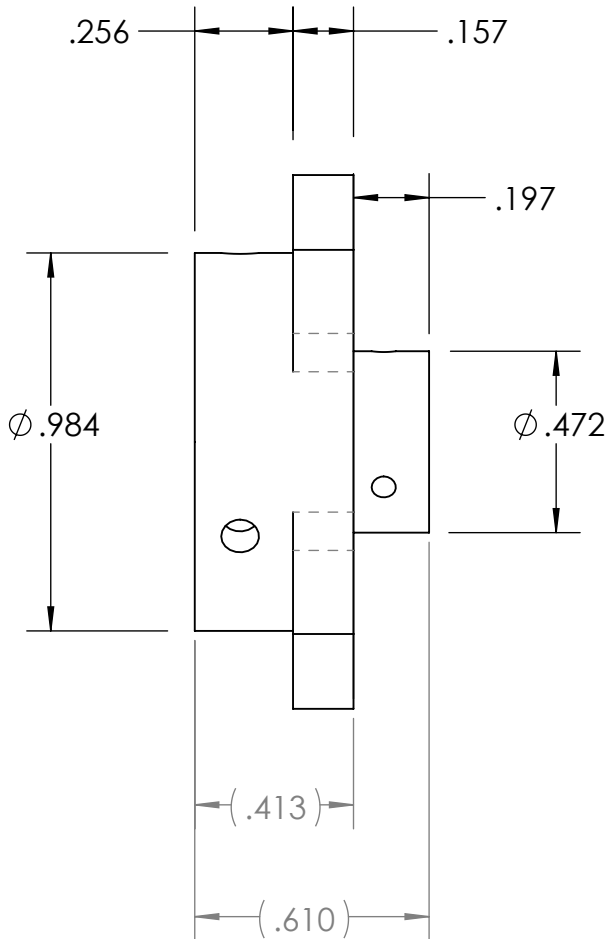
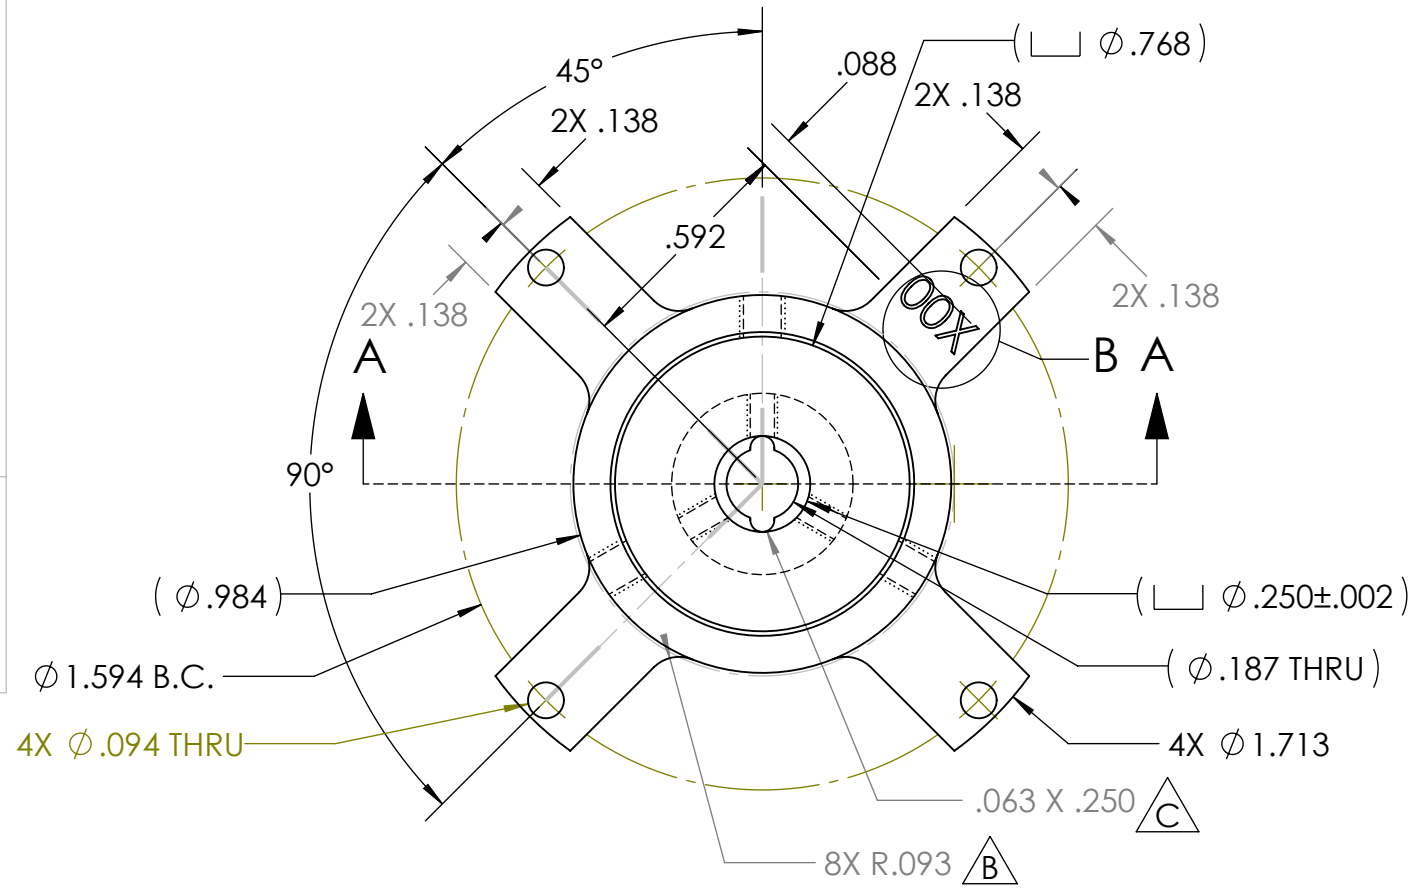


THE INFORMATION CONTAINED IN THIS DRAWING IS THE SOLE PROPERTY OF MBARI ANY REPRODUCTION IN PART OR WHOLE WITHOUT THE WRITTEN PERMISSION OF MBARI IS PROHIBITED.

2		REVISIONS			
ZONE	INITIAL	RELEASE	DESCRIPTION	DATE X/XX/XX	APPROVED J.E.
B1	A		ADD SERIAL NO.	3/12/2020	J.E.
B1, B3	B		CHG RAD. frm .079 to .093 CHG SERIAL NO. POSITION	9/3/2020	J.E.
A4, B3	C		CHG BORE DIA> & TOL> to .250frm .256 ADD SLOT	9/28/2020	J.E.

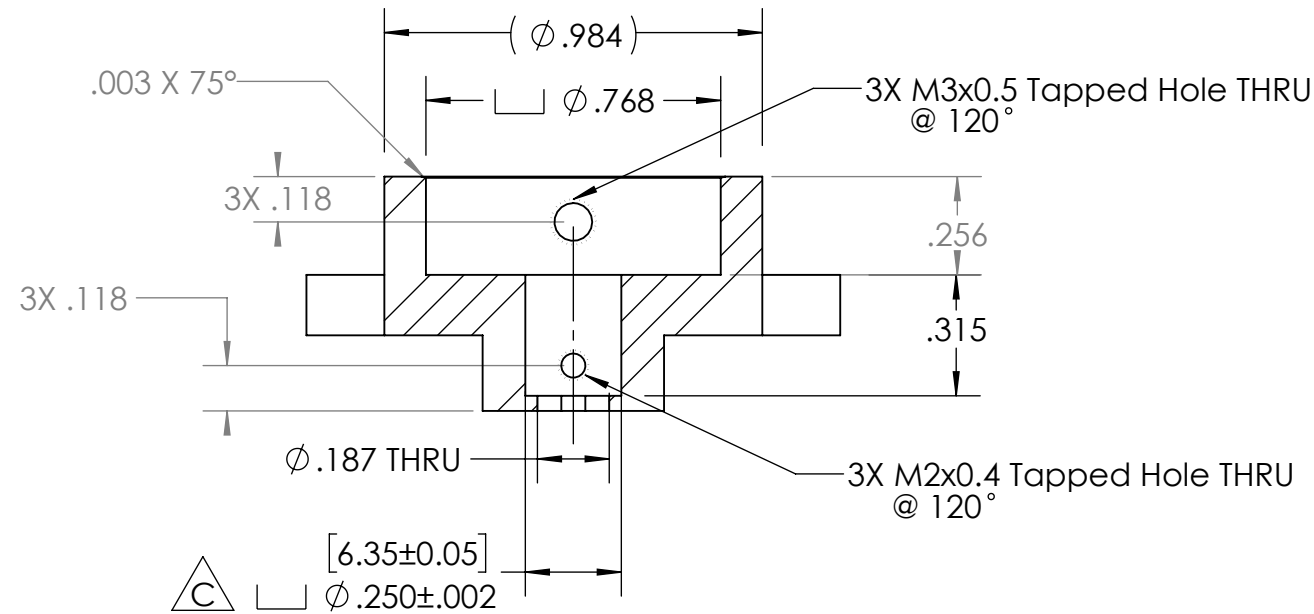

DETAIL B
SCALE 4 : 1
Serial No.

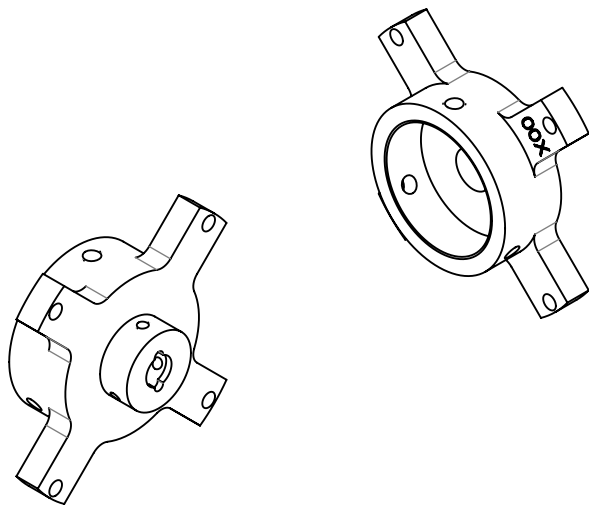

SECTION A-A

8. Sequential Serial No.'s: 001 - 00x

7. PROJECT LIBRARY:\901506 DeepPIV\ME Drawings\Remote Head_V7

NOTES: (CONT. FROM TITLE BLOCK)

1	1	P-201965-18	Powell Lens Adaptor - Shafter	MBARI	PEEK
ITEM NO.	QTY.	Part_Number	DESCRIPTION	Vendor	MATERIAL

BILL OF MATERIALS									
Shop / Q.C.		UNLESS OTHERWISE SPECIFIED TOLERANCES ARE:				APPROVALS		DATE	
Inspector		1 PLACE DIM ±1/16	2 PLACE DIM ±.02	3 PLACE DIM ±.005	ANGLES ±1°	DRAWN	J. ERICKSON	2/15/18	
Shop Foreman		1. DIMENSIONS ARE IN INCHES 2. DIMENSION LIMITS HELD AFTER PLATING. 3. REMOVE BURRS AND SHARP EDGES .015 MAX. 4. MACHINED FILLET RADII .0150-.030. 5. MACHINED DIAMETERS ON A COMMON CENTERLINE CONCENTRIC WITHIN .005 6. PERPENDICULARITY & PARALLELISM OF MACHINED SURFACES .002 PER RICH MAX .012 INCHES FOR SINGLE SURFACE.				ENGINEER	J. ERICKSON	2/15/18	
Engineer						CHECKED			
NEXT ASSY Description	NEXT ASSY Number					PROJECT NO.		901506	
	A-201785-16	PROJECT		Deep PIV		REMOTE LASER HEAD R.A. Powell Lens Adaptor - Shafter			
Application		DO NOT SCALE DRAWING		WEIGHT					
						SHEET B	DWG. NO. P-201965-18.DWG		REV. C
						SCALE 2:1	CAD FILE: MECH ENG ON TORNADO		SHEET 1 OF 1

Monterey Bay Aquarium Research Institute
MBARI
7700 Sandholdt RD.
Moss Landing, CA 95039
PH: (831) 775-1700

