
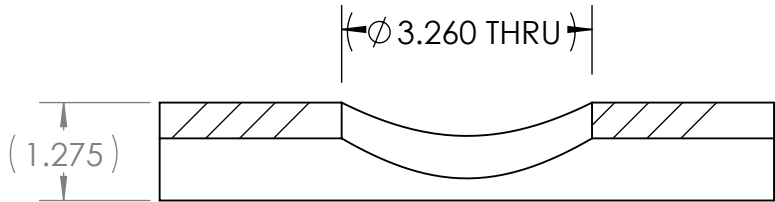
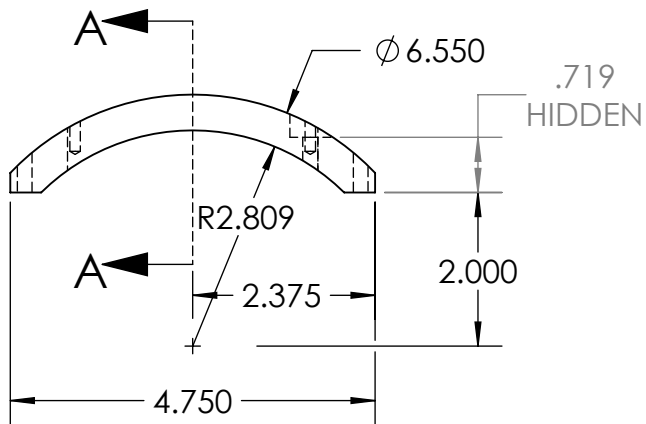
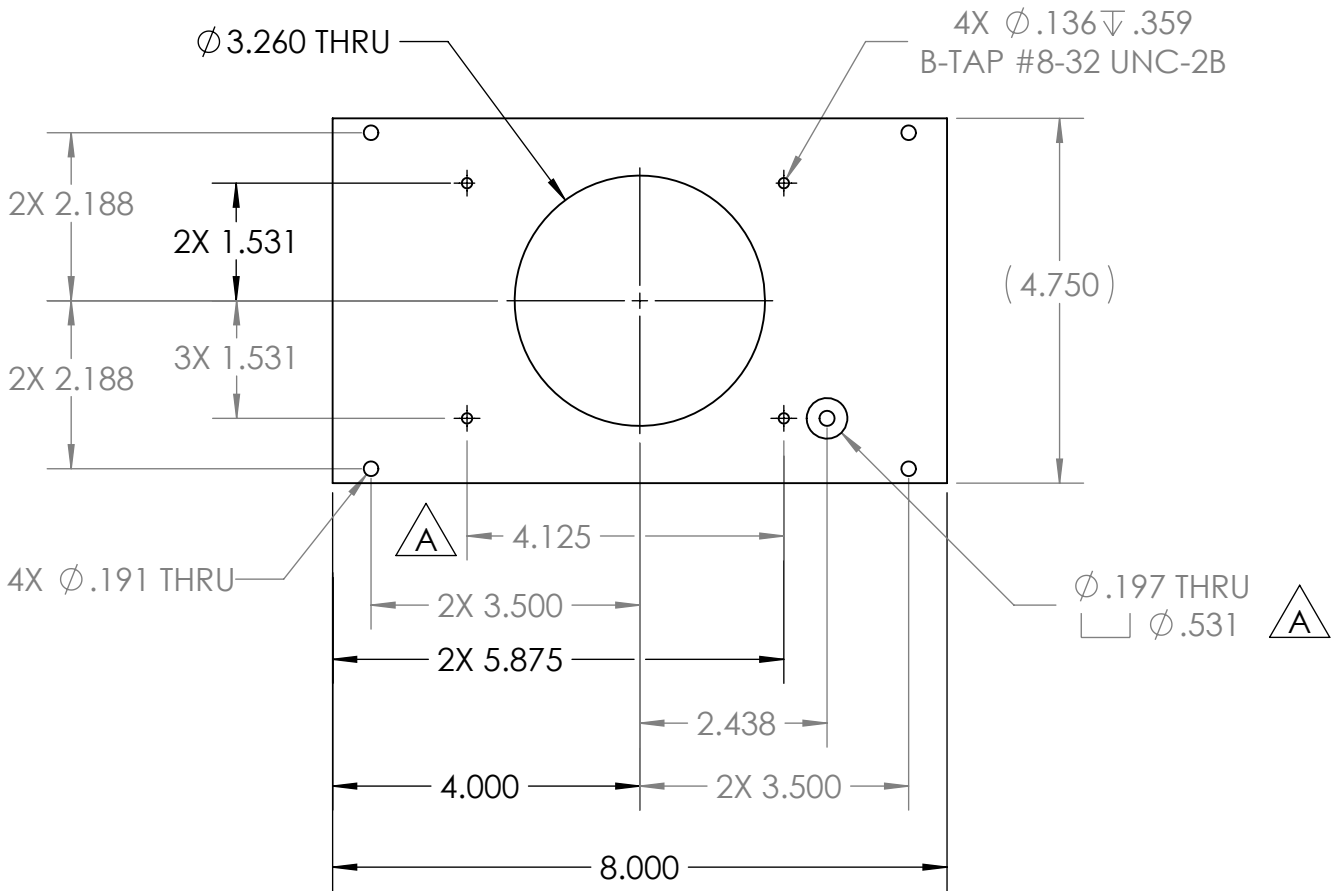


THE INFORMATION CONTAINED IN THIS DRAWING IS THE SOLE PROPERTY OF MBARI ANY REPRODUCTION IN PART OR WHOLE WITHOUT THE WRITTEN PERMISSION OF MBARI IS PROHIBITED.

REVISIONS				
INITIAL RELEASE			X/XX/01	J.E.
REVISIONS				
ZONE	REV.	DESCRIPTION	DATE	APPROVED
B2, B3	A	ADDED MISSING DIM. ADDED CNTR BORE	9/17/2018	J.E.

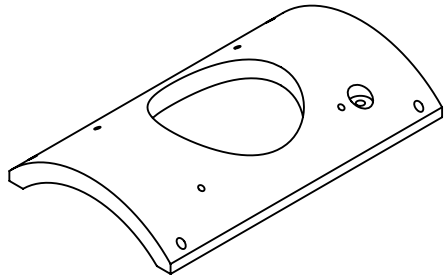

SECTION A-A
SCALE 1 : 2.5

R.P. in ABS mat'l, COLOR: NATURAL
FORTUS 400 - TIP SIZE .005

8. All dimensions are symetric about common center lines unless specified otherwise.
7. PROJECT LIBRARY:\901608 Waveglider Towbody and Sensor Payload\WG_Micro-Assem
- NOTES: (CONT. FROM TITLE BLOCK)

1	1	P-202xxx-18	Test Housing	MBARI	ABS
ITEM NO.	QTY.	Part_Number	DESCRIPTION	Vendor	MATERIAL
BILL OF MATERIALS					
Shop / Q.C.		UNLESS OTHERWISE SPECIFIED TOLERANCES ARE:		APPROVALS DATE	
Inspector		1 PLACE DIM ±1/16	2 PLACE DIM ±.02	3 PLACE DIM ±.005	ANGLES ±1°
Shop Foreman		1. DIMENSIONS ARE IN INCHES		DRAWN J. ERICKSON 6/11/18	
Engineer		2. DIMENSION LIMITS HELD AFTER PLATING.		ENGINEER J. ERICKSON 6/11/18	
		3. REMOVE BURRS AND SHARP EDGES .015 MAX.		CHECKED	
		4. MACHINED FILLET RADII .0150-.030.		PROJECT NO. 901608	
NEXT ASSY Description	NEXT ASSY Number	5. MACHINED DIAMETERS ON A COMMON CENTERLINE CONCENTRIC WITHIN .005		PROJECT WG - MICRO	
	A-202009-18	6. PERPENDICULARITY & PARALLELISM OF MACHINED SURFACES .002 PER INCH. MAX .012 INCHES FOR SINGLE SURFACE.		WEIGHT 0.545	
Application		DO NOT SCALE DRAWING		SIZE B DWG. NO. P-202xxx-18.DWG	
				SCALE 1:8 CAD FILE: MECH ENG ON TORNADO SHEET 1 OF 1	

Monterey Bay Aquarium Research Institute
MBARI
7700 Sandholdt RD.
Moss Landing, CA 95039
PH: (831) 775-1700



WG - TOW BODY
Test Housing

A