


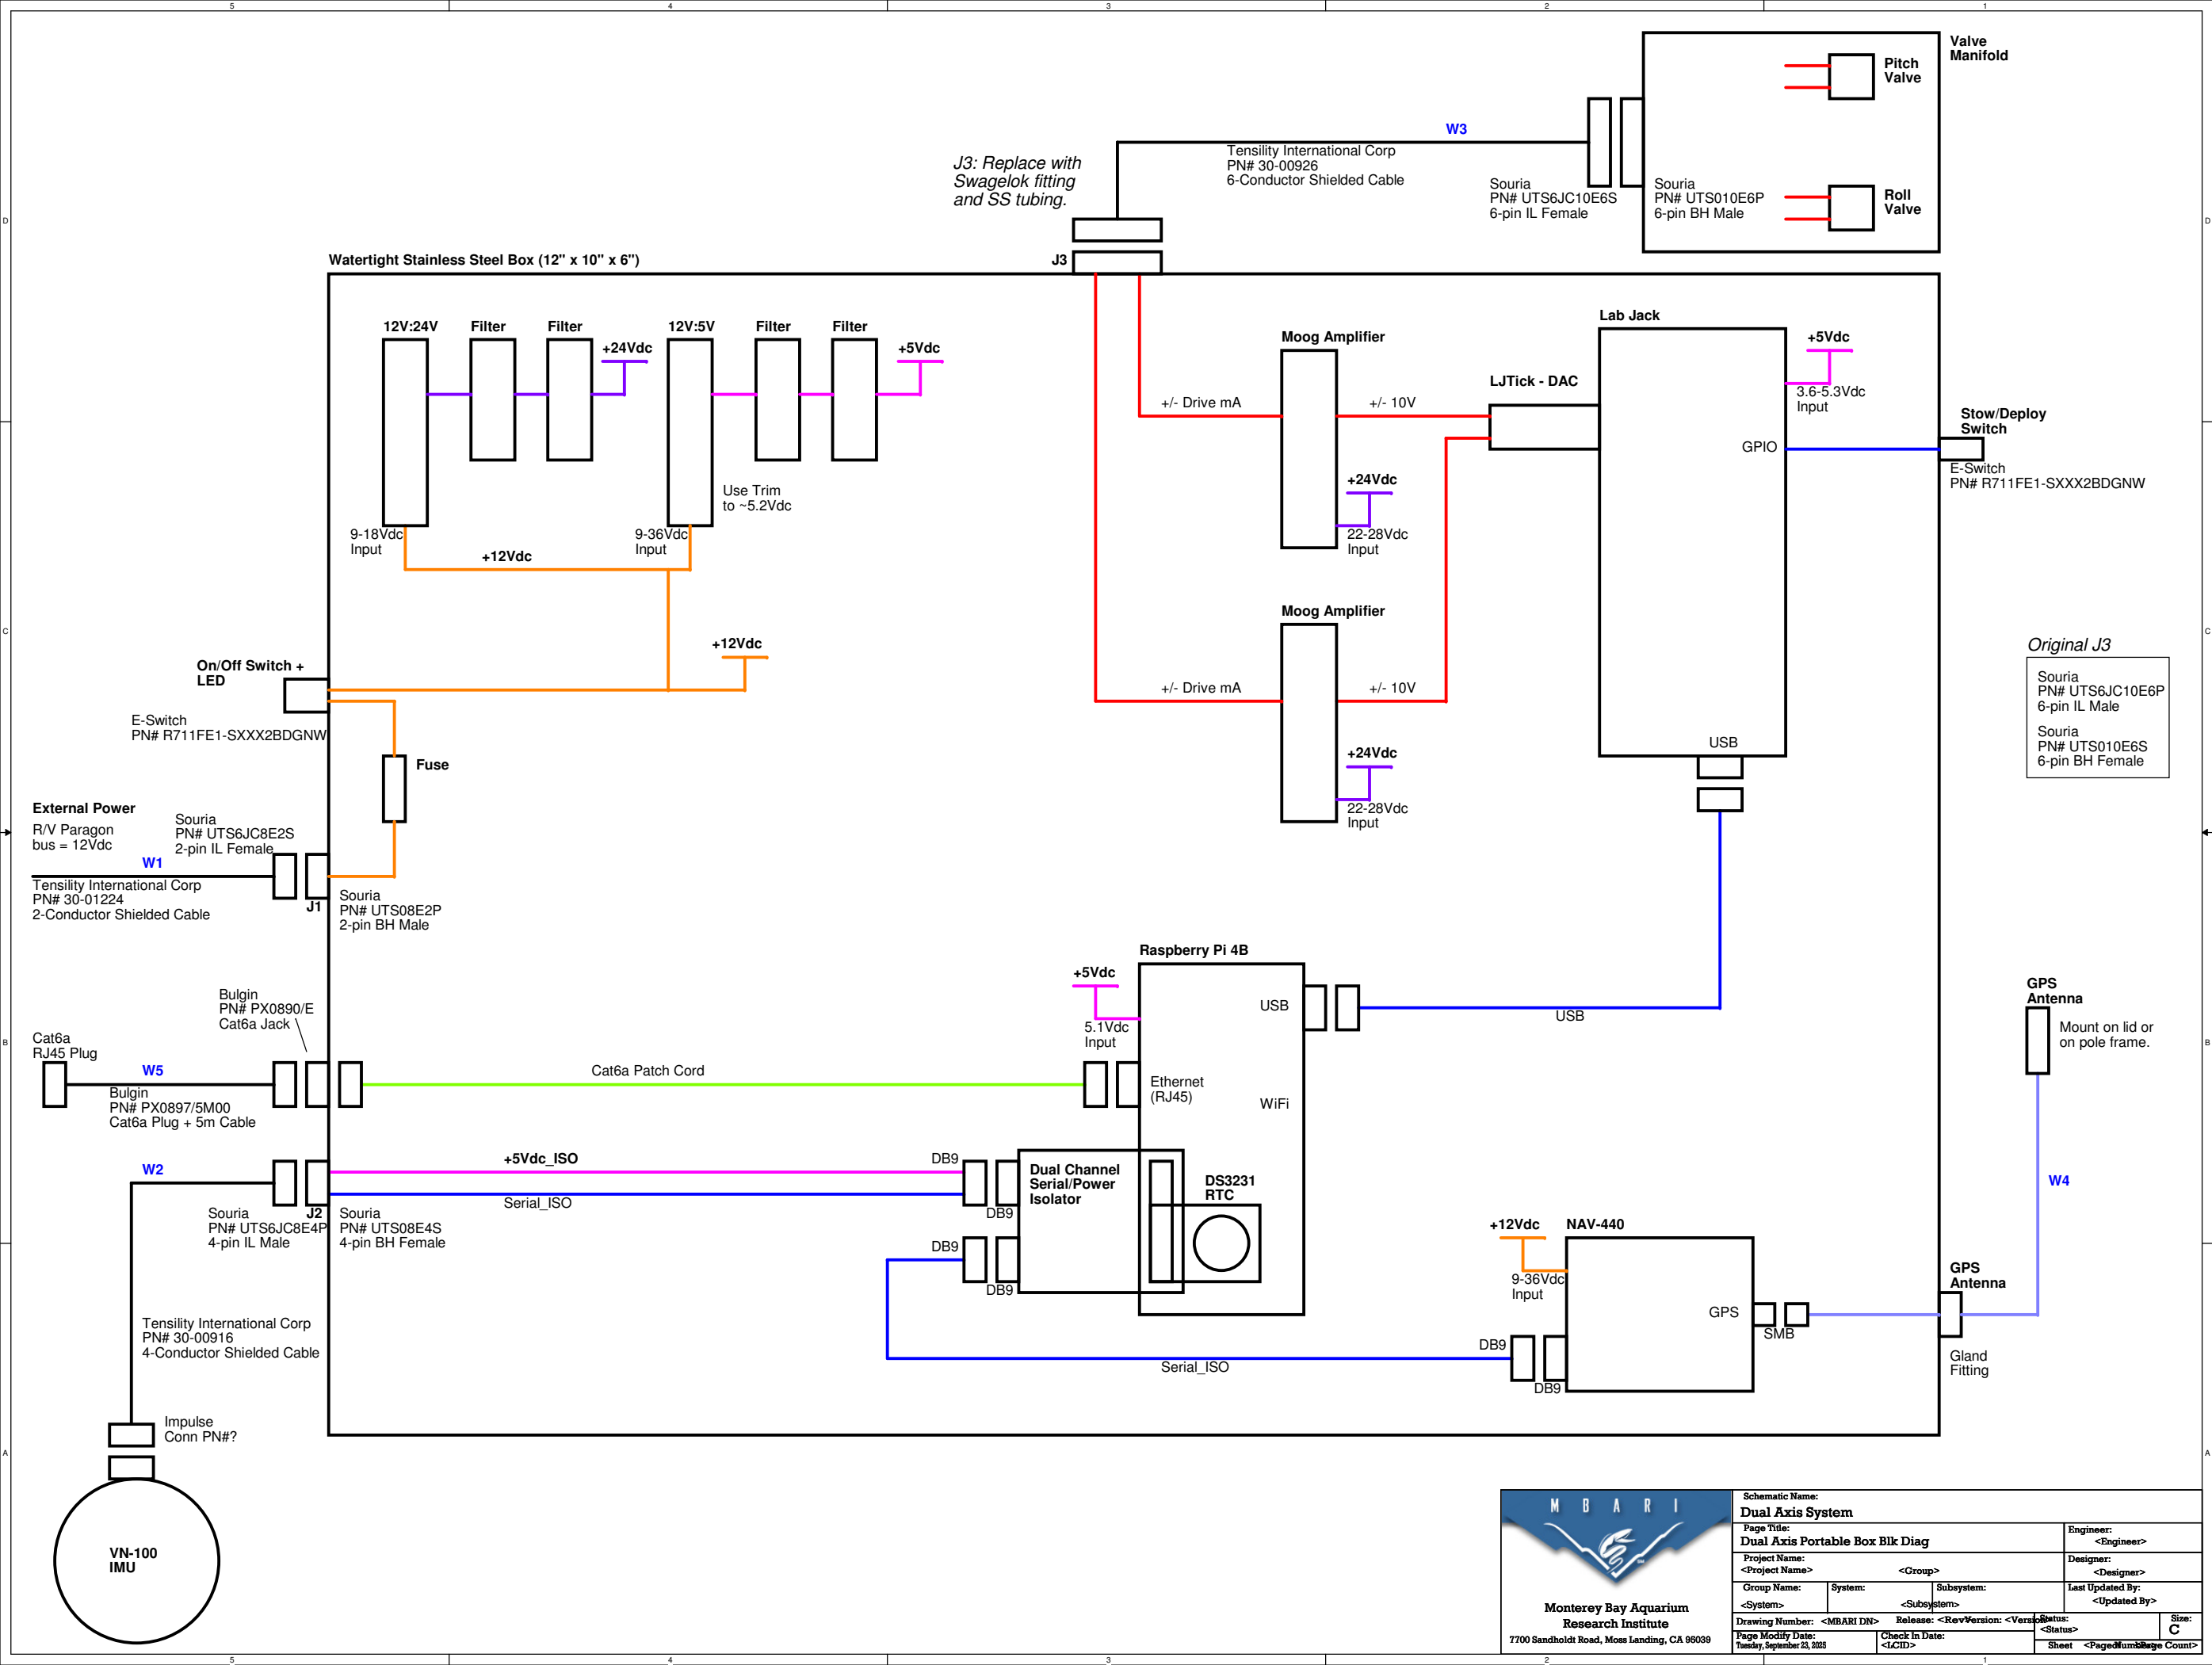

Schematic Name: Dual Axis System			
Page Title: Dual Axis Portable Box Blk Diag		Engineer: <Engineer>	
Project Name: <Project Name>		Designer: <Designer>	
Group Name: <System>	System: <Subsystem>	Subsystem: <Subsystem>	Last Updated By: <Updated By>
Drawing Number: Page Modify Date: Tuesday, September 23, 2025	Release: <LCID>	Version: <Version>	Status: <Status>
Sheet		Page Count	