

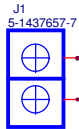
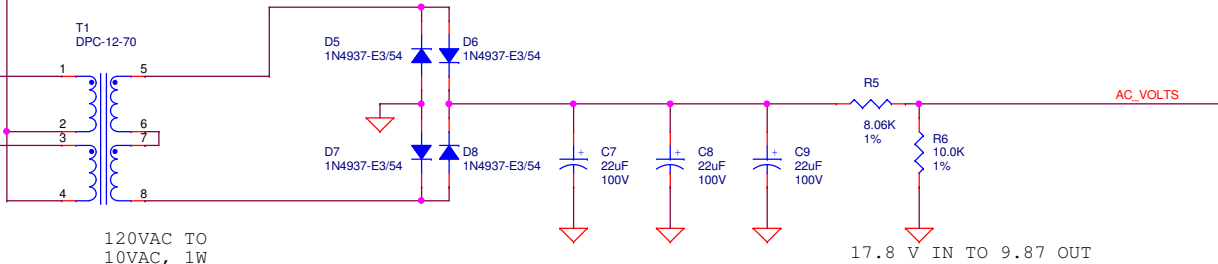
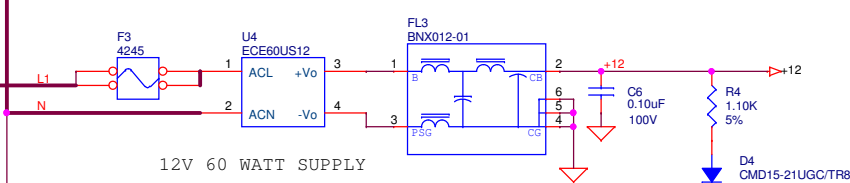
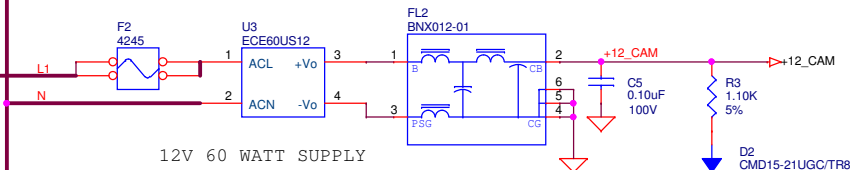


120 VAC from
Transformer

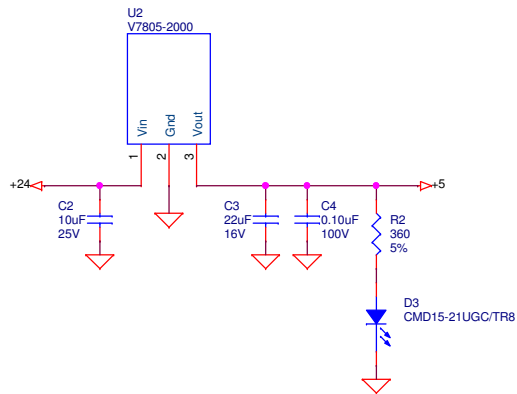

Change 24Vdc supply to
PN# ECE60US24 (60W)

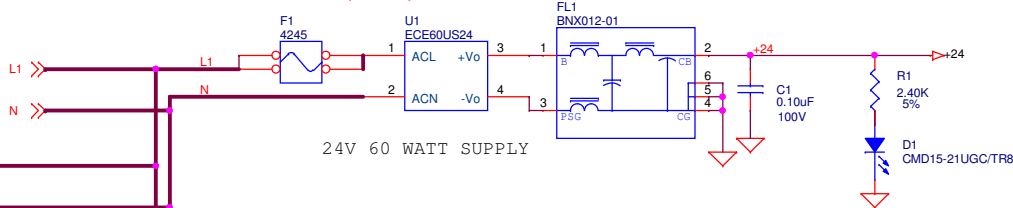


DC Power
to IO Board

Control Signals
IO Board

T1 Temp
Switch

Water
Sense

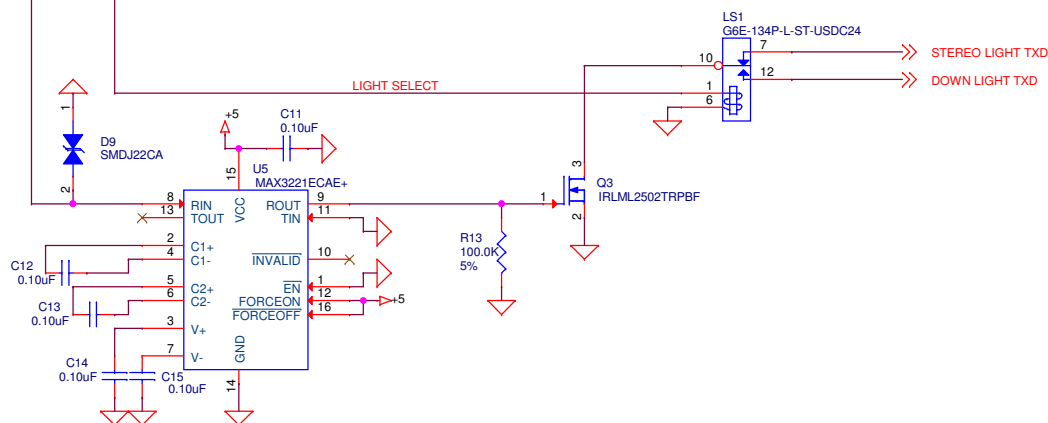

MONTEREY BAY AQUARIUM RESEARCH INSTITUTE
7700 SANDHOLDT ROAD
MOSS LANDING, CA 95039
(831) 775-1700 www.mbari.org
Copyright MBARI 2000

Title	BOSS 2018 Lander Power Board			Number
Size	Engineer	Layout	Filename	Rev
C	Chad Kacy	<Layout Eng.>	<Filename>	A
Date:	Wednesday, March 07, 2018	Sheet	1 of 2	