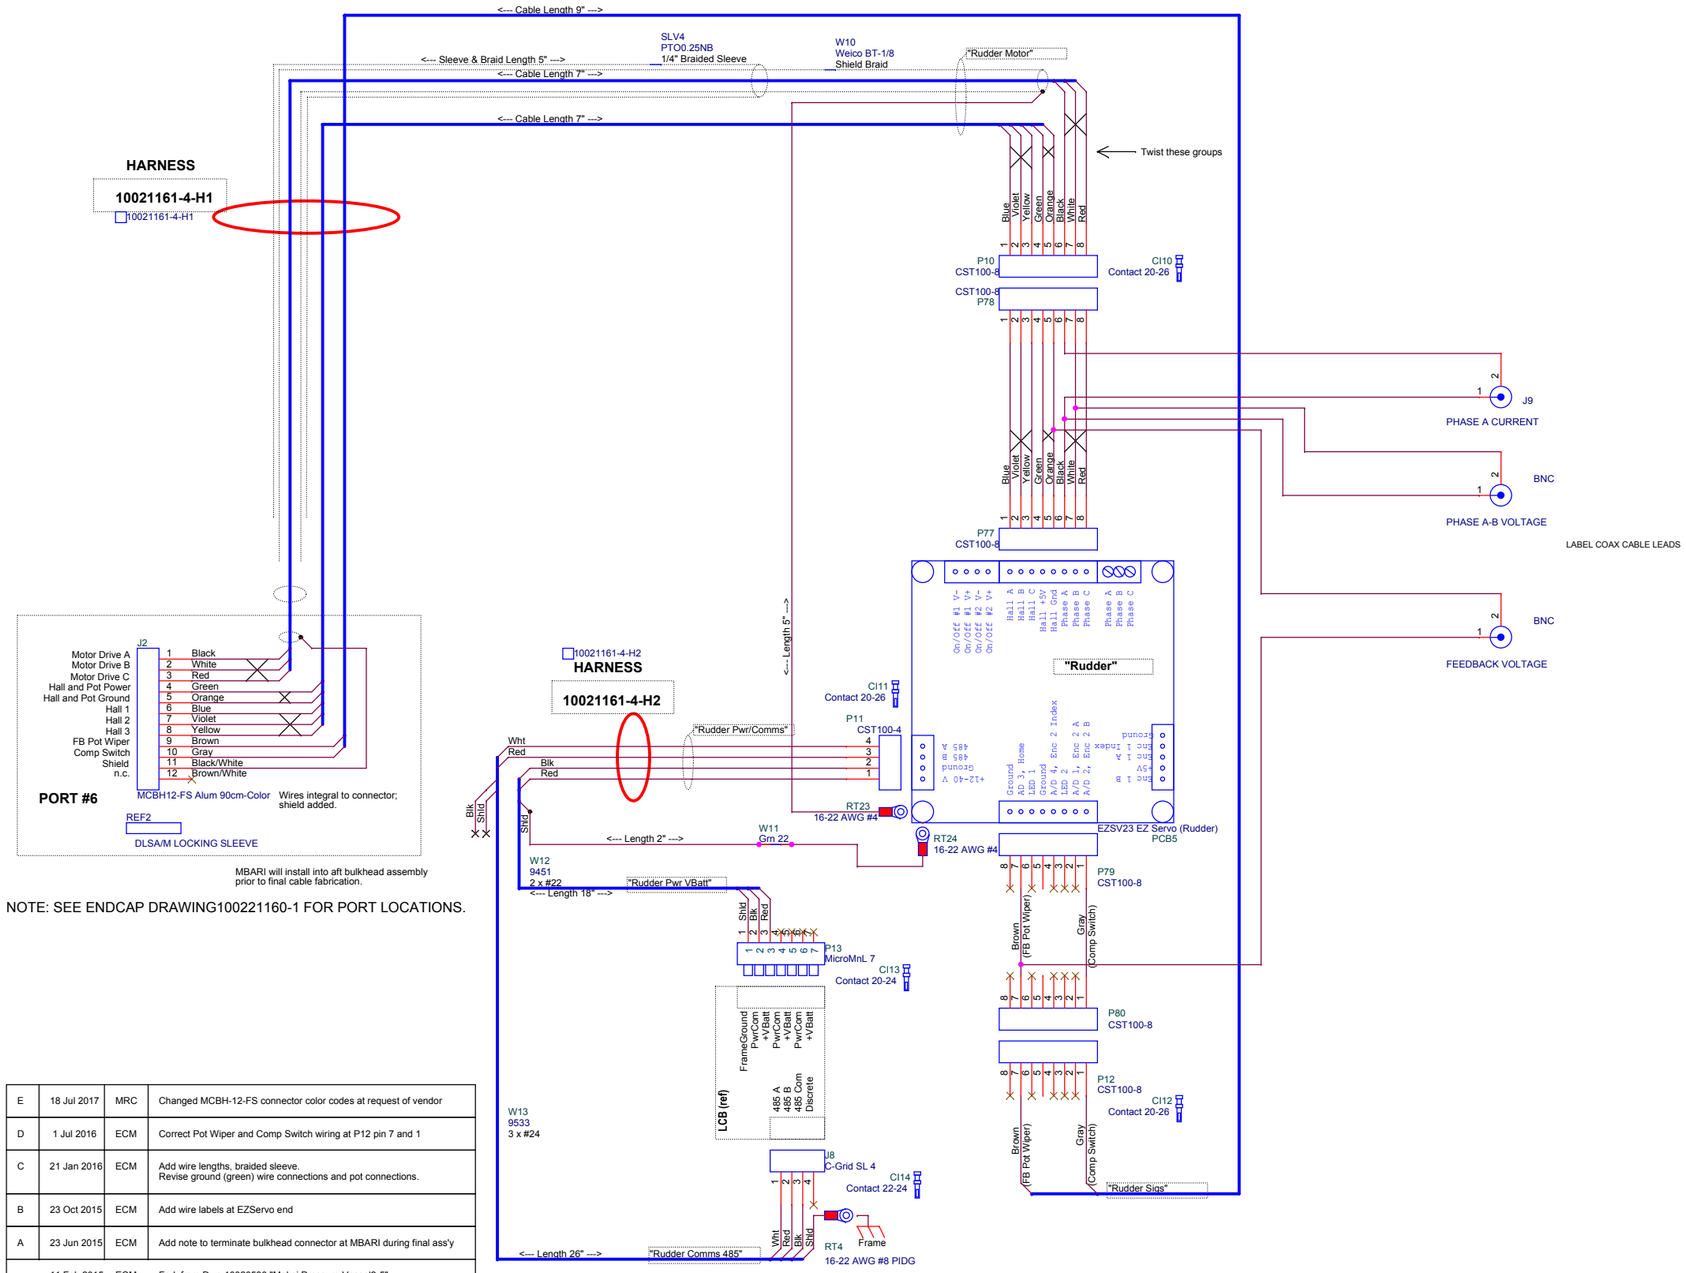

NOTE: SEE ENDCAP DRAWING100221160-1 FOR PORT LOCATIONS.

E	18 Jul 2017	MRC	Changed MCBH-12-FS connector color codes at request of vendor
D	1 Jul 2016	ECM	Correct Pot Wiper and Comp Switch wiring at P12 pin 7 and 1
C	21 Jan 2016	ECM	Add wire lengths, braided sleeve. Revise ground (green) wire connections and pot connections.
B	23 Oct 2015	ECM	Add wire labels at EZServo end
A	23 Jun 2015	ECM	Add note to terminate bulkhead connector at MBARI during final ass'y
--	11 Feb 2015	ECM	Fork from Dwg 10020580 "Makai Pressure Vessel2-5"

MONTEREY BAY AQUARIUM RESEARCH INSTITUTE
7700 SANDHOLDT ROAD
MOSS LANDING, CA 95039
PHONE (831) 775-1700 www.mbari.org

COPYRIGHT © 2016 MBARI
MAY NOT BE COPIED WITHOUT PERMISSION

M B A R I

Title
LRAUV RUDDER AND ELEVATOR MONITORING

Size	Engineer: Mark Chaffey EMAIL: chma@mbari.org (831) 775-1708	Number NA	Rev
C	Date: Tuesday, August 01, 2017	Filename <Filename>	Sheet 1 of 1	A