



Thruster Housing

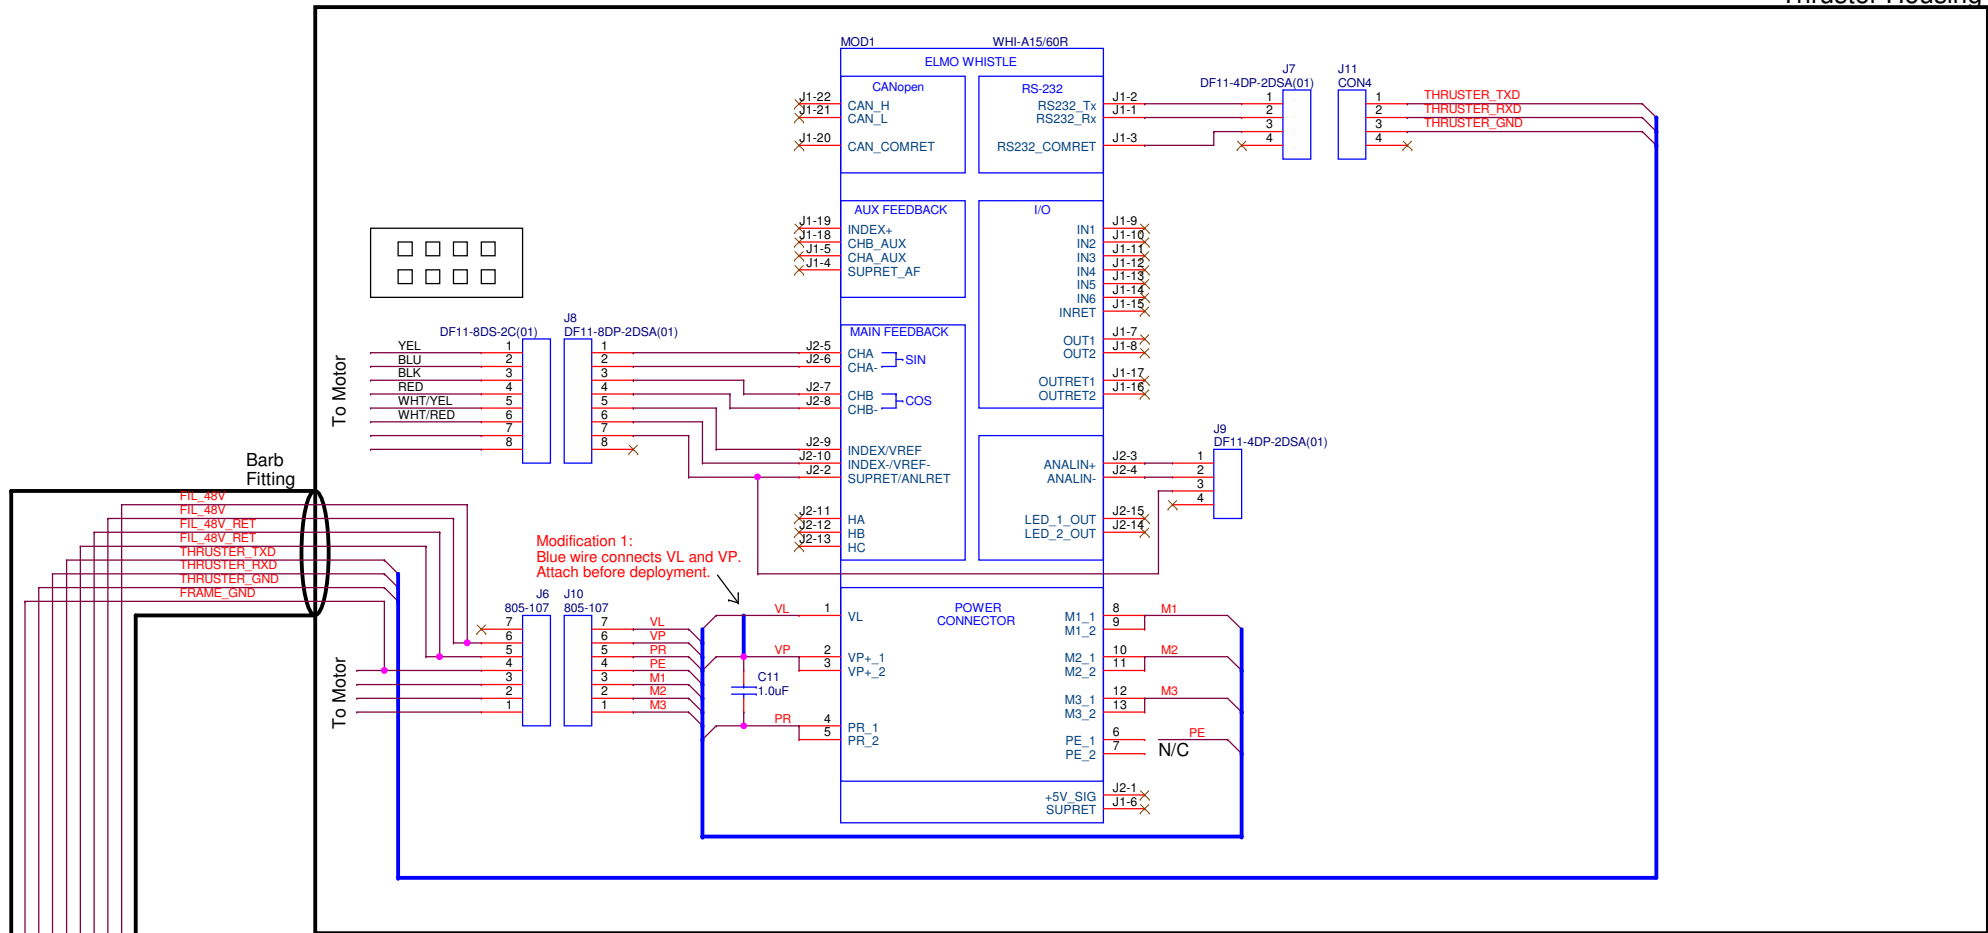

Thruster J-Box

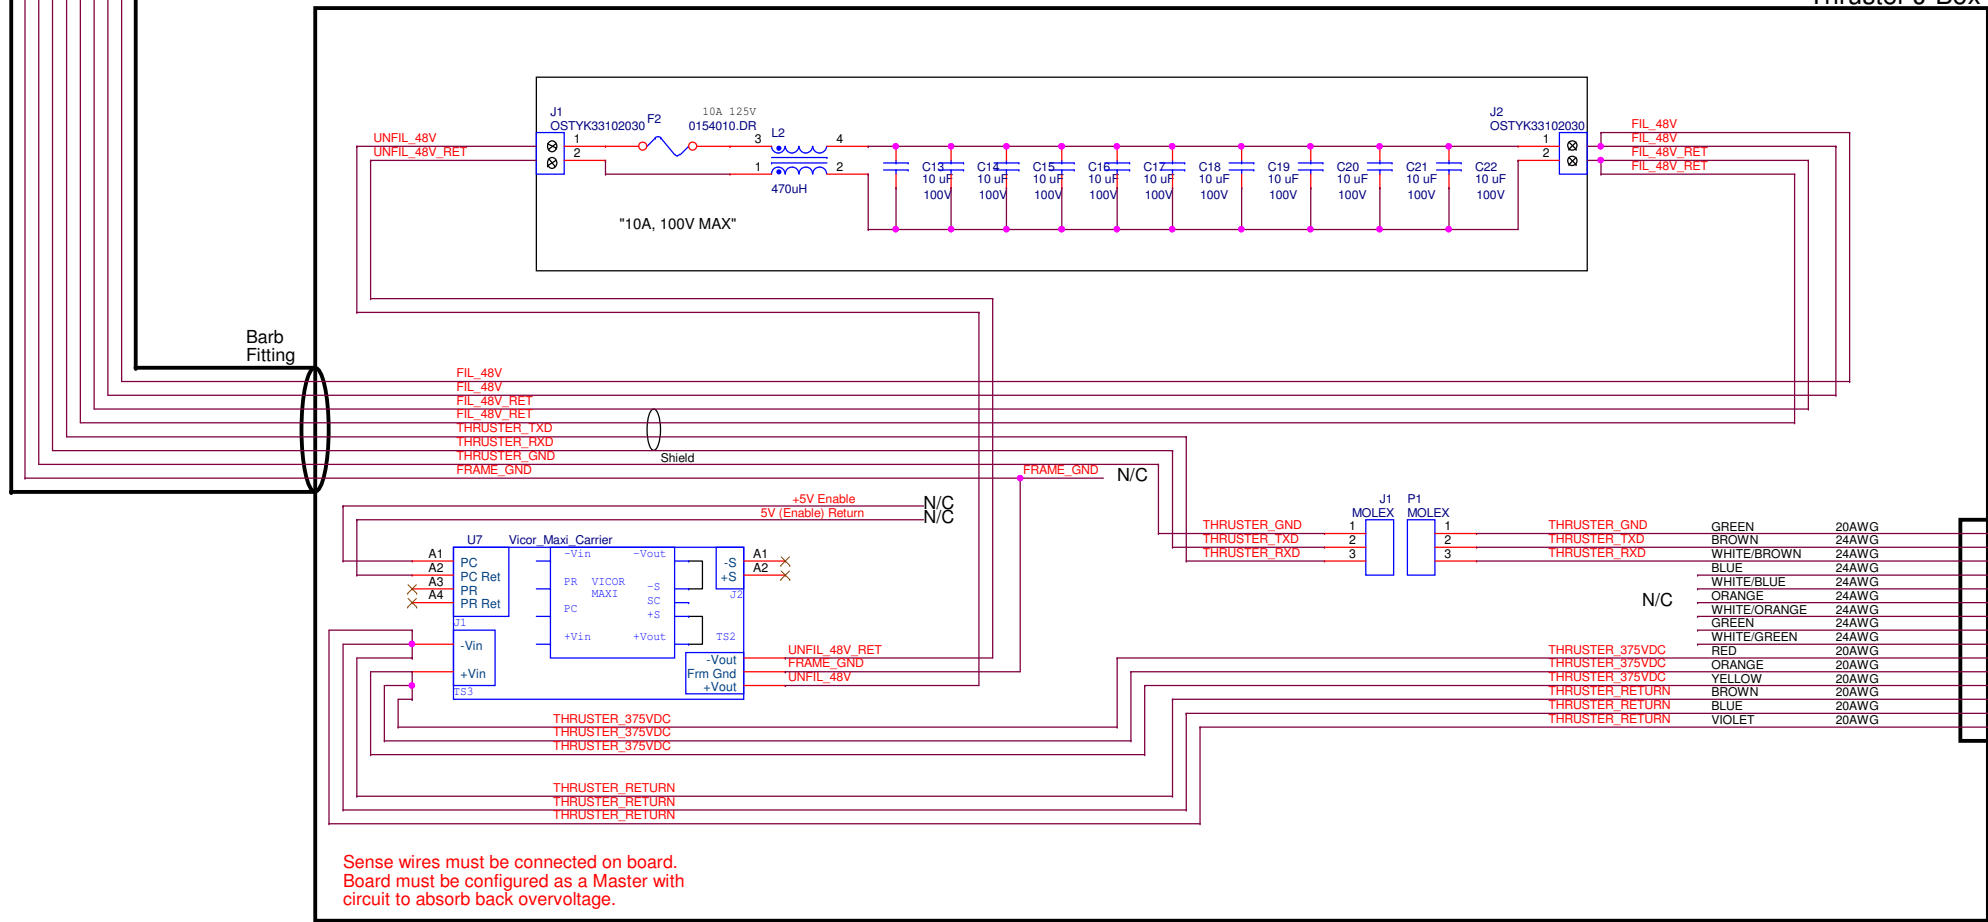

Gland
Fitting

Falmat PN# 022208-11FG
20AWG x10
TP 24AWG x4
Length = 20 meters
Green Jacket



Monterey Bay Aquarium Research Institute
7700 Sandholdt Road, Moss Landing, CA 95039

Thruster Wiring Diagram

Engineer	Size	Document Number	Layout File	Rev
Kecy	C	<Doc>	<Layout File>	<Rev>
Layout		Date: Thursday, February 27, 2020	Sheet 1 of 1	