


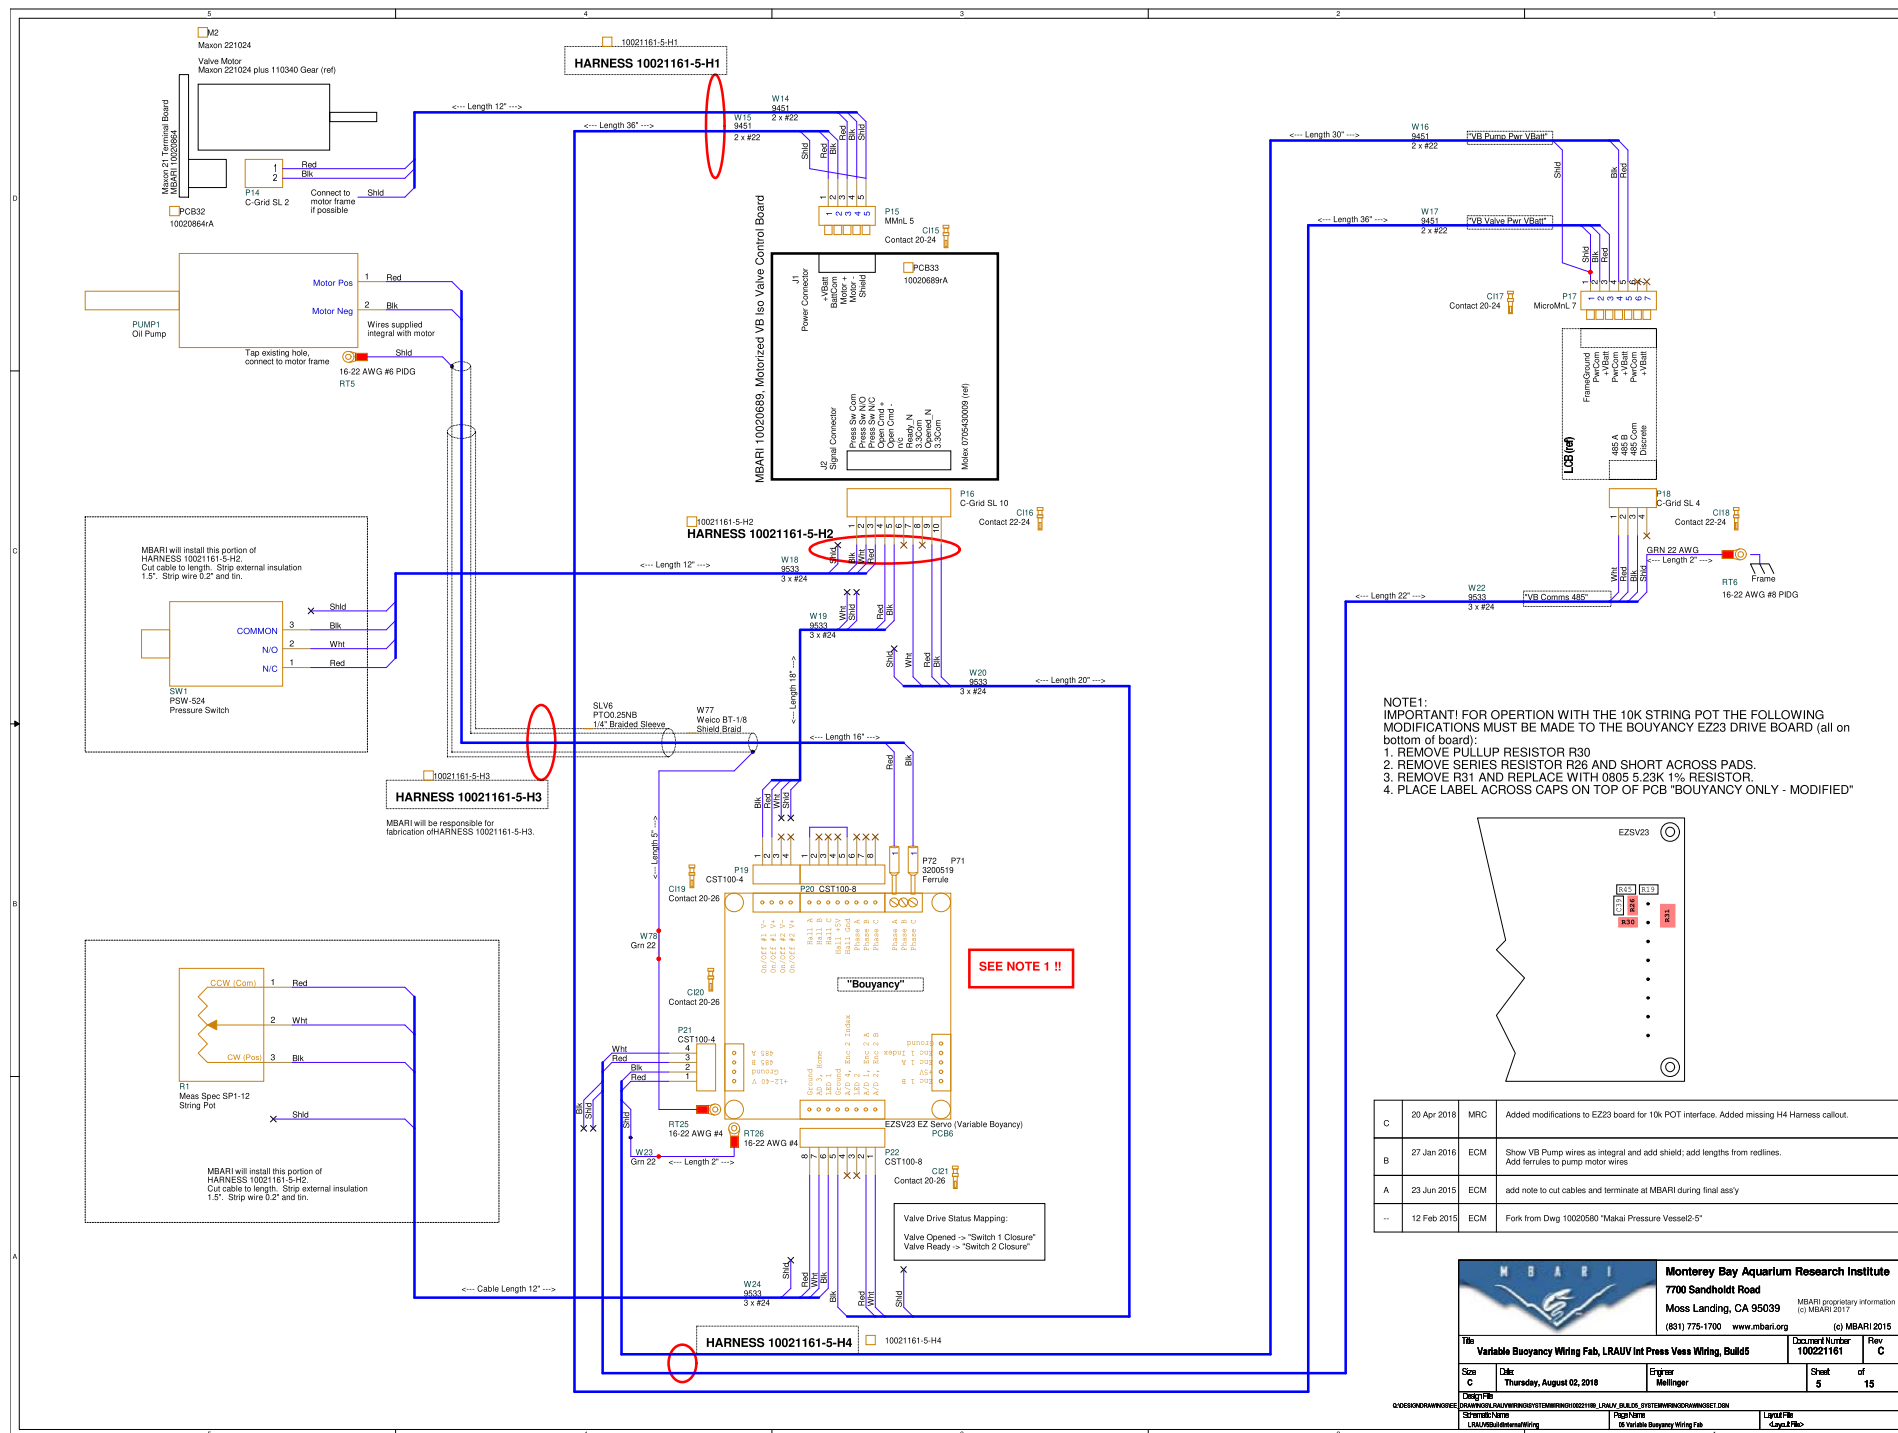

C	20 Apr 2018	MRC	Added modifications to EZ23 board for 10k POT interface. Added missing H4 Harness callout.
B	27 Jan 2016	ECM	Show VB Pump wires as integral and add shield; add lengths from redlines. Add ferrules to pump motor wires
A	23 Jun 2015	ECM	add note to cut cables and terminate at MBARI during final assy
--	12 Feb 2015	ECM	Fork from Dwg 10020590 "Makai Pressure Vessel-2"

[illegible]