



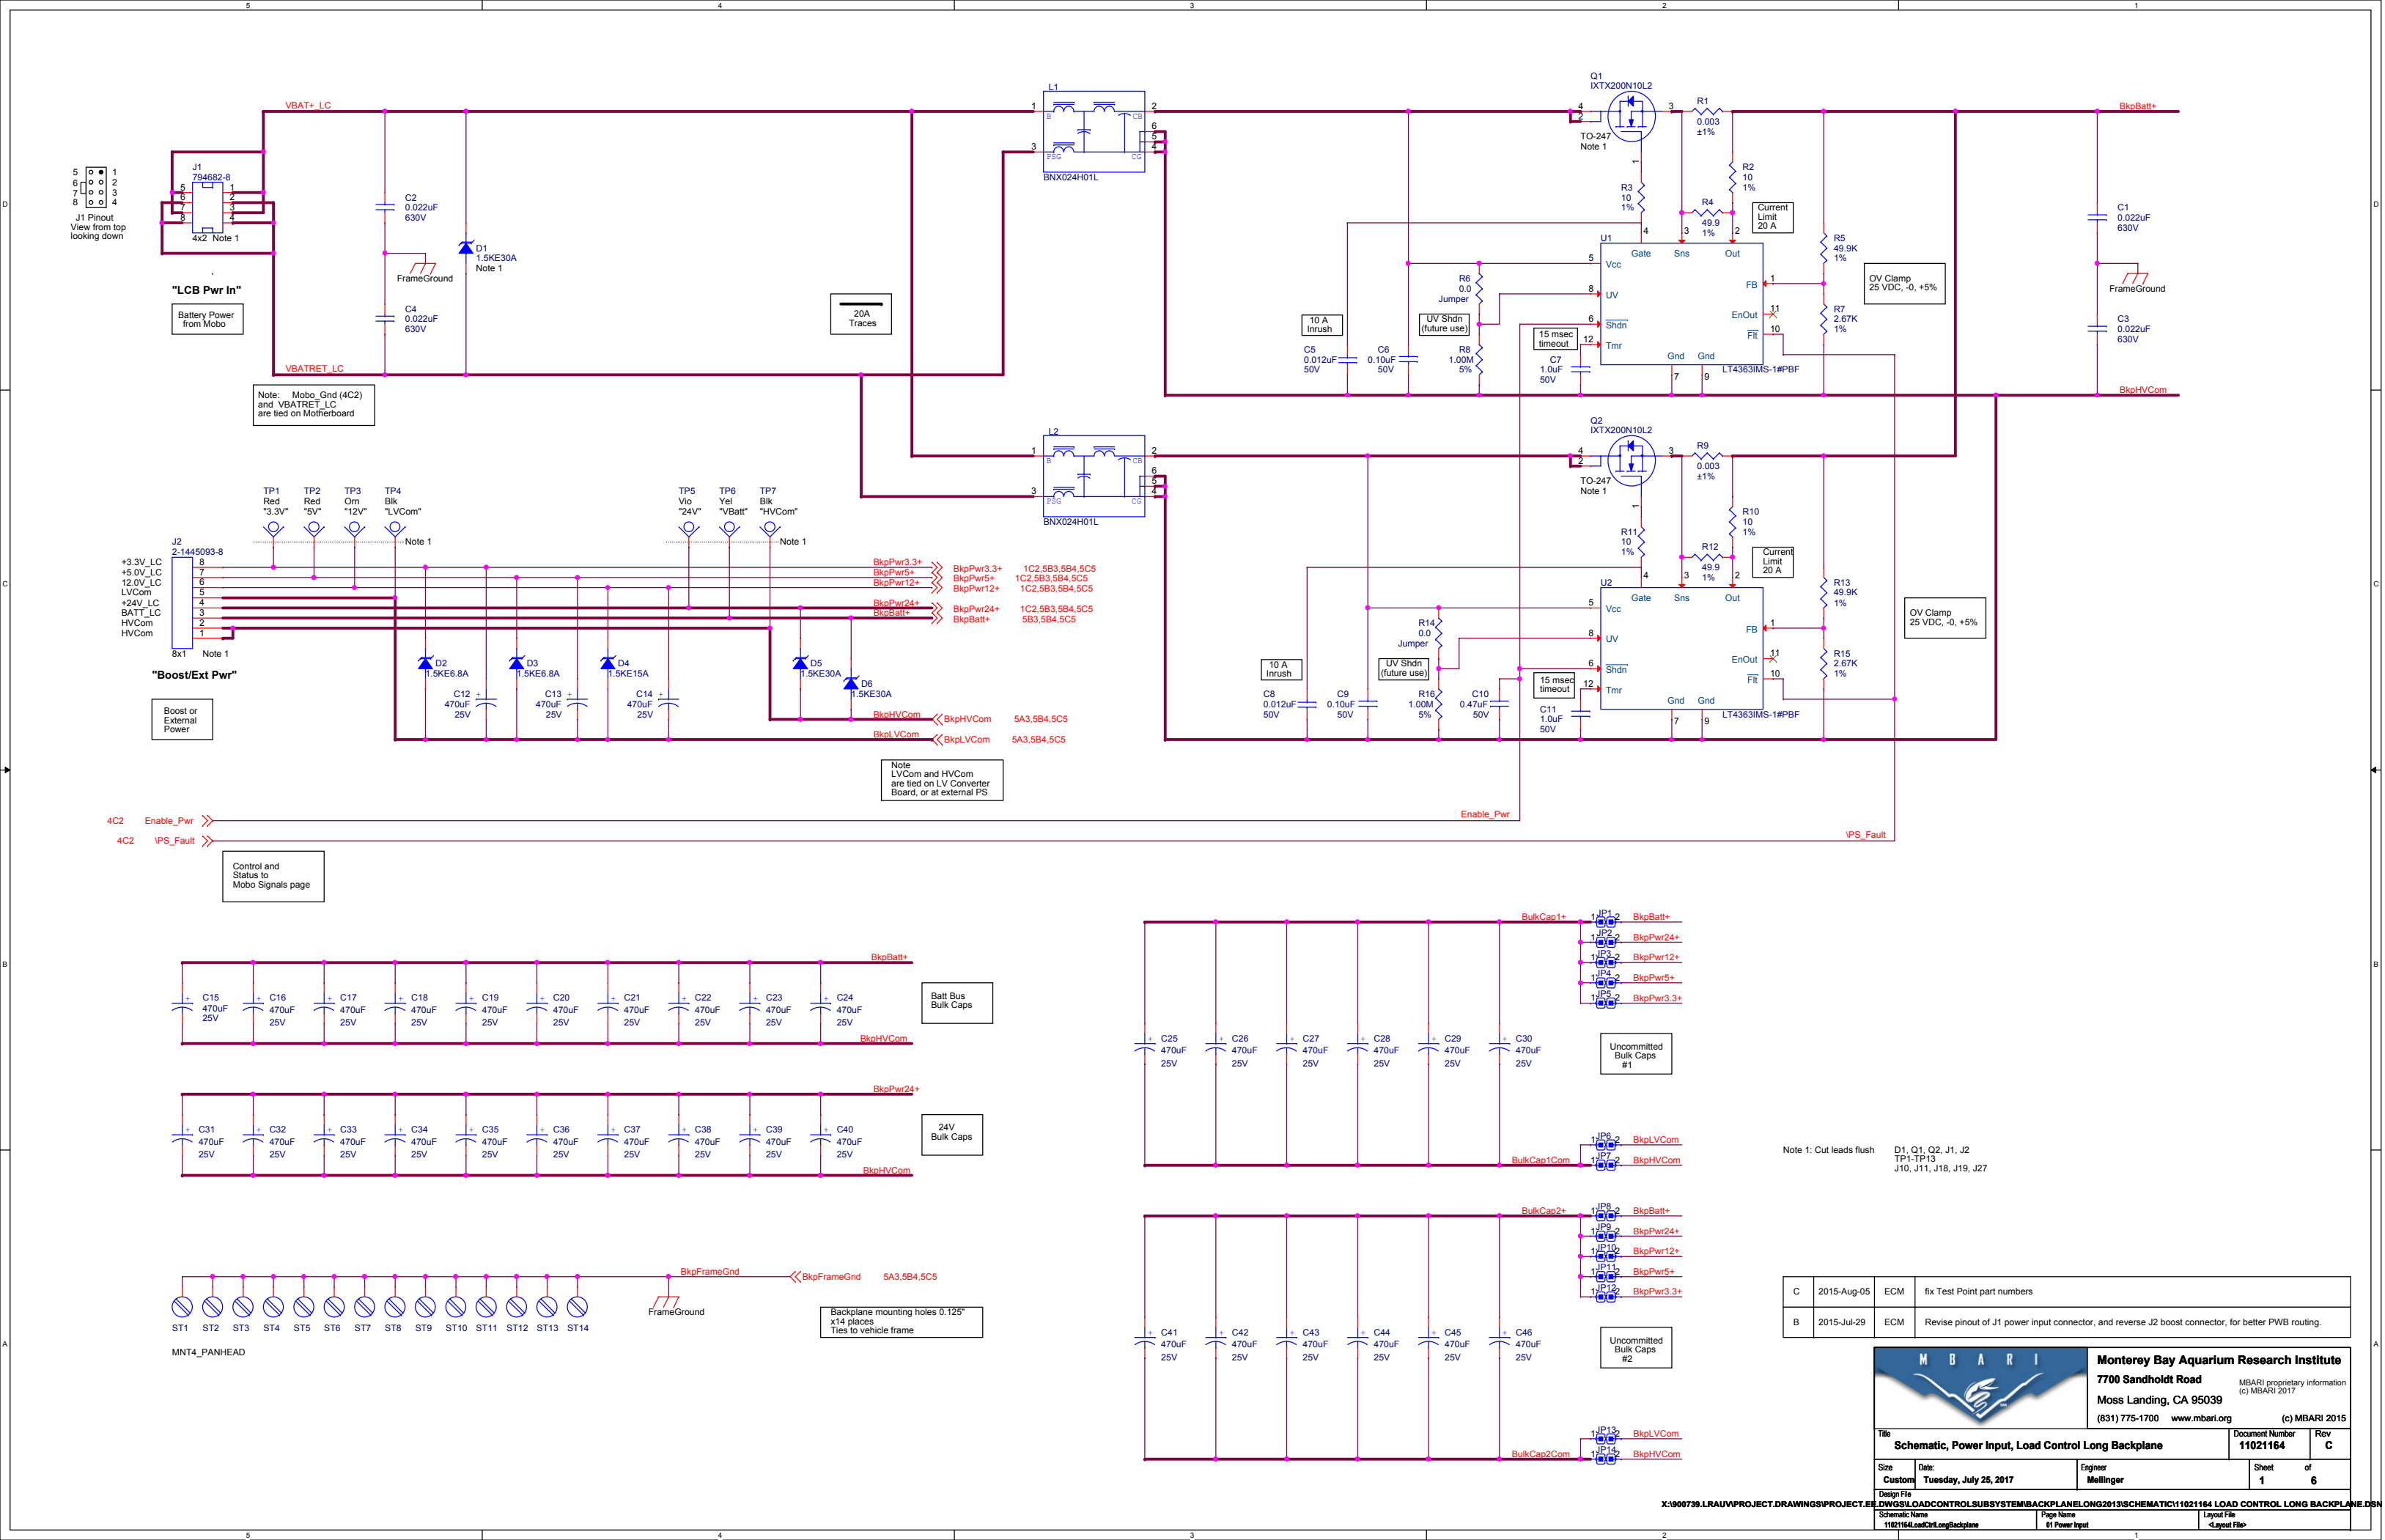

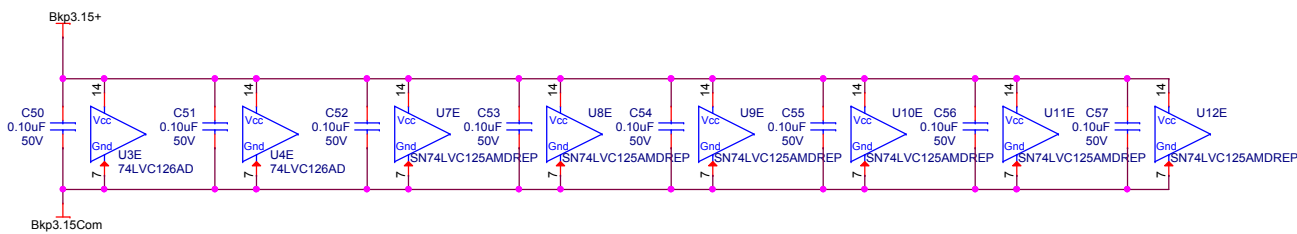

 Trace cuts
 Blue-wire connections

		Monterey Bay Aquarium Research Institute 7700 Sandholdt Road Moss Landing, CA 95039 (831) 775-1700 www.mbari.org		MBARI proprietary information (c) MBARI 2017	
Title Schematic, Mobo Signals, Load Control Long Backplane		Document Number 11021164		Rev E	
Size Custom		Date: Tuesday, July 25, 2017		Engineer Melling	
Design File		Sheet 2		of 6	
EE DWSGLOADCONTROLSUBSYSTEM\BACKPLANELONG2013\SCHEMATIC\11021164 LOAD CONTROL LONG BACKPLANE					
Schematic Name 11021164.scd\CtrlLongBackplane		Page Name 02 Mobo Signals		Layout File <Layout File>	

