


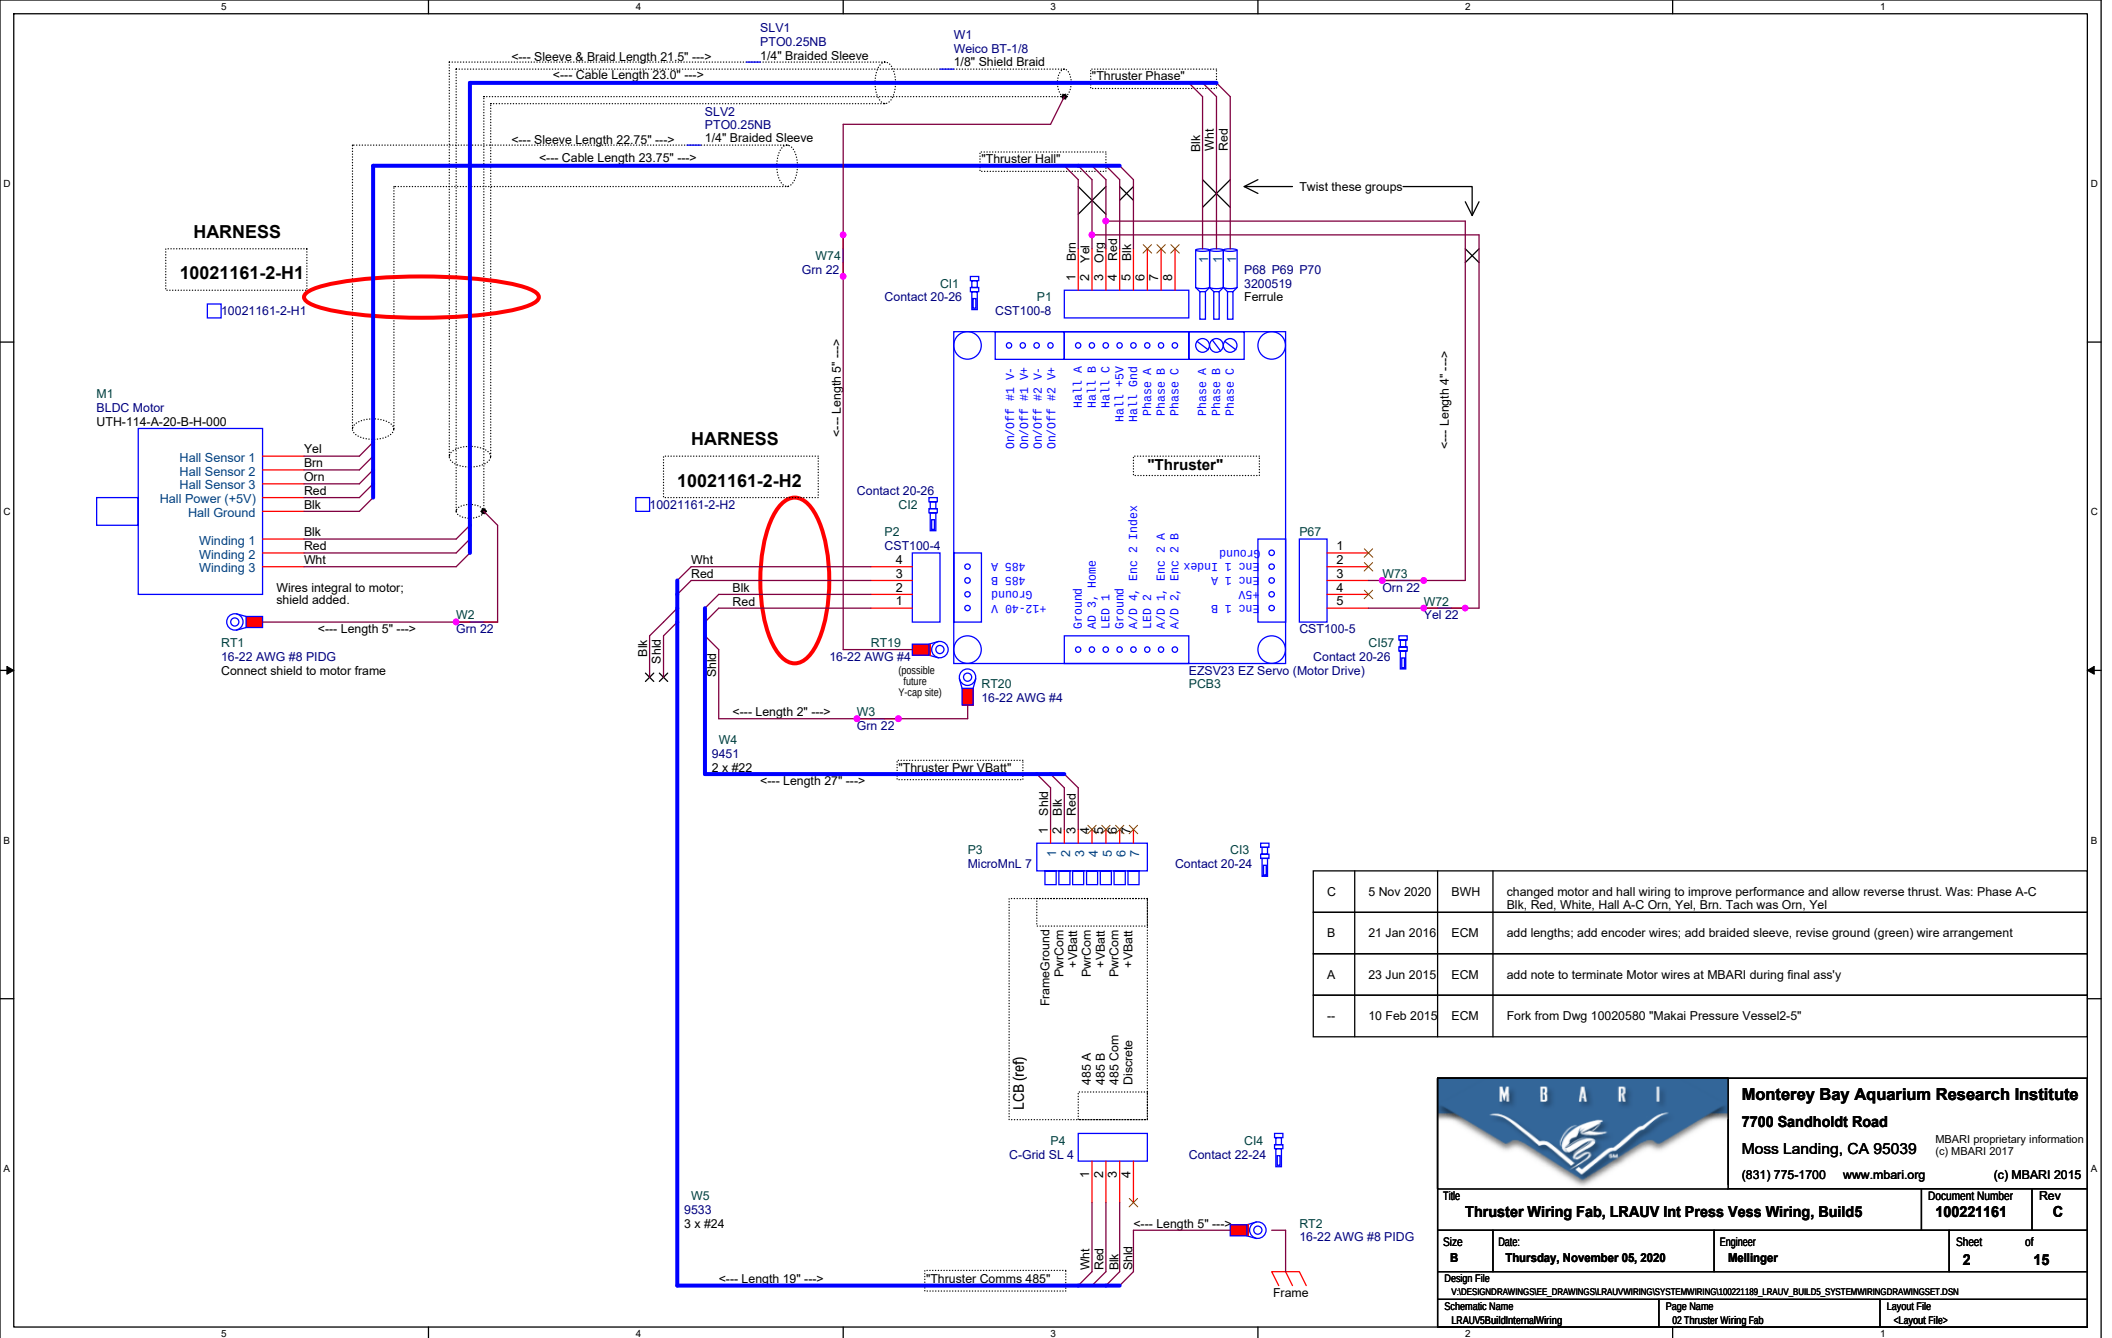

C	5 Nov 2020	BWH	changed motor and hall wiring to improve performance and allow reverse thrust. Was: Phase A-C Blk, Red, White, Hall A-C Orn, Yel, Brn. Tach was Orn, Yel
B	21 Jan 2016	ECM	add lengths; add encoder wires; add braided sleeve, revise ground (green) wire arrangement
A	23 Jun 2015	ECM	add note to terminate Motor wires at MBARI during final ass'y
--	10 Feb 2015	ECM	Fork from Dwg 10020580 "Makai Pressure Vessel2-5"



Monterey Bay Aquarium Research Institute

7700 Sandholdt Road

Moss Landing, CA 95039

(831) 775-1700 www.mbari.org

MBARI proprietary information
(c) MBARI 2017

(c) MBARI 2015

Title		Document Number		Rev	
Thruster Wiring Fab, LRAUV Int Press Vess Wiring, Build5		100221161		C	
Size	Date:	Engineer	Sheet	of	
B	Thursday, November 05, 2020	Mellingner	2	15	
Design File					
VIDESIGNDRAWINGS\EE_DRAWINGS\LRAUV\WIRING\SYSTEMWIRING\100221189_LRAUV_BUILD5_SYSTEMWIRINGDRAWINGSET.DSN					
Schematic Name		Page Name	Layout File		
LRAUV5BuildInternalWiring		02 Thruster Wiring Fab	<Layout File>		