



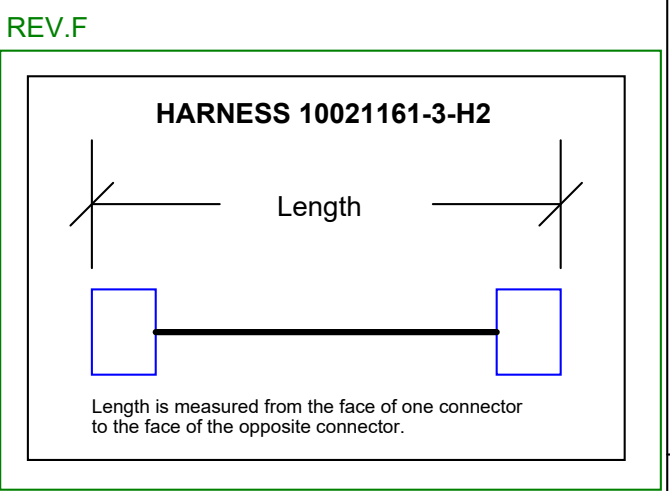

F	24 Jan 2018	PC	Changed LCB wire lengths. PWR: 20" to 13" ; COMS: 27" to 44".
E	18 Jul 2017	MRC	Changed MCBH-12-FS connector color codes at request of vendor
D	1 Jul 2016	ECM	Correct Pot Wiper wiring at P7 pin 7
C	21 Jan 2016	ECM	Add wire lengths, braided sleeve. Revise ground (green) wire connections and pot connections.
B	23 Oct 2015	ECM	Add wire labels at EZServo end
A	23 Jun 2015	ECM	Add note to terminate bulkhead connector at MBARI during final ass'y
--	11 Feb 2015	ECM	Fork from Dwg 10020580 "Makai Pressure Vessel2-5"

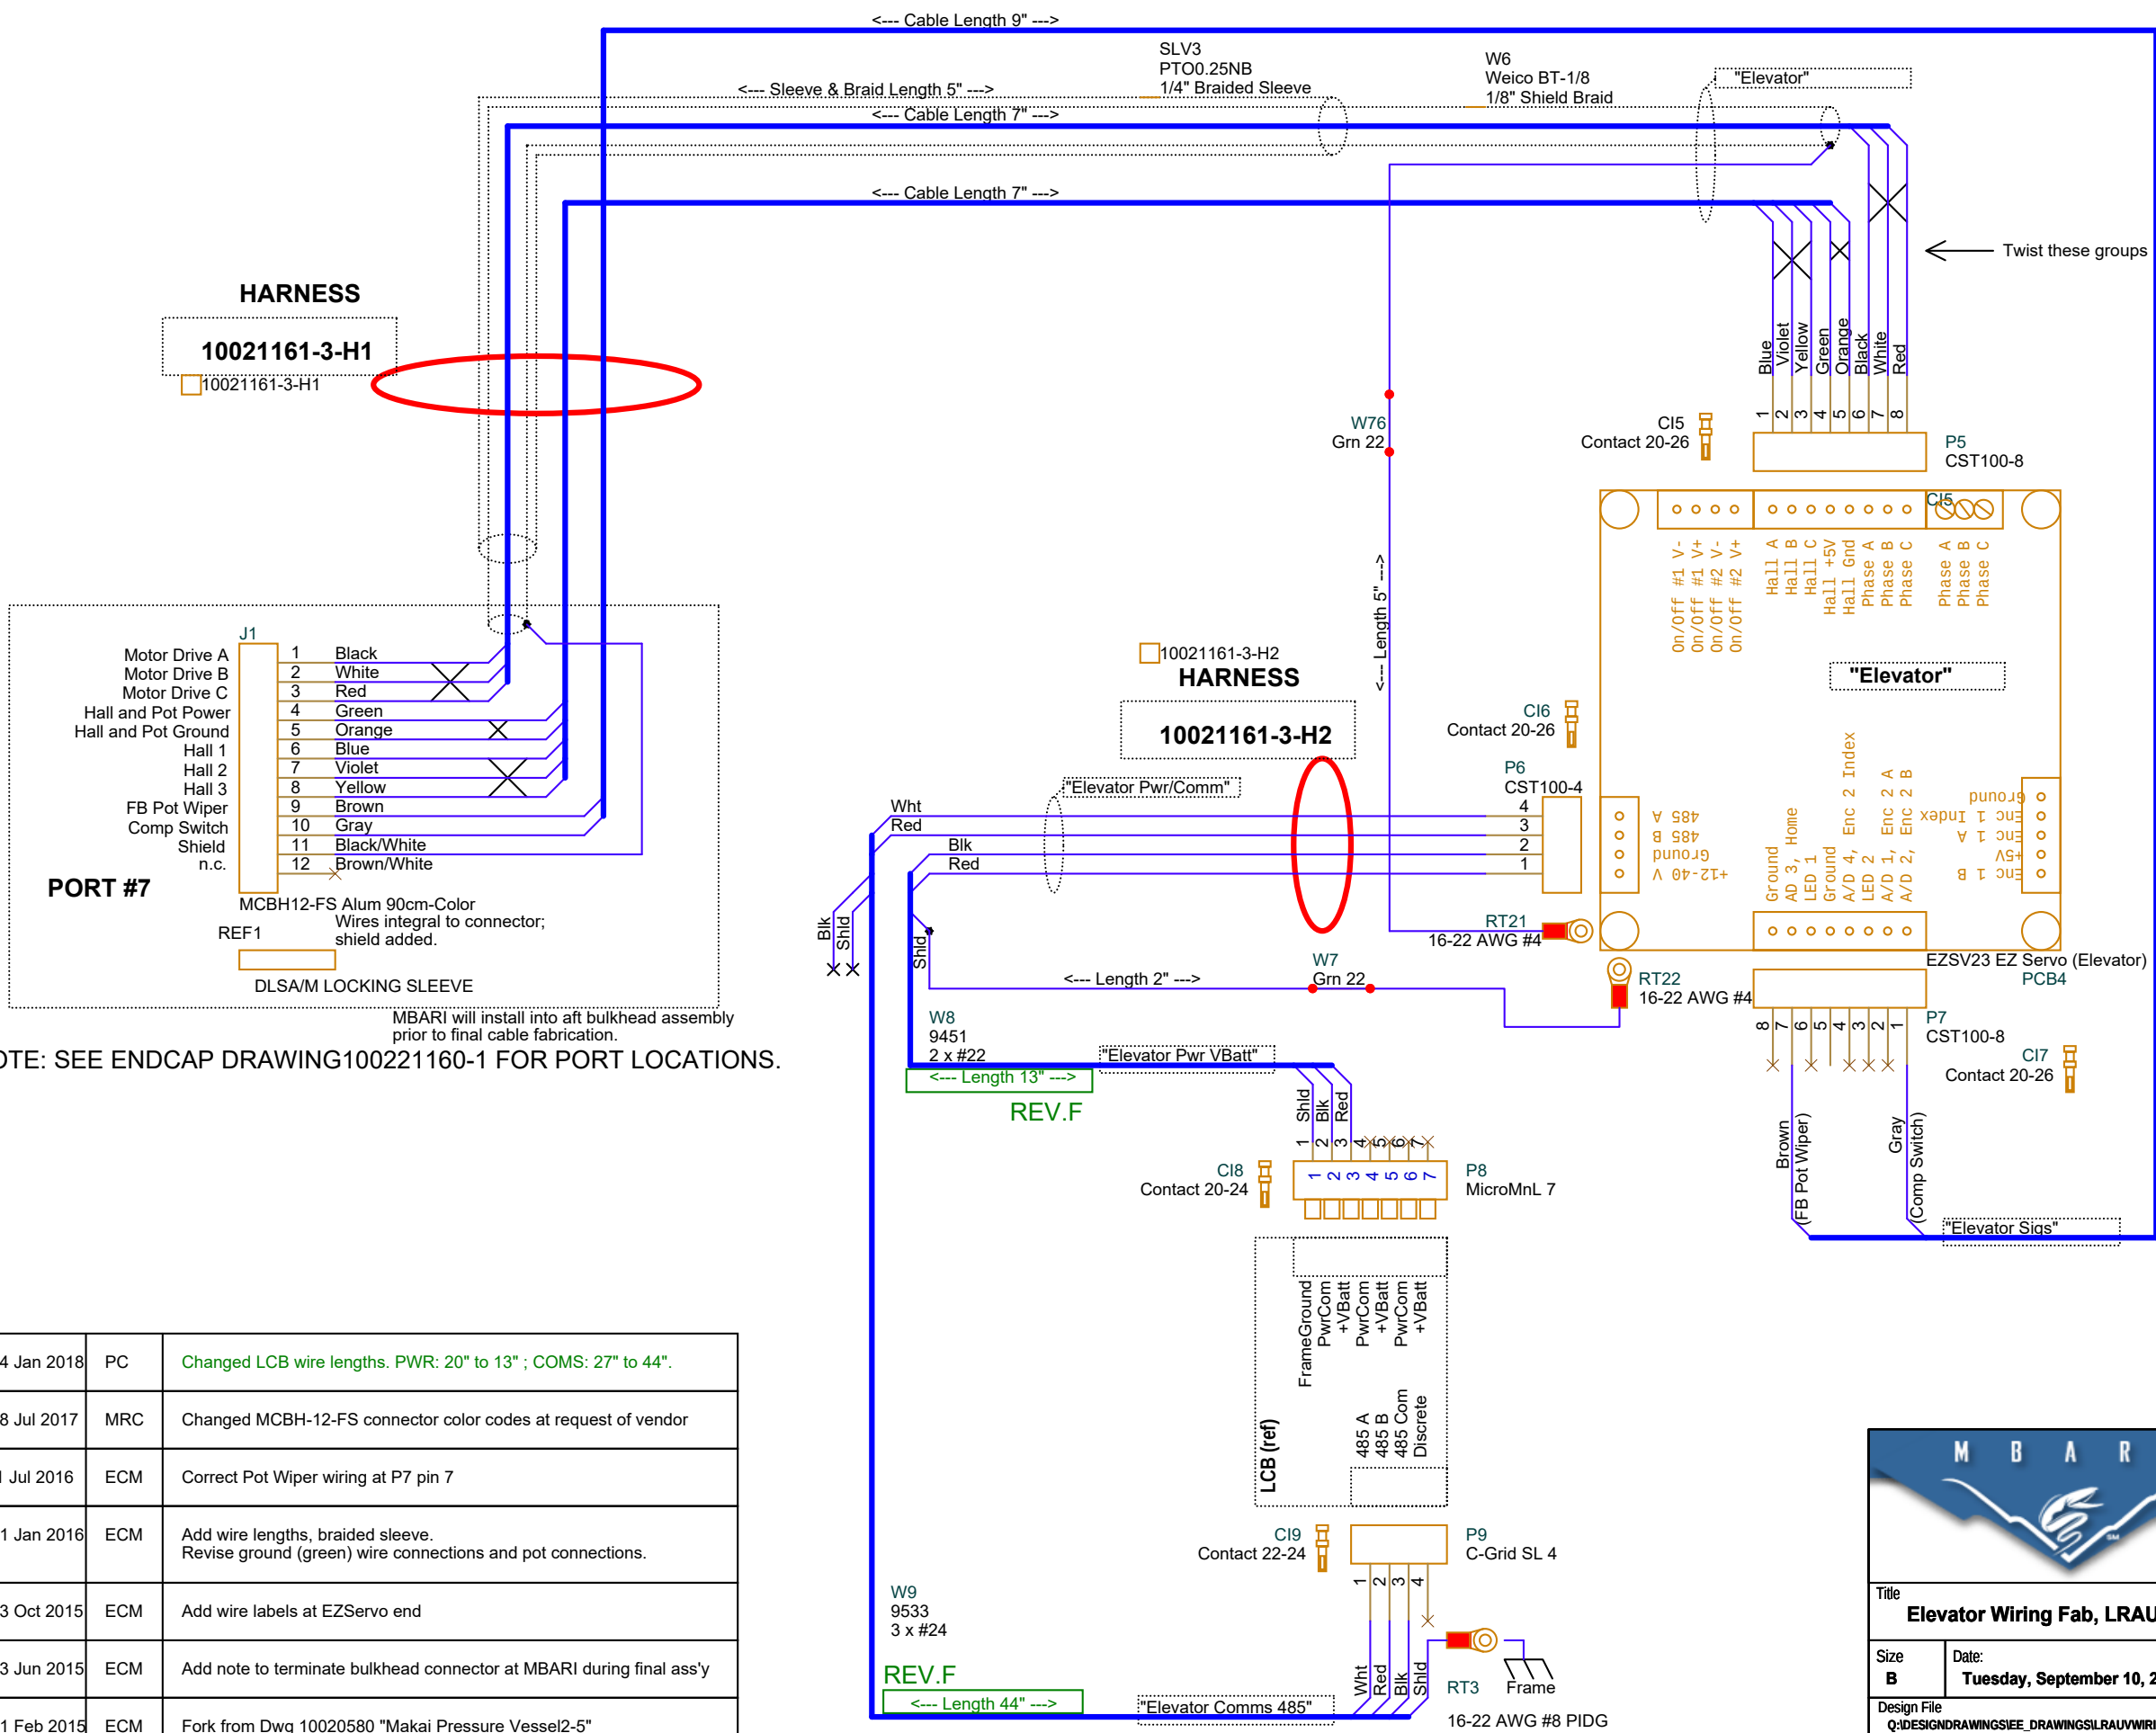

Monterey Bay Aquarium Research Institute
7700 Sandholdt Road
Moss Landing, CA 95039
(831) 775-1700 www.mbari.org

MBARI proprietary information
(c) MBARI 2017

(c) MBARI 2015

Title Elevator Wiring Fab, LRAUV Int Press Vess Wiring, Build5		Document Number 100221161	Rev F
Size B	Date: Tuesday, September 10, 2024	Engineer Mellinger	Sheet 3 of 15
Design File Q:\DESIGN\DRAWINGS\IEE_DRAWINGS\LRAUV\WIRING\SYSTEMWIRING\100221161_LRAUV_BUILD5_SYSTEMWIRING\DRAWINGSET.DSN			
Schematic Name 10021161 BuildInternalWiring		Page Name 03 Elevator Wiring Fab	Layout File <Layout File>