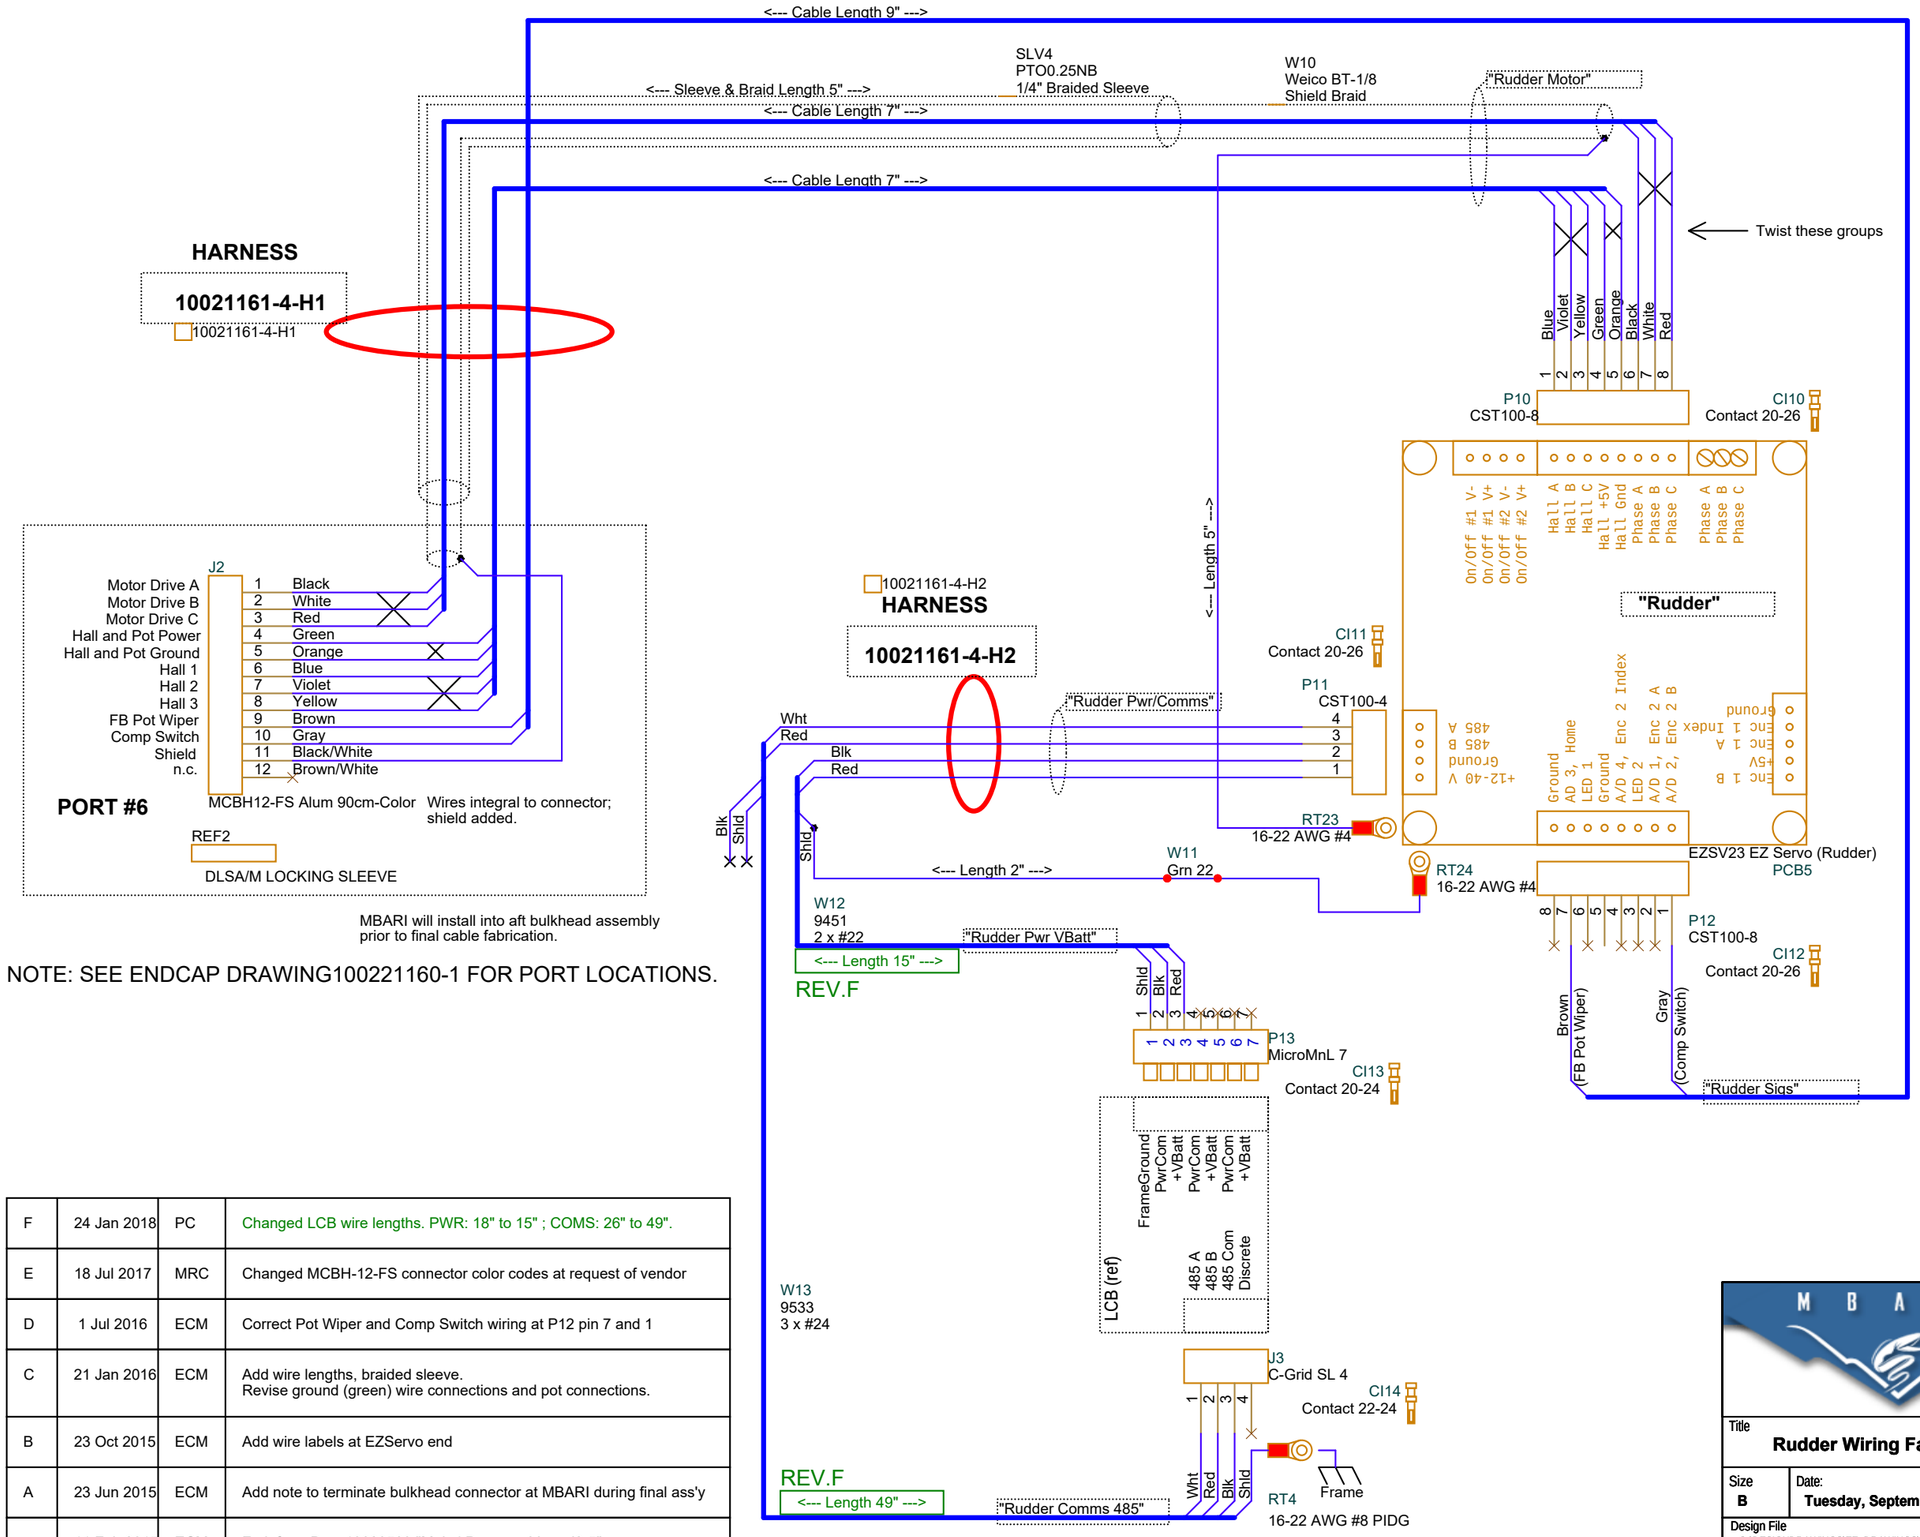

REV.F

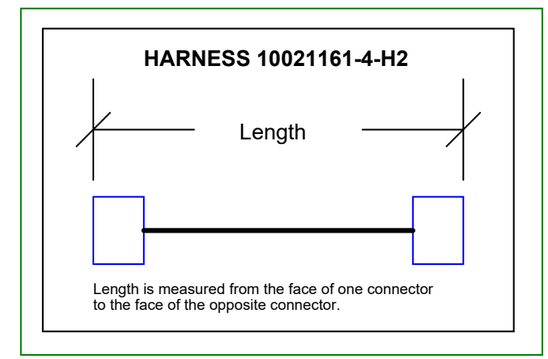

NOTE: SEE ENDCAP DRAWING100221160-1 FOR PORT LOCATIONS.

F	24 Jan 2018	PC	Changed LCB wire lengths. PWR: 18" to 15" ; COMS: 26" to 49".
E	18 Jul 2017	MRC	Changed MCBH-12-FS connector color codes at request of vendor
D	1 Jul 2016	ECM	Correct Pot Wiper and Comp Switch wiring at P12 pin 7 and 1
C	21 Jan 2016	ECM	Add wire lengths, braided sleeve. Revise ground (green) wire connections and pot connections.
B	23 Oct 2015	ECM	Add wire labels at EZServo end
A	23 Jun 2015	ECM	Add note to terminate bulkhead connector at MBARI during final ass'y
--	11 Feb 2015	ECM	Fork from Dwg 10020580 "Makai Pressure Vessel2-5"

Monterey Bay Aquarium Research Institute
7700 Sandholdt Road
Moss Landing, CA 95039
(831) 775-1700 www.mbari.org

MBARI proprietary information
(c) MBARI 2017
(c) MBARI 2015

Title: **Rudder Wiring Fab, LRAUV Int Press Vess Wiring, Build5**		Document Number: **100221161-4-D**	Rev: **F**
Size: **B**	Date: **Tuesday, September 10, 2024**	Engineer: **Mellinger**	Sheet **4** of **15**
Design File: Q:\DESIGNDRAWINGS\EE_DRAWINGS\LRAUVWIRING\SYSTEMWIRING\100221189_LRAUV_BUILD5_SYSTEMWIRINGDRAWINGSET.DSN			
Schematic Name: 10021161 BuildInternalWiring	Page Name: 04 Rudder Wiring Fab	Layout File: <Layout File>	