



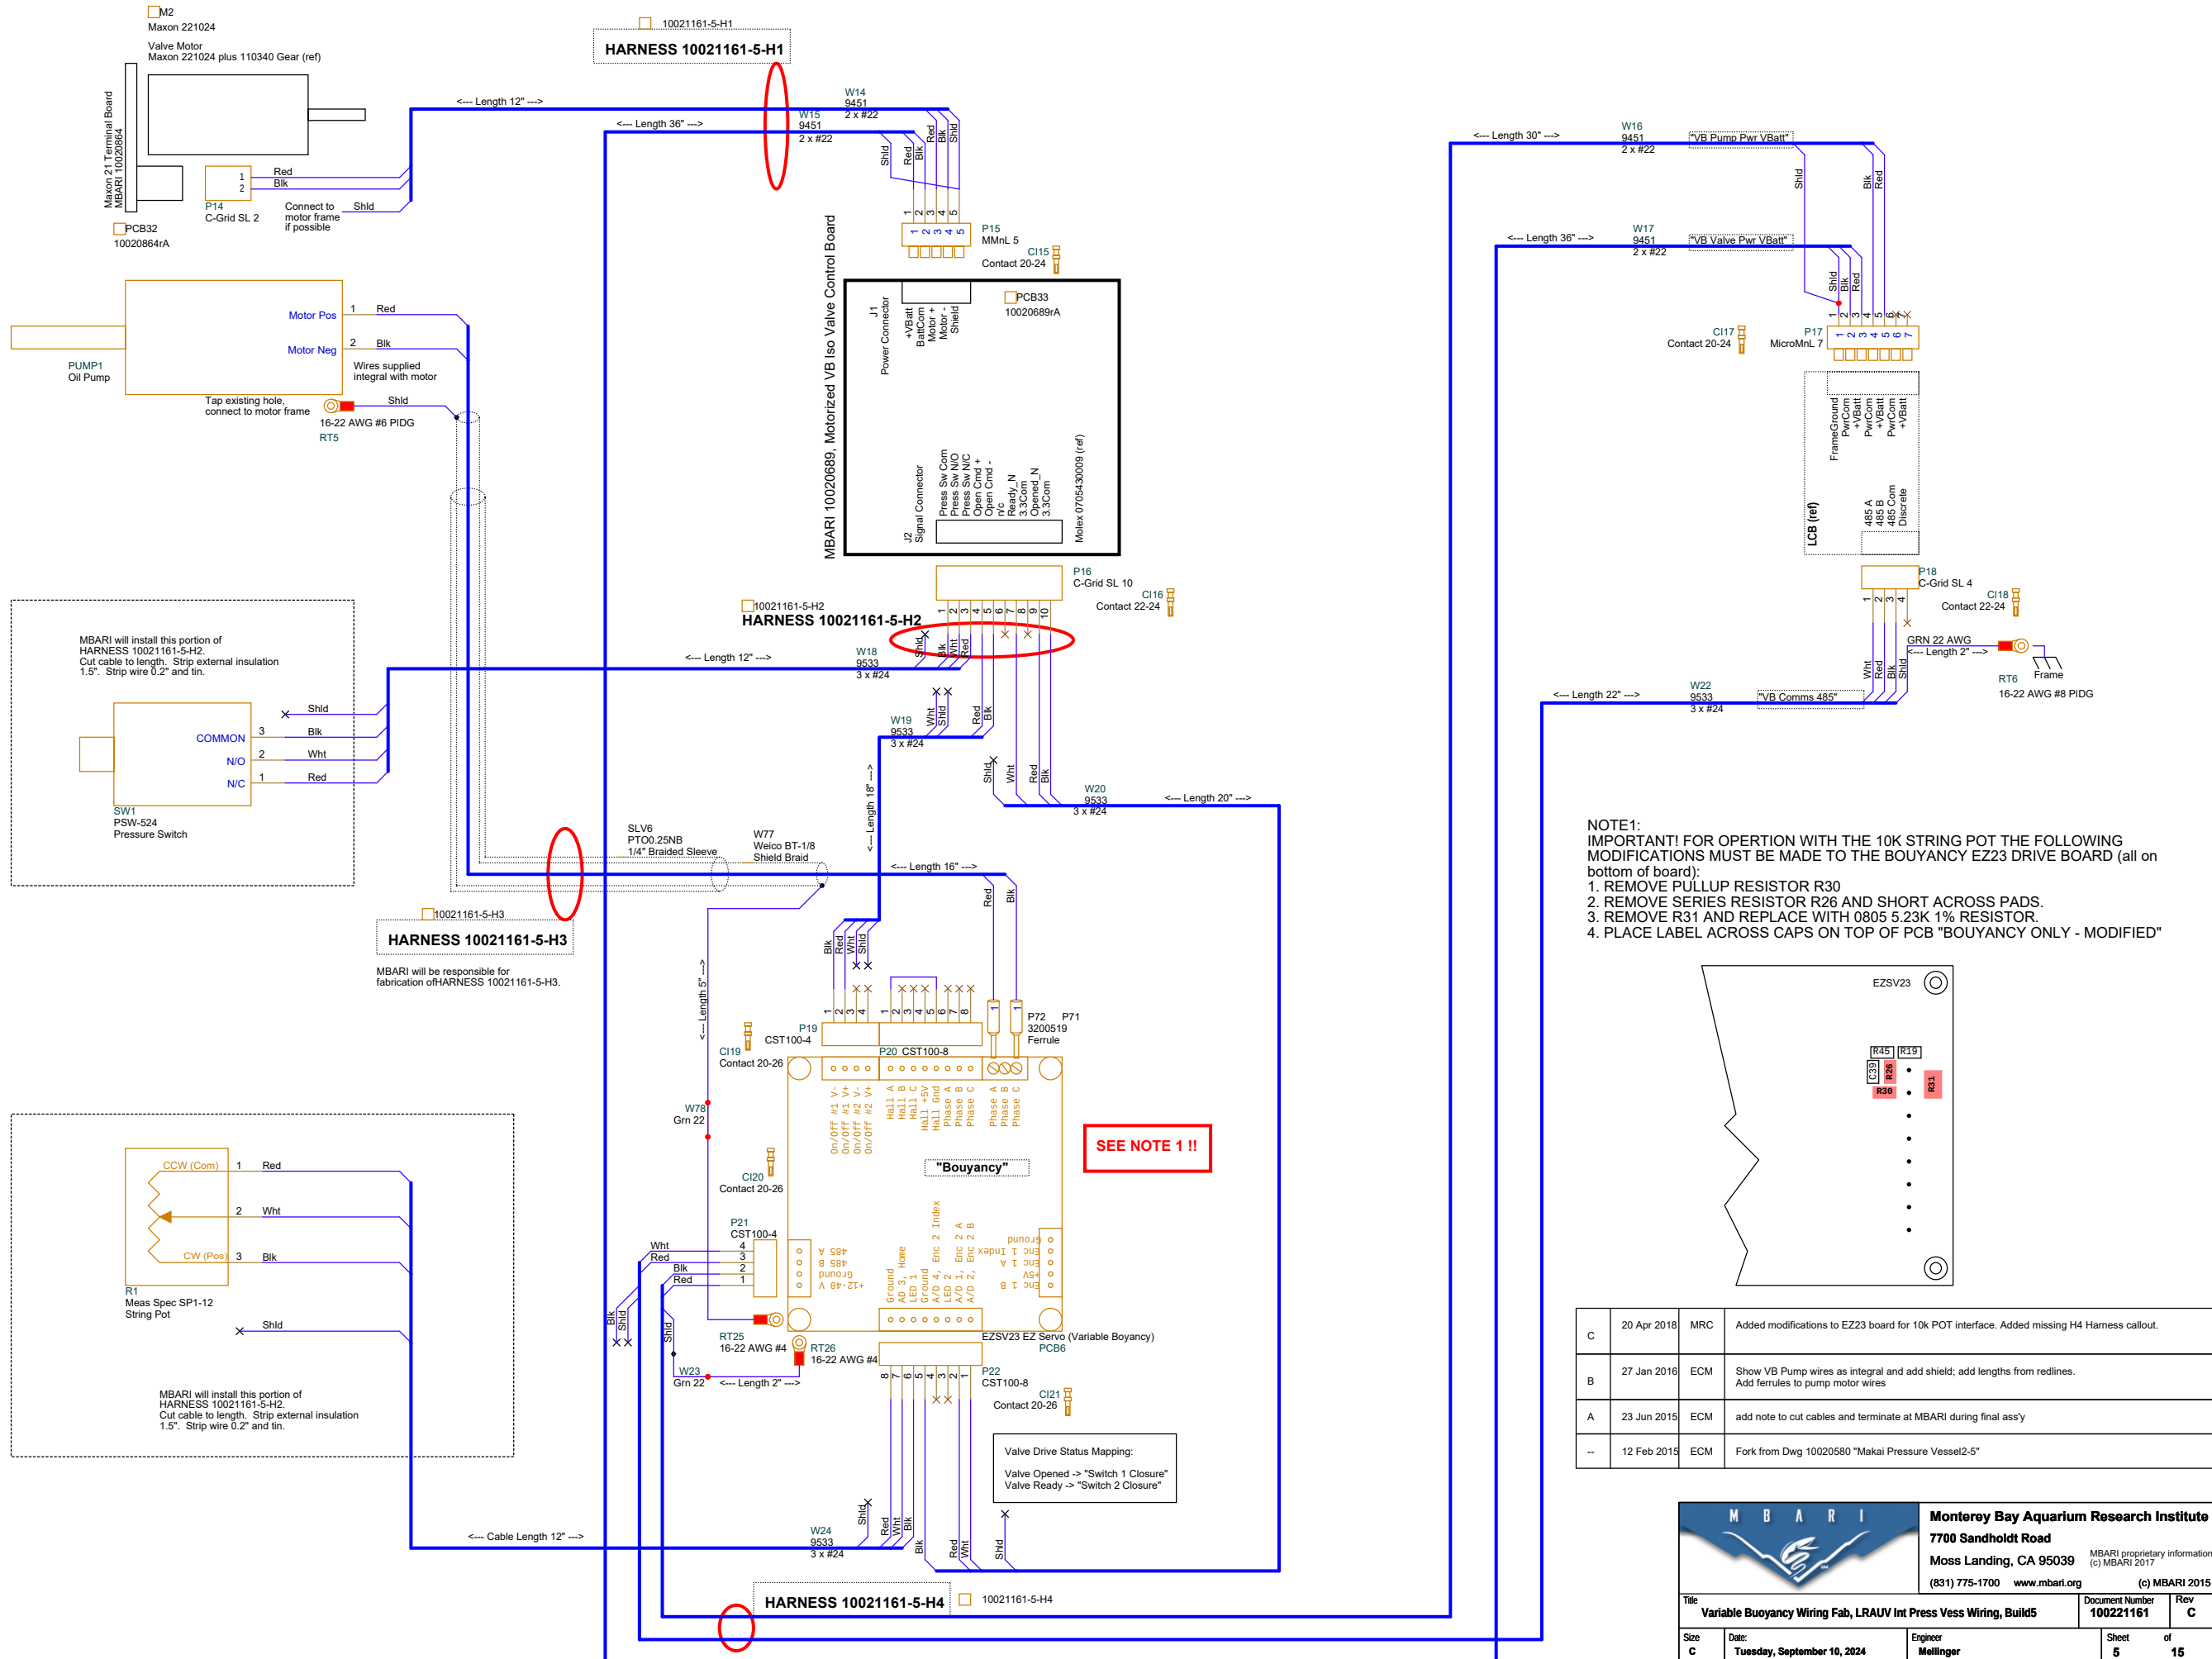

NOTE1:
IMPORTANT! FOR OPERATION WITH THE 10K STRING POT THE FOLLOWING
MODIFICATIONS MUST BE MADE TO THE BOUANCY EZ23 DRIVE BOARD (all on
bottom of board):
1. REMOVE PULLUP RESISTOR R30
2. REMOVE SERIES RESISTOR R26 AND SHORT ACROSS PADS.
3. REMOVE R31 AND REPLACE WITH 0805 5.23K 1% RESISTOR.
4. PLACE LABEL ACROSS CAPS ON TOP OF PCB "BOUANCY ONLY - MODIFIED"

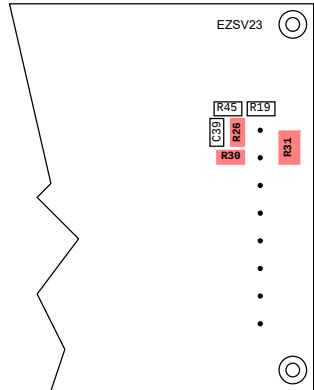

C	20 Apr 2018	MRC	Added modifications to EZ23 board for 10k POT interface. Added missing H4 Harness callout.
B	27 Jan 2016	ECM	Show VB Pump wires as integral and add shield; add lengths from redlines. Add ferrules to pump motor wires
A	23 Jun 2015	ECM	add note to cut cables and terminate at MBARI during final ass'y
--	12 Feb 2015	ECM	Fork from Dwg 10020580 "Makai Pressure Vessel2-5"



Monterey Bay Aquarium Research Institute
7700 Sandholdt Road
Moss Landing, CA 95039
(831) 775-1700 www.mbari.org

MBARI proprietary information
(c) MBARI 2017
(c) MBARI 2015

Title Variable Buoyancy Wiring Fab, LRAUV Int Press Vess Wiring, Build5		Document Number 100221161	Rev C
Size C	Date: Tuesday, September 10, 2024	Engineer Mellinger	Sheet 5 of 15
Design File DRAWINGS\LRAUV\WIRING\SYSTEM\WIRING\100221161_LRAUV_BUILD5_SYSTEM\WIRING\DRAWINGSET.DGN			
Schematic Name 100221161_Build5InternalWiring		Page Name 05 Variable Buoyancy Wiring Fab	Layout File <Layout File>

SEE NOTE 1 !!