


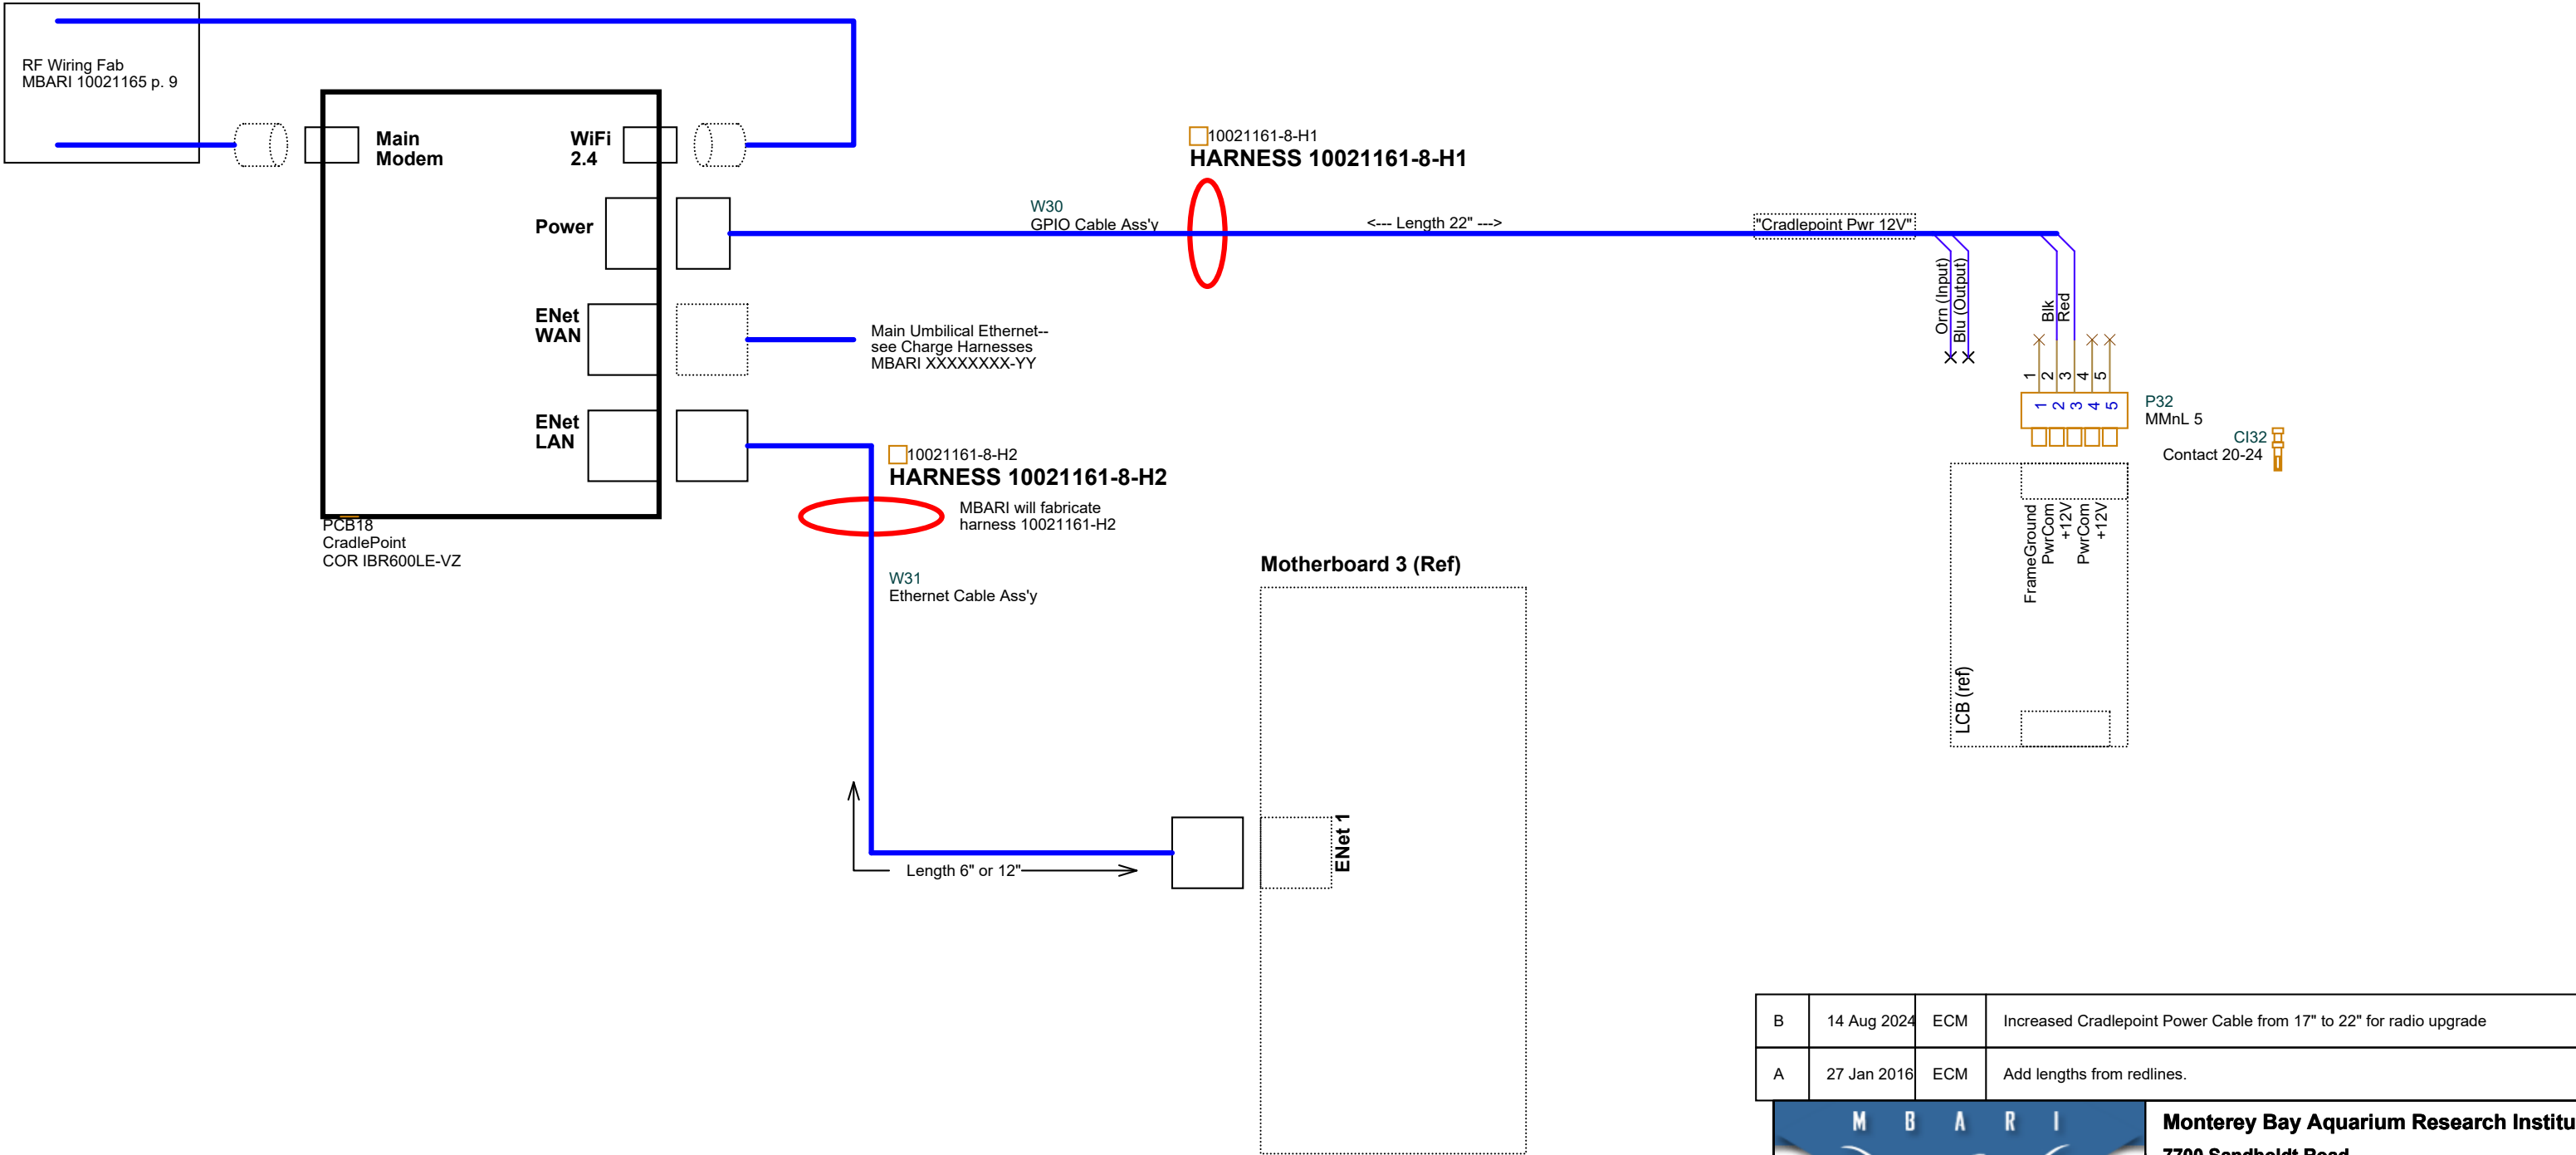

B	14 Aug 2024	ECM	Increased Cradlepoint Power Cable from 17" to 22" for radio upgrade	
A	27 Jan 2016	ECM	Add lengths from redlines.	
			Monterey Bay Aquarium Research Institute 7700 Sandholdt Road Moss Landing, CA 95039 (831) 775-1700 www.mbari.org	
			MBARI proprietary information (c) MBARI 2017	
			(c) MBARI 2015	
Title Cradlepoint 3G/WiFi Wiring Fab, LRAUV Int Press Vess Wiring, Daphne			Document Number 100221161	Rev B
Size B	Date: Wednesday, August 14, 2024	Engineer Mellinger	Sheet 8	of 15
Design File Q:\DESIGN\DRAWINGS\IEE_DRAWINGS\LRAUV\WIRING\SYSTEM\WIRING\100221189_LRAUV_BUILD5_SYSTEM\WIRING\DRAWING\SET.DSN				
Schematic Name LRAUV5BuildInternalWiring		Page Name 08 Cradlepoint 3G/WiFi Wiring	Layout File <Layout File>	