


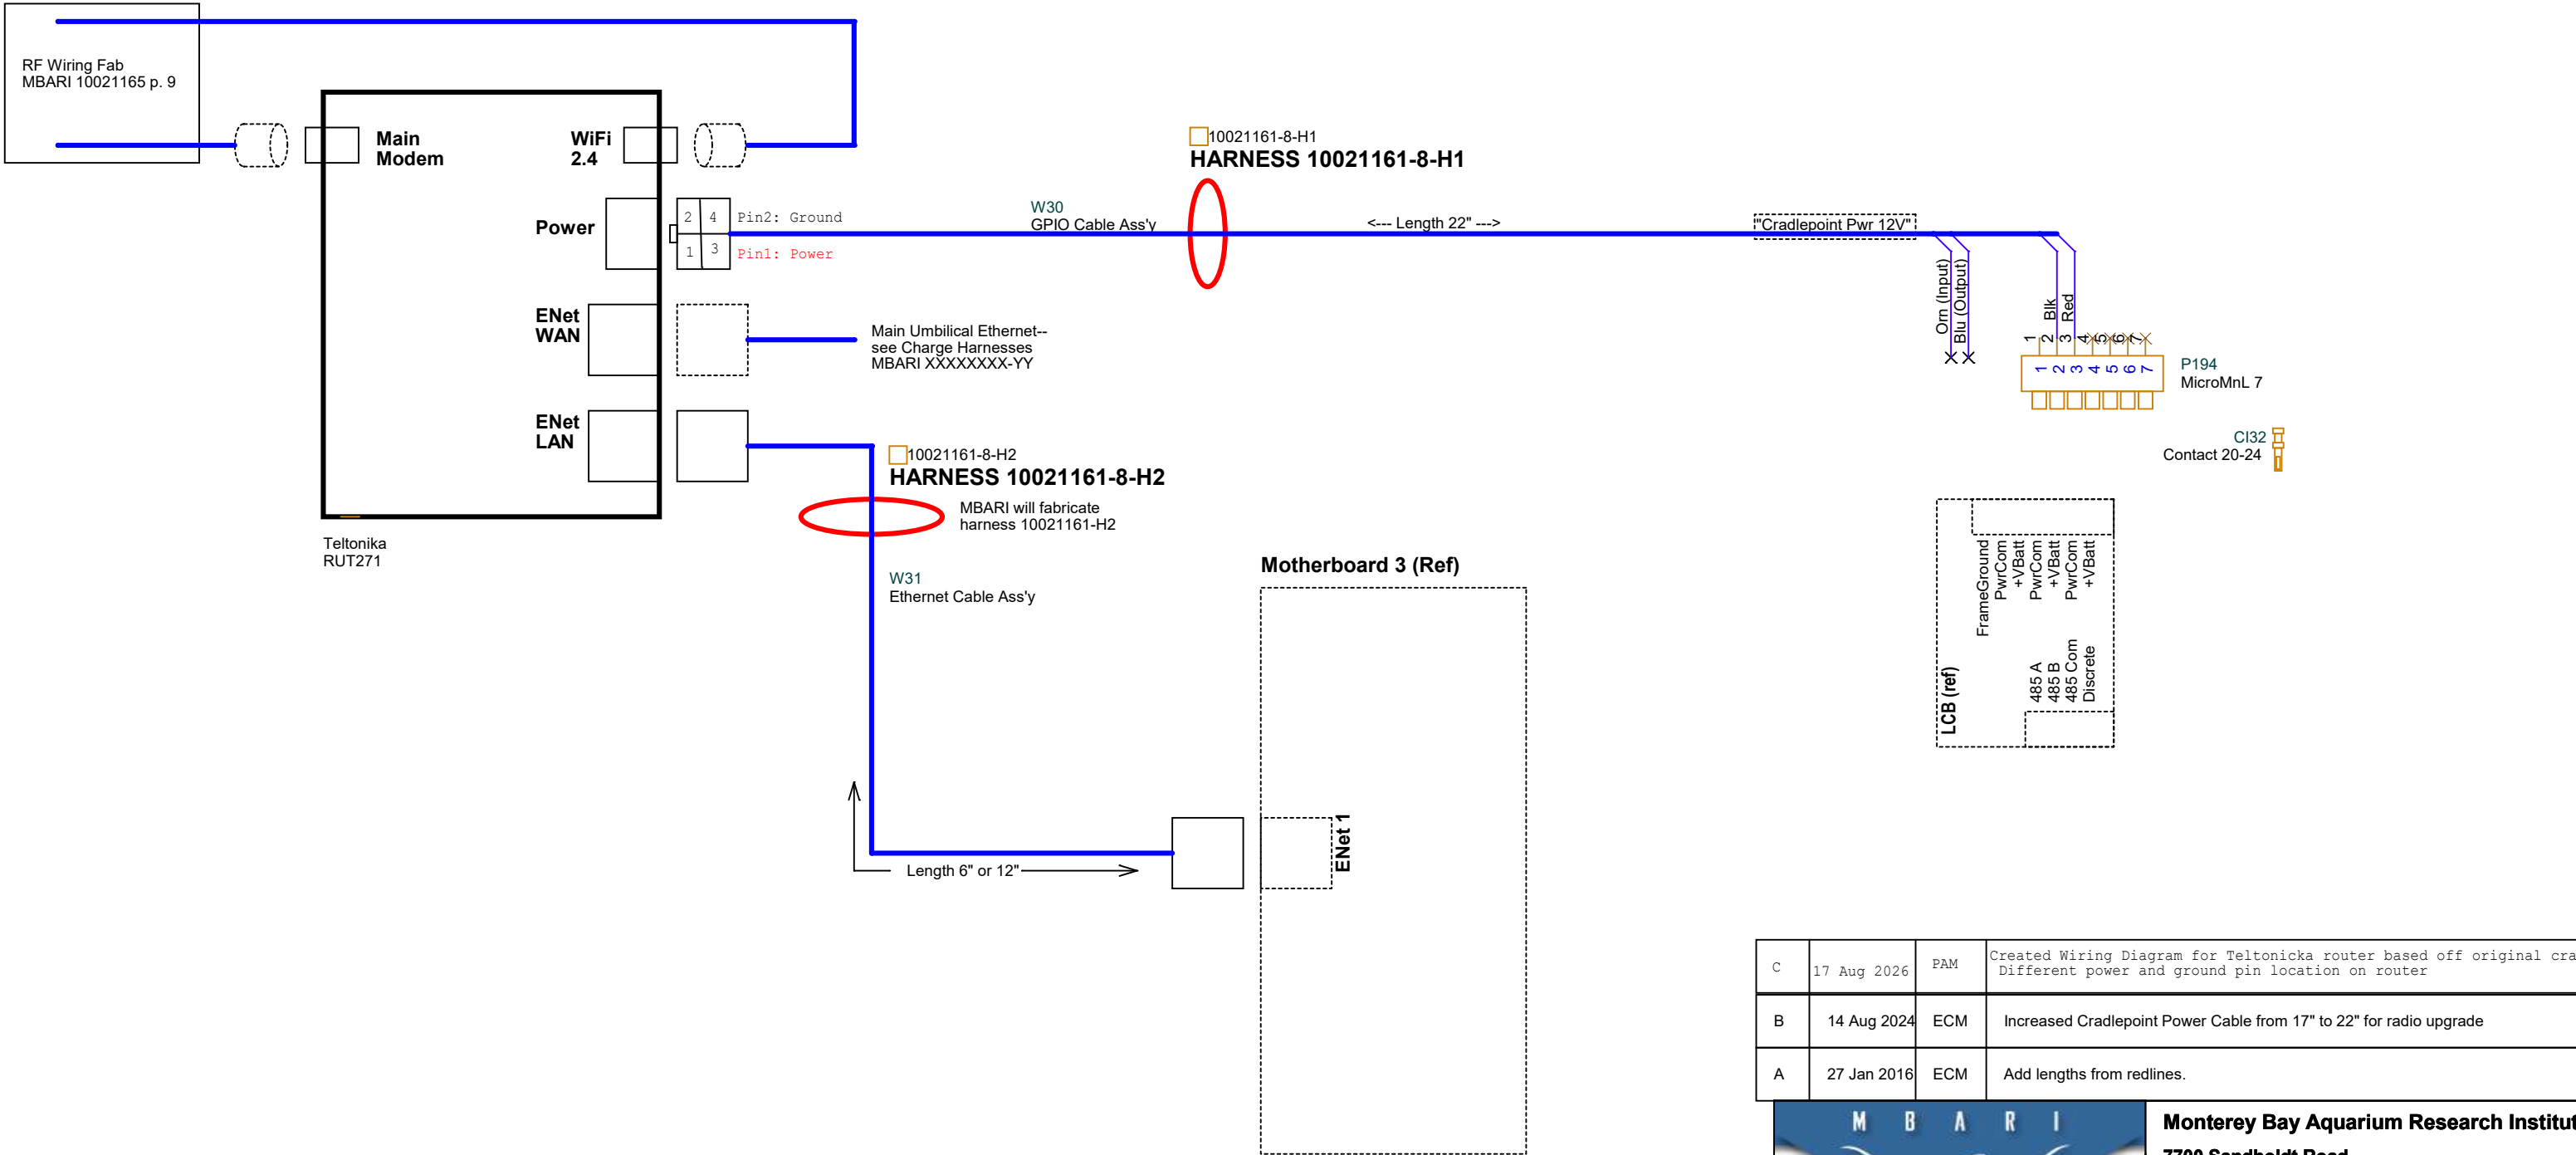

C	17 Aug 2026	PAM	Created Wiring Diagram for Teltonicka router based off original cradlepoint. Different power and ground pin location on router
B	14 Aug 2024	ECM	Increased Cradlepoint Power Cable from 17" to 22" for radio upgrade
A	27 Jan 2016	ECM	Add lengths from redlines.



Monterey Bay Aquarium Research Institute
7700 Sandholdt Road
Moss Landing, CA 95039
(831) 775-1700 www.mbari.org

MBARI proprietary information
(c) MBARI 2017
(c) MBARI 2015

Title Cradlepoint 3G/WiFi Wiring Fab, LRAUV Int Press Vess Wiring, Daphne		Document Number 100221161	Rev B
Size B	Date: Monday, August 17, 2026	Engineer Mellinger	Sheet 8 of 15
Design File W:\DESIGN\DRAWINGS\IEE_DRAWINGS\LRAUV\WIRING\SYSTEM\WIRING\100221189_LRAUV_BUILD5_SYSTEM\WIRING\DRAWINGSET.DSN			
Schematic Name 10021161 BuildInternalWiring		Page Name 08 C Teltonika RUT271 Wiring	Layout File <Layout File>