


(c) MBARI 2017 MBARI provides the documentation and materials "as is", with no warranty, express or implied, as to title, non-infringement of third party rights, merchantability, or fitness for any particular purpose, or the performance or results which you may obtain from their use. You assume the entire risk associated with use.

REVISION HISTORY:
A - 22JUN17 - LRAUV5 ORIGINAL RELEASE.
B - 04OCT17 - CHANGED P2 TO FEMALE LOCKING SLEEVE.
C - REMOVED MKS CONNECTOR AND LENGTHENED TO 24" AND CHANGED CABLE to IGUS CF-02-12

MONTEREY BAY AQUARIUM RESEARCH INSTITUTE
7700 SANDHOLDT ROAD
MOSS LANDING, CA 95039
PHONE (831) 775-1700 www.mbari.org
COPYRIGHT © 2018 MBARI
MAY NOT BE COPIED WITHOUT PERMISSION

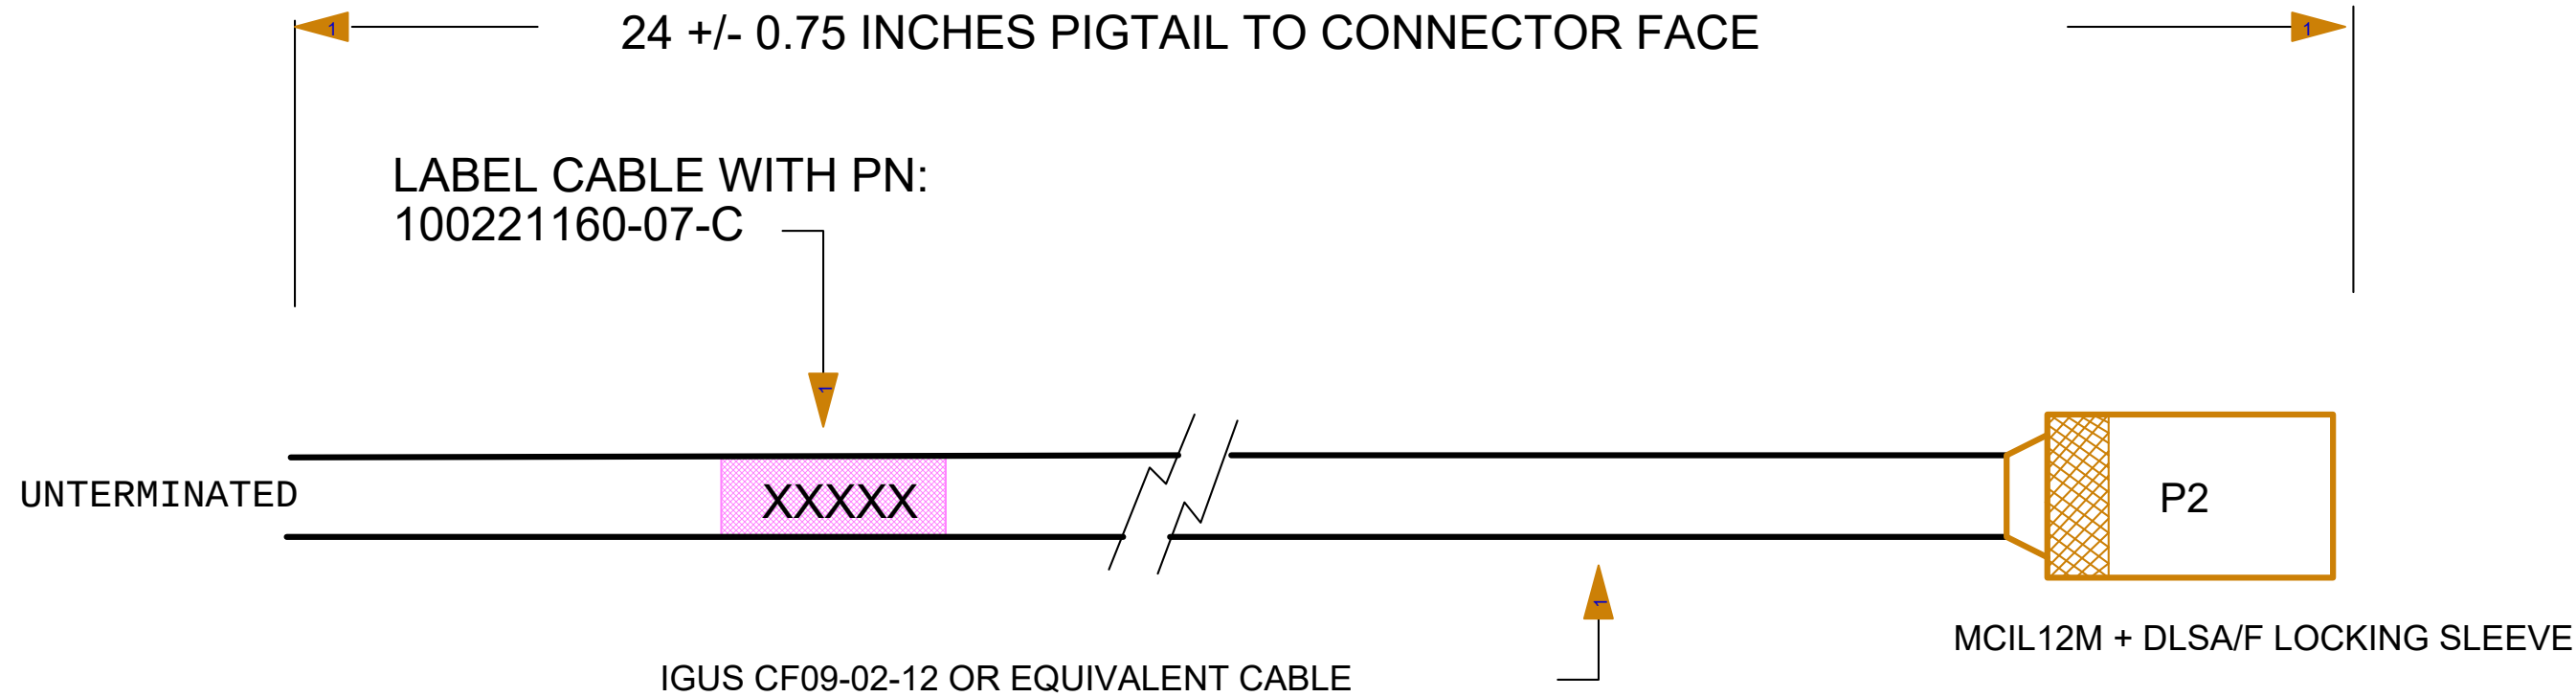

Title

LRAUV ELEVATOR & RUDDER WET CABLE

Size	Engineer: Hobson/Chaffey EMAIL: chma@mbari.org	Number	Rev
B	(831) 775-1708	100221160-07-C	C
Date: Tuesday, November 26, 2024	Filename	Sheet 1 of 1	