


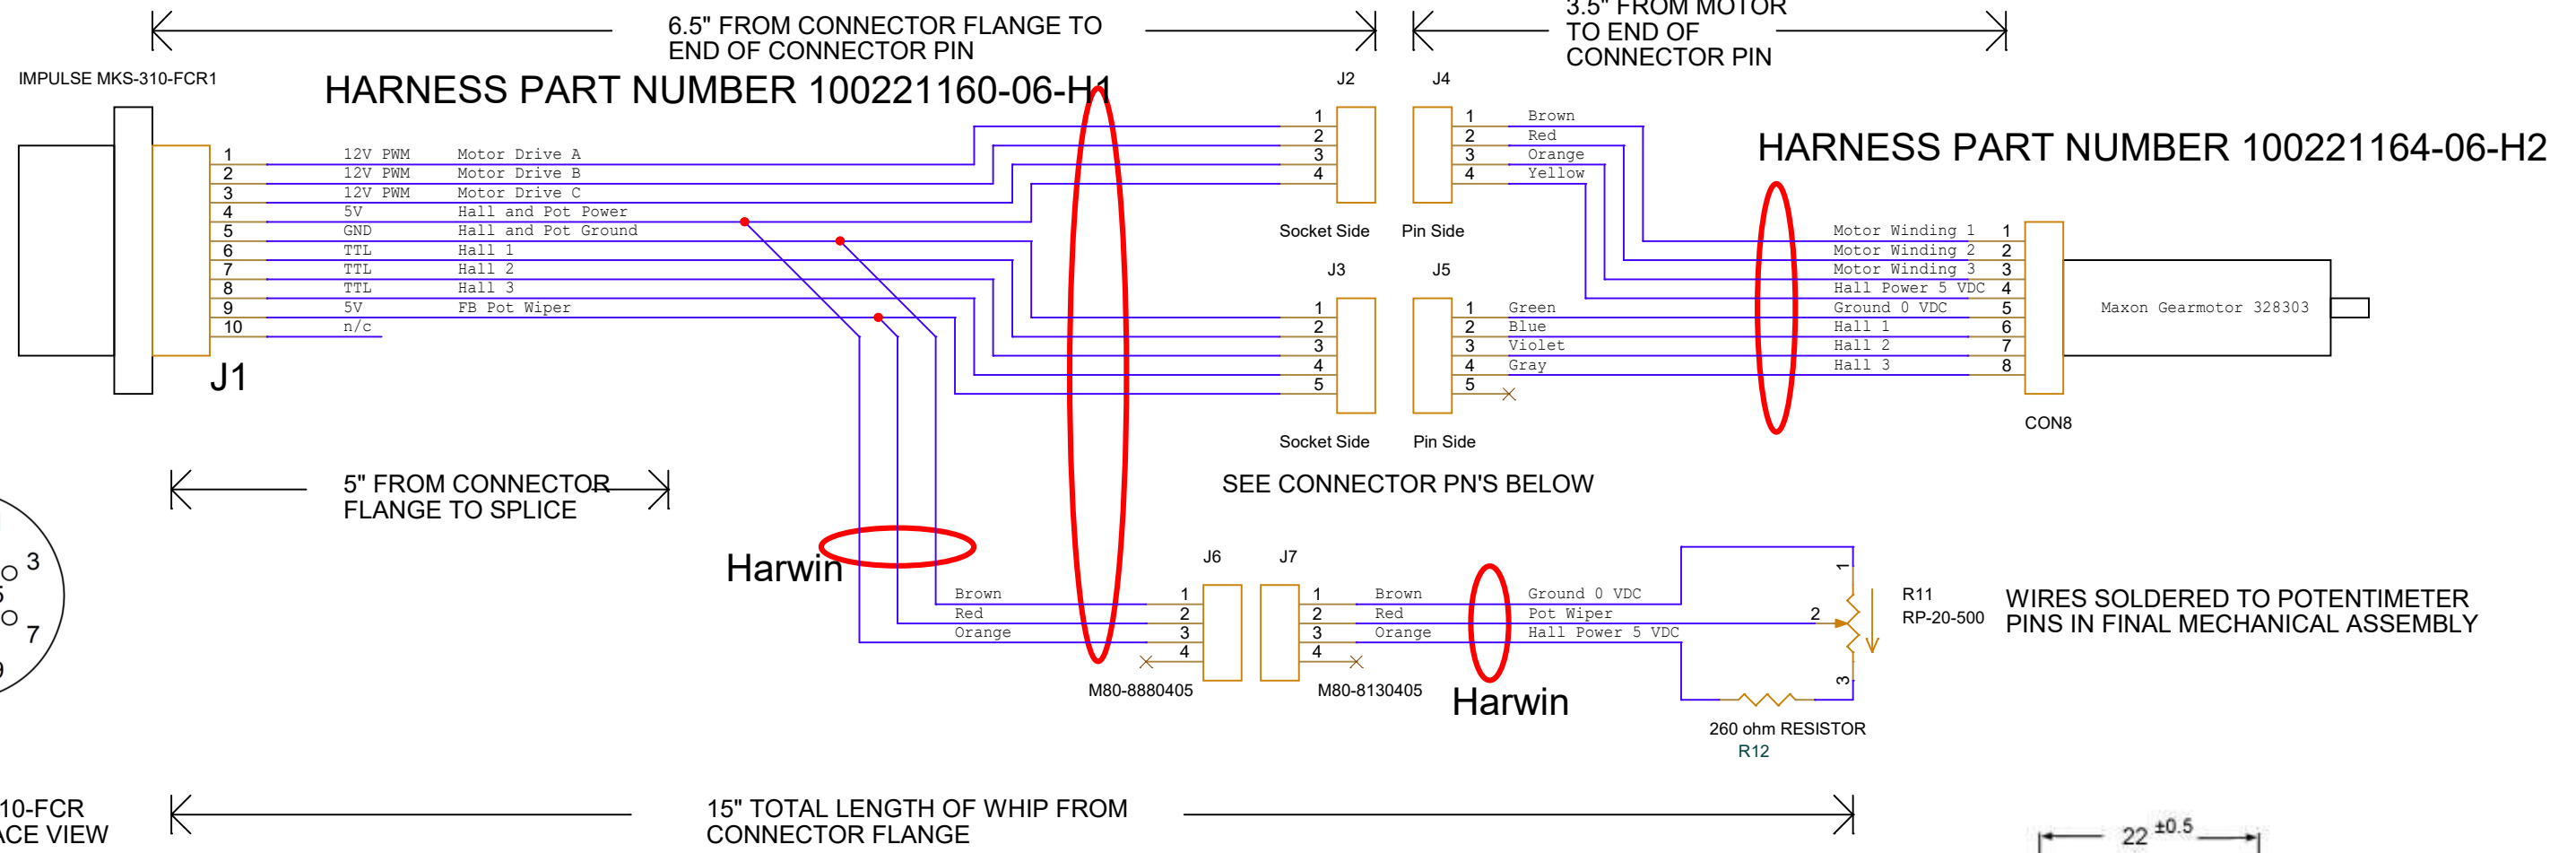

(c) MBARI 2017 MBARI provides the documentation and materials "as is", with no warranty, express or implied, as to title, non-infringement of third party rights, merchantability, or fitness for any particular purpose, or the performance or results which you may obtain from their use. You assume the entire risk associated with use.