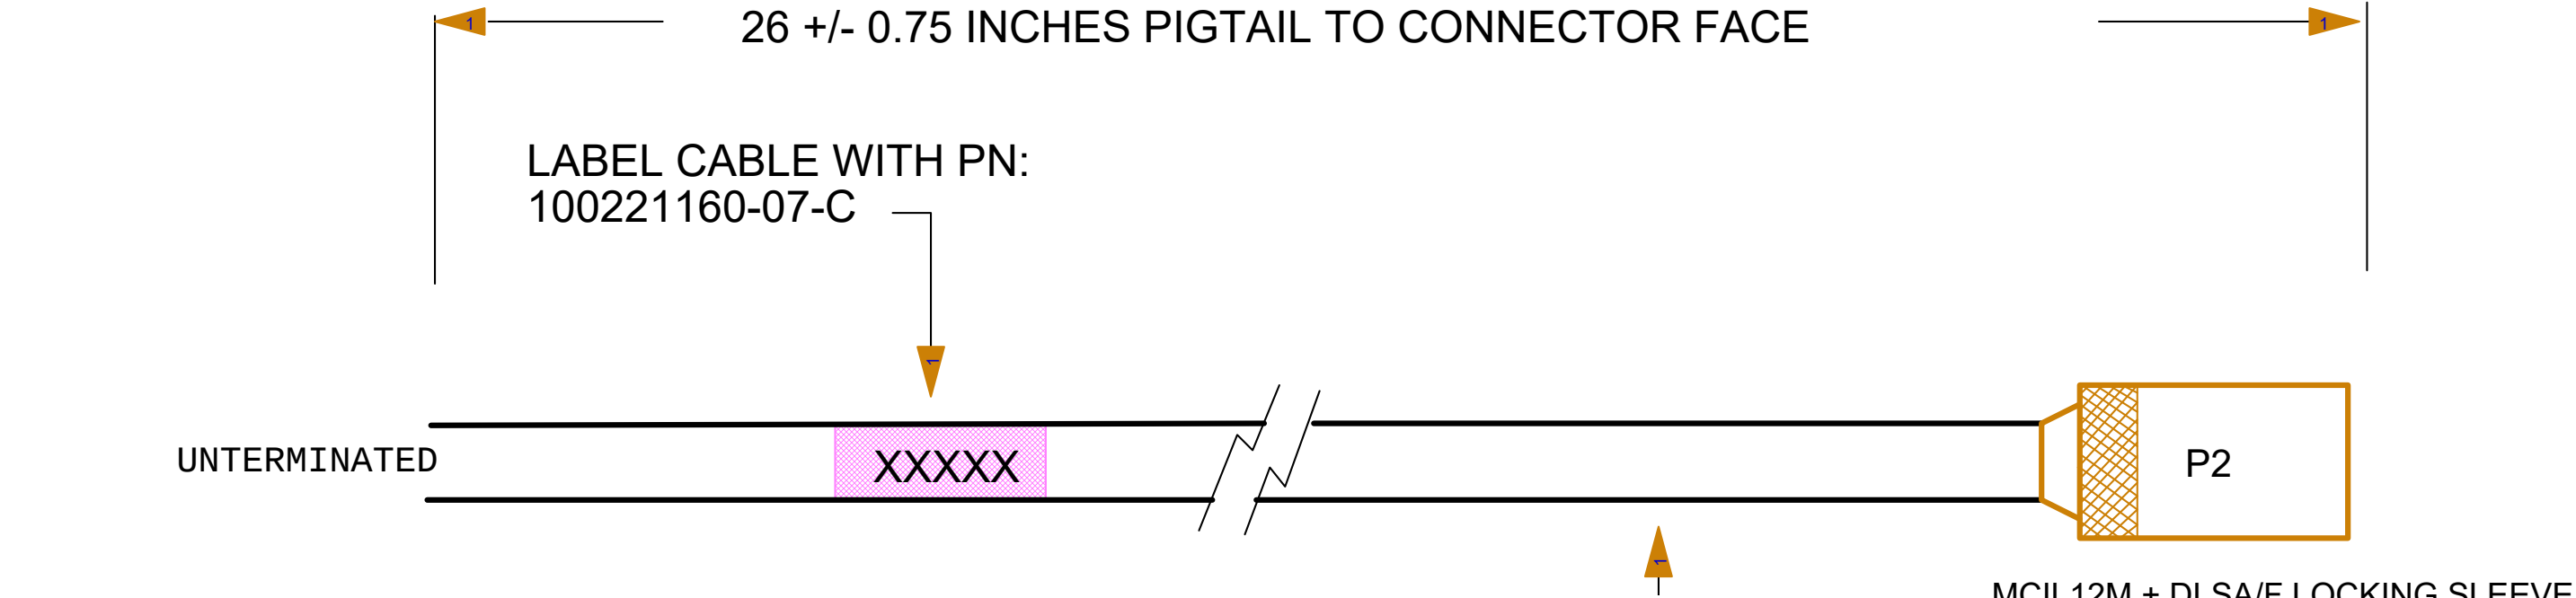


(c) MBARI 2017 MBARI provides the documentation and materials "as is", with no warranty, express or implied, as to title, non-infringement of third party rights, merchantability, or fitness for any particular purpose, or the performance or results which you may obtain from their use. You assume the entire risk associated with use.

MONTEREY BAY AQUARIUM RESEARCH INSTITUTE
7700 SANDHOLDT ROAD
MOSS LANDING, CA 95039

PHONE (831) 775-1700 www.mbari.org
COPYRIGHT © 2018 MBARI
MAY NOT BE COPIED WITHOUT PERMISSION

MBARI

Title

LRAUV ELEVATOR & RUDDER WET CABLE

Size	Engineer: Hobson/Chaffey EMAIL: chma@mbari.org (831) 775-1708	Number	100221160-07-C	Rev	C
B	Date: Monday, April 28, 2025	Filename	Sheet 1 of 1		

REVISION HISTORY:
A - 22JUN17 - LRAUV5 ORGINAL RELEASE.
B - 04OCT17 - CHANGED P2 TO FEMALE LOCKING SLEEVE.
C - REMOVED MKS CONNECTOR AND LENGTHENED TO 26" AND CHANGED CABLE to IGUS CF211-PUR-02-05-02