
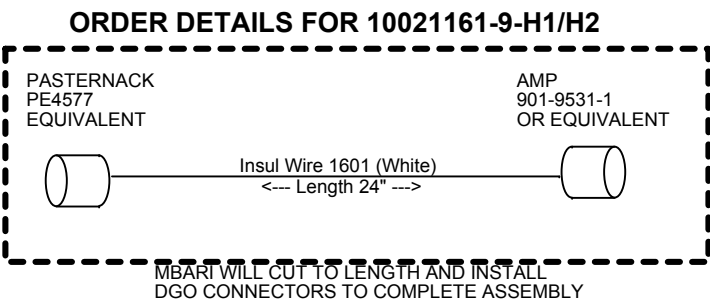


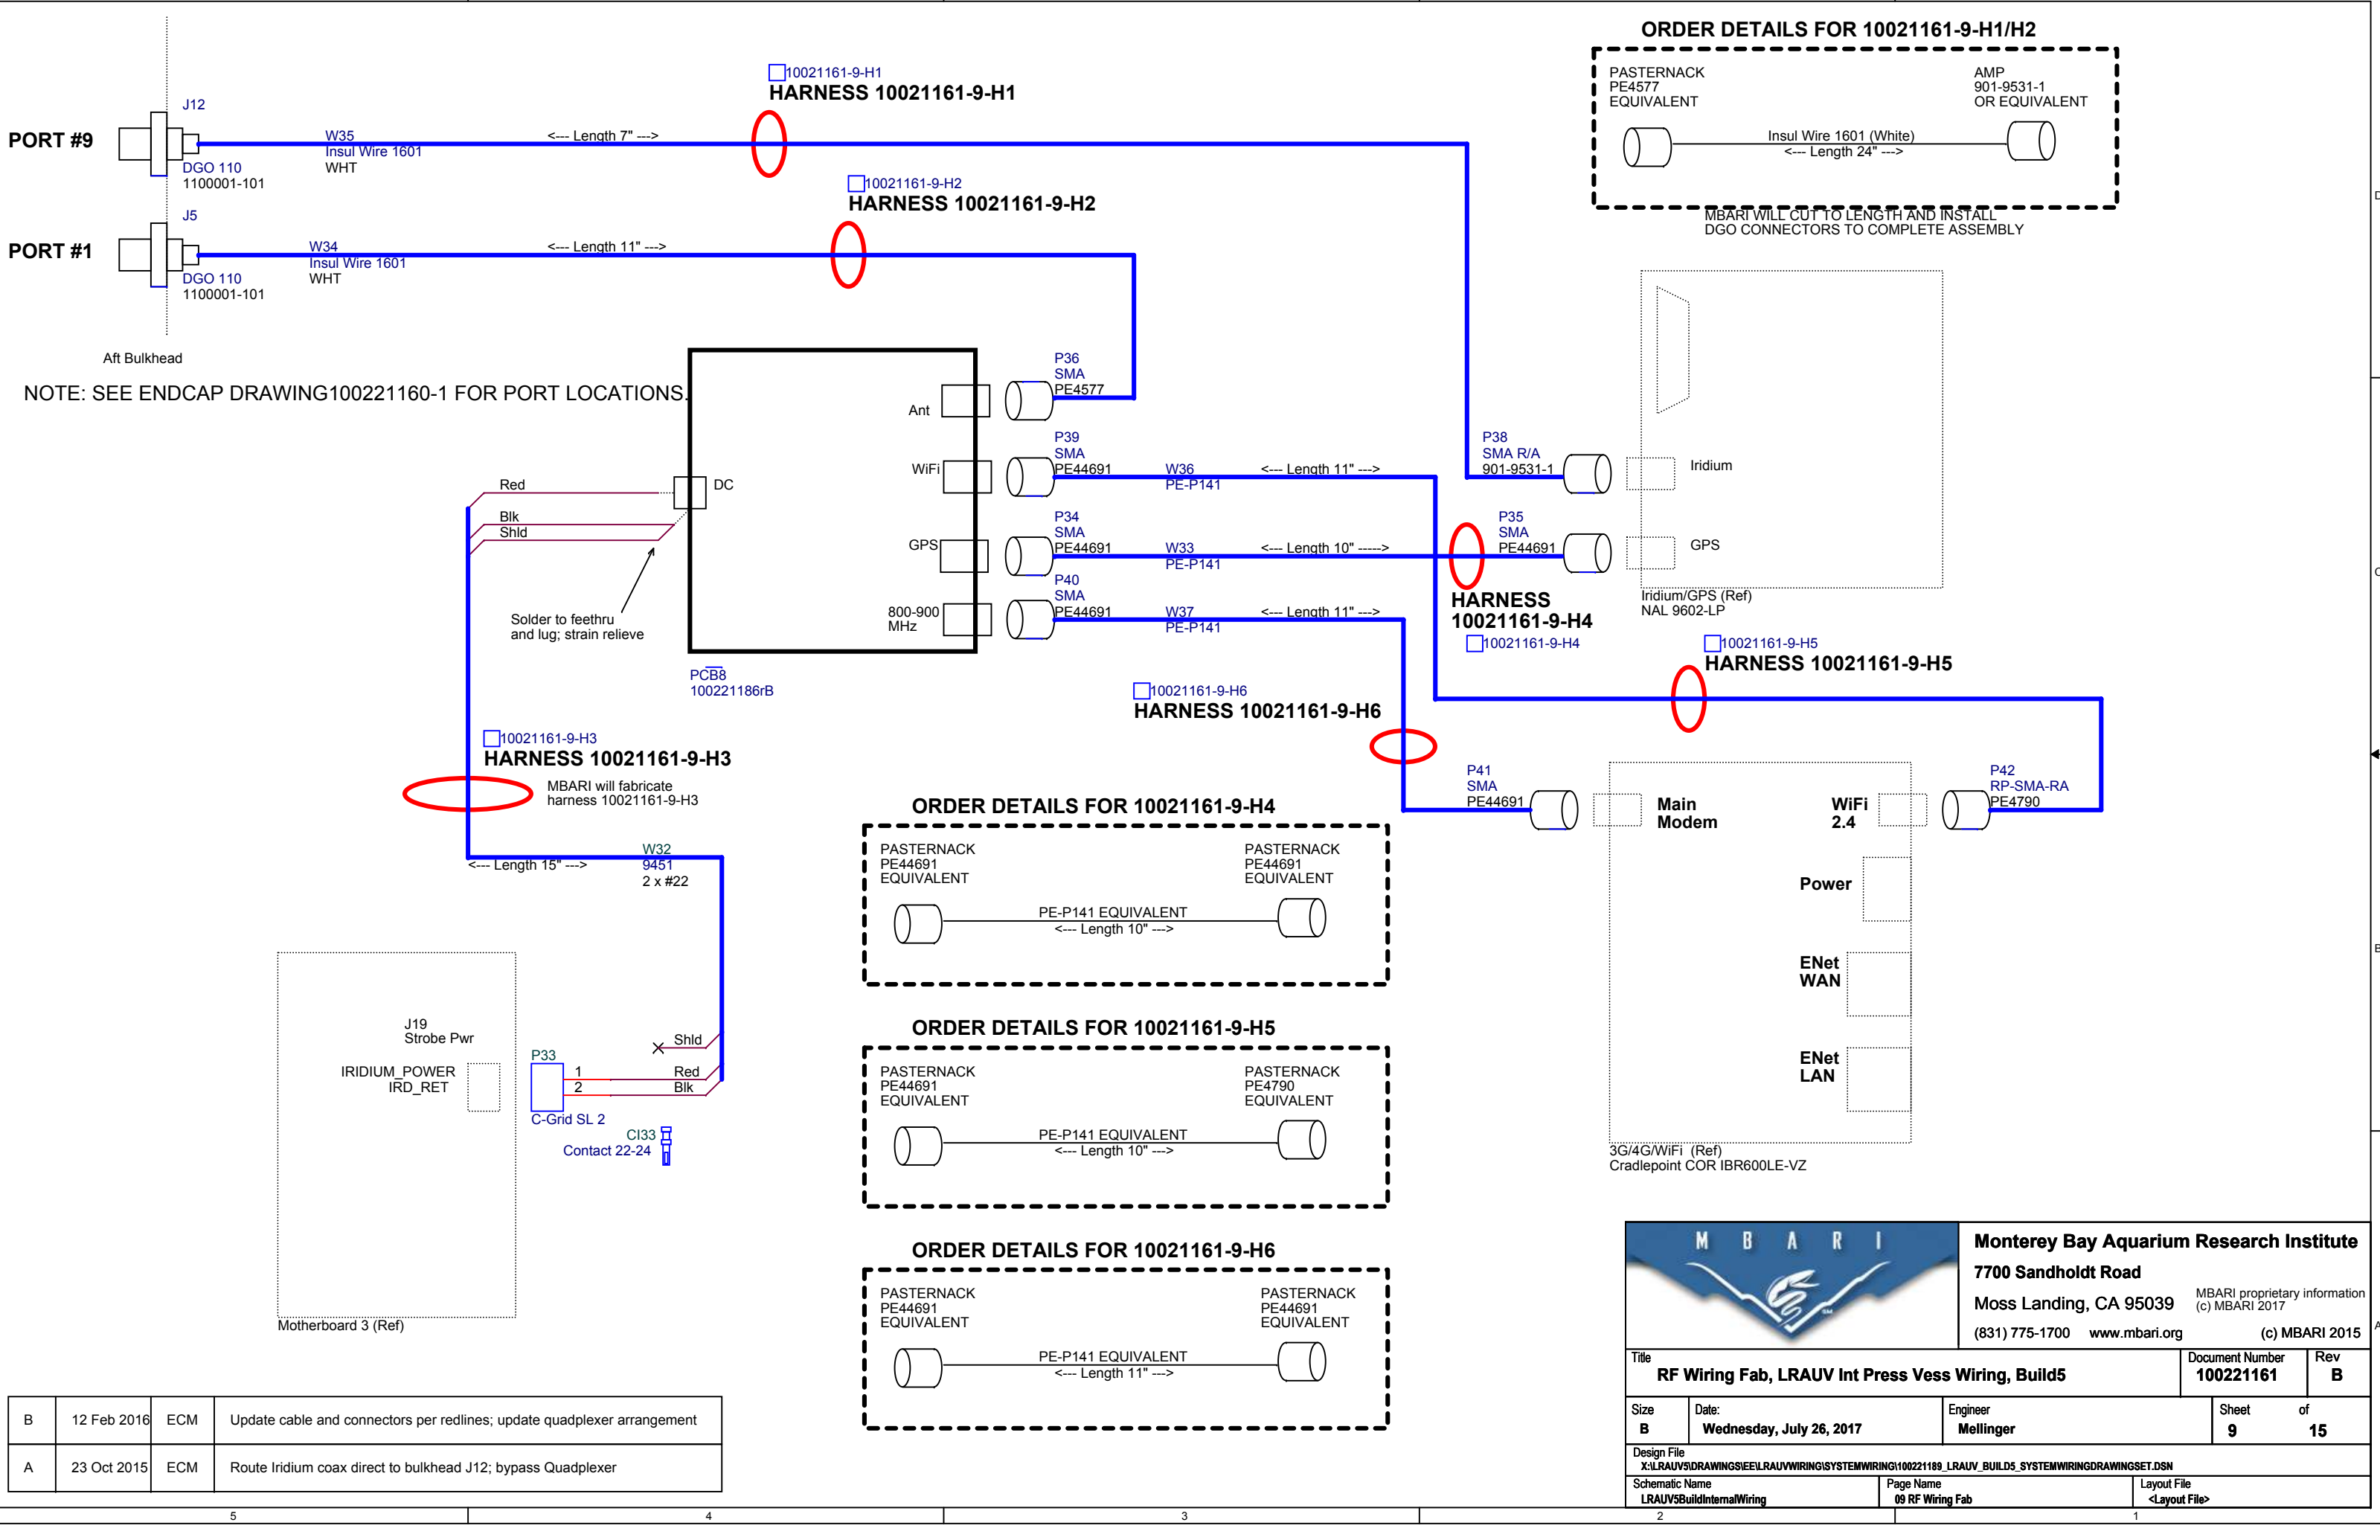

Monterey Bay Aquarium Research Institute

7700 Sandholdt Road

Moss Landing, CA 95039

(831) 775-1700 www.mbari.org

MBARI proprietary information
(c) MBARI 2017

(c) MBARI 2015

Title RF Wiring Fab, LRAUV Int Press Vess Wiring, Build5		Document Number 100221161	Rev B
Size B	Date: Wednesday, July 26, 2017	Engineer Mellinger	Sheet 9 of 15
Design File X:\LRAUV5\DRAWINGS\EE\LRAUVWIRING\SYSTEMWIRING\100221189_LRAUV_BUILD5_SYSTEMWIRINGDRAWINGSET.DSN			
Schematic Name LRAUV5BuildInternalWiring		Page Name 09 RF Wiring Fab	Layout File <Layout File>

B	12 Feb 2016	ECM	Update cable and connectors per redlines; update quadplexer arrangement
A	23 Oct 2015	ECM	Route Iridium coax direct to bulkhead J12; bypass Quadplexer