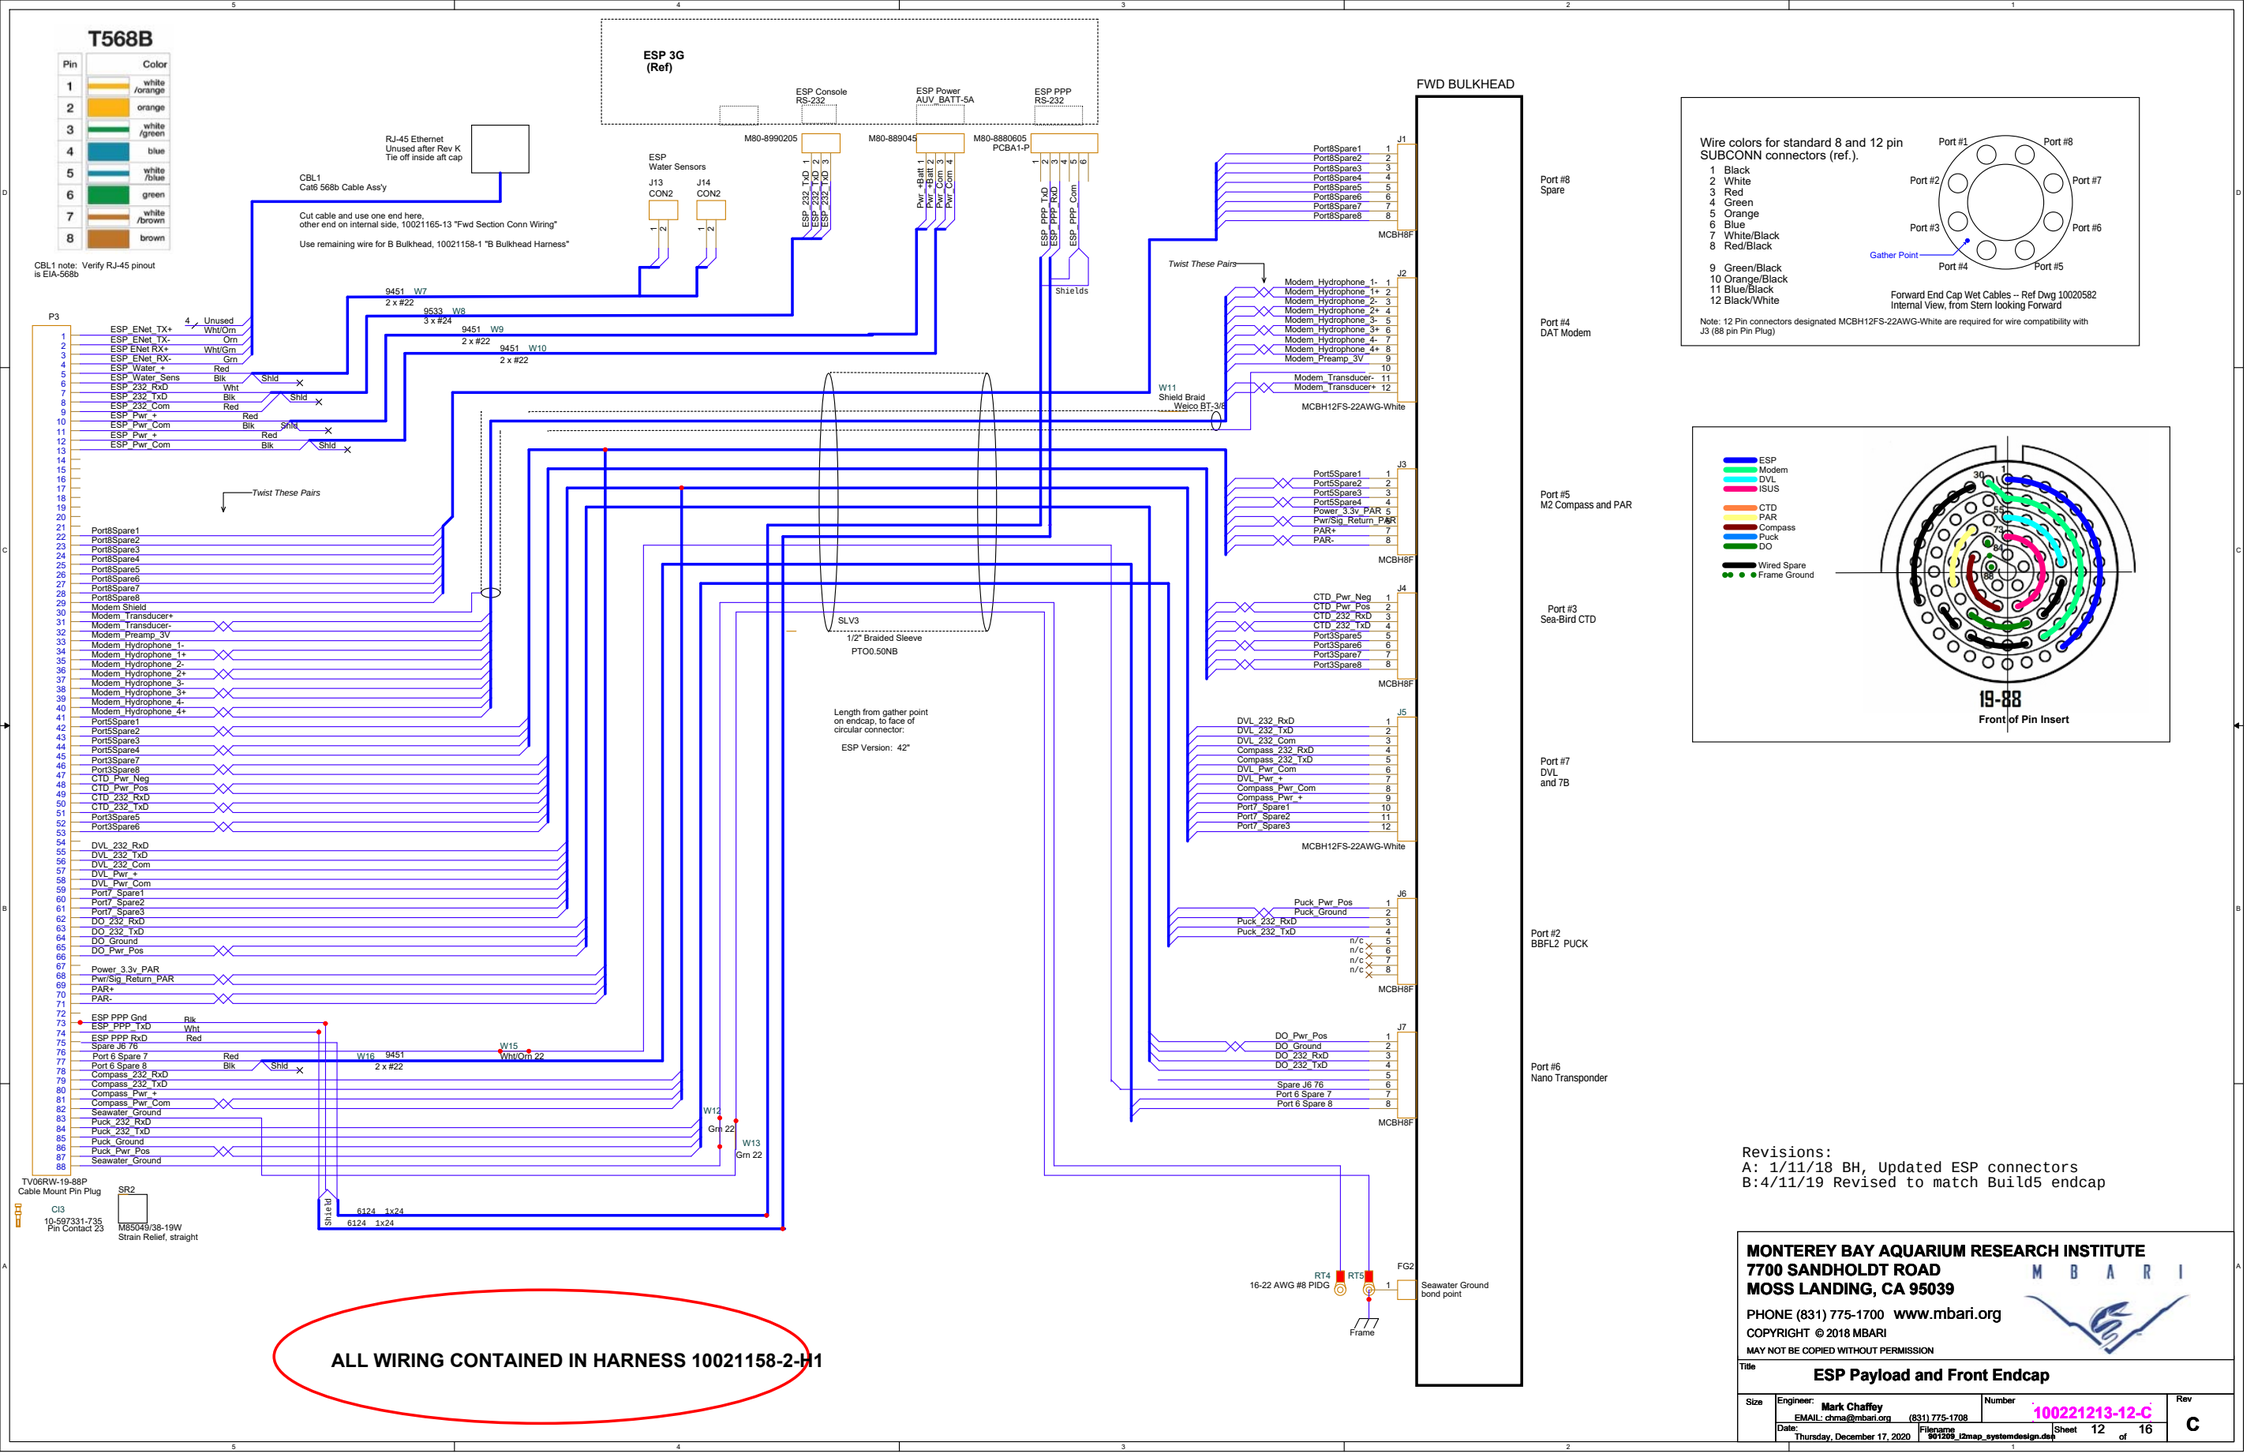

Revisions:
A: 1/11/18 BH, Updated ESP connectors
B:4/11/19 Revised to match Build5 endcap

MONTEREY BAY AQUARIUM RESEARCH INSTITUTE
7700 SANDHOLDT ROAD
MOSS LANDING, CA 95039
PHONE (831) 775-1700 www.mbari.org

COPYRIGHT © 2018 MBARI
MAY NOT BE COPIED WITHOUT PERMISSION

Title: **ESP Payload and Front Endcap**

Size	Engineer: Mark Chaffey, EMAIL: chma@mbari.org (831) 775-1708	Number: 100221213-12-C	Rev: C
	Date: Thursday, December 17, 2020	Filename: 901209_t2map_systemdesign.dsn	Sheet 12 of 16