

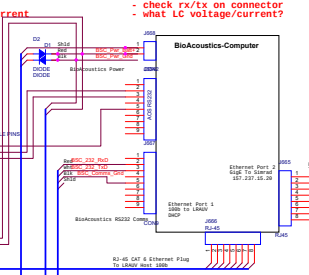


- T000:
- update connectors
 - cable length
 - LC can be 12V very small current

- T000:
- update connectors
 - check rx/tx on connector
 - what LC voltage/current?

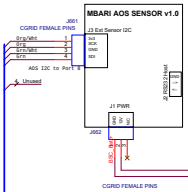


HARNESS 10021161-13-H2

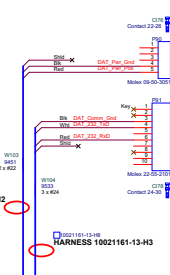



DAT#03 Transponder Board Set

ATM-ESP-PCB Modem Board Set

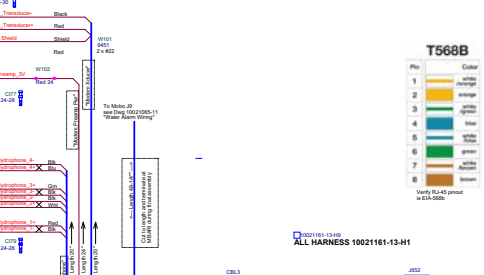

T568B

Pin	Color

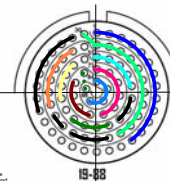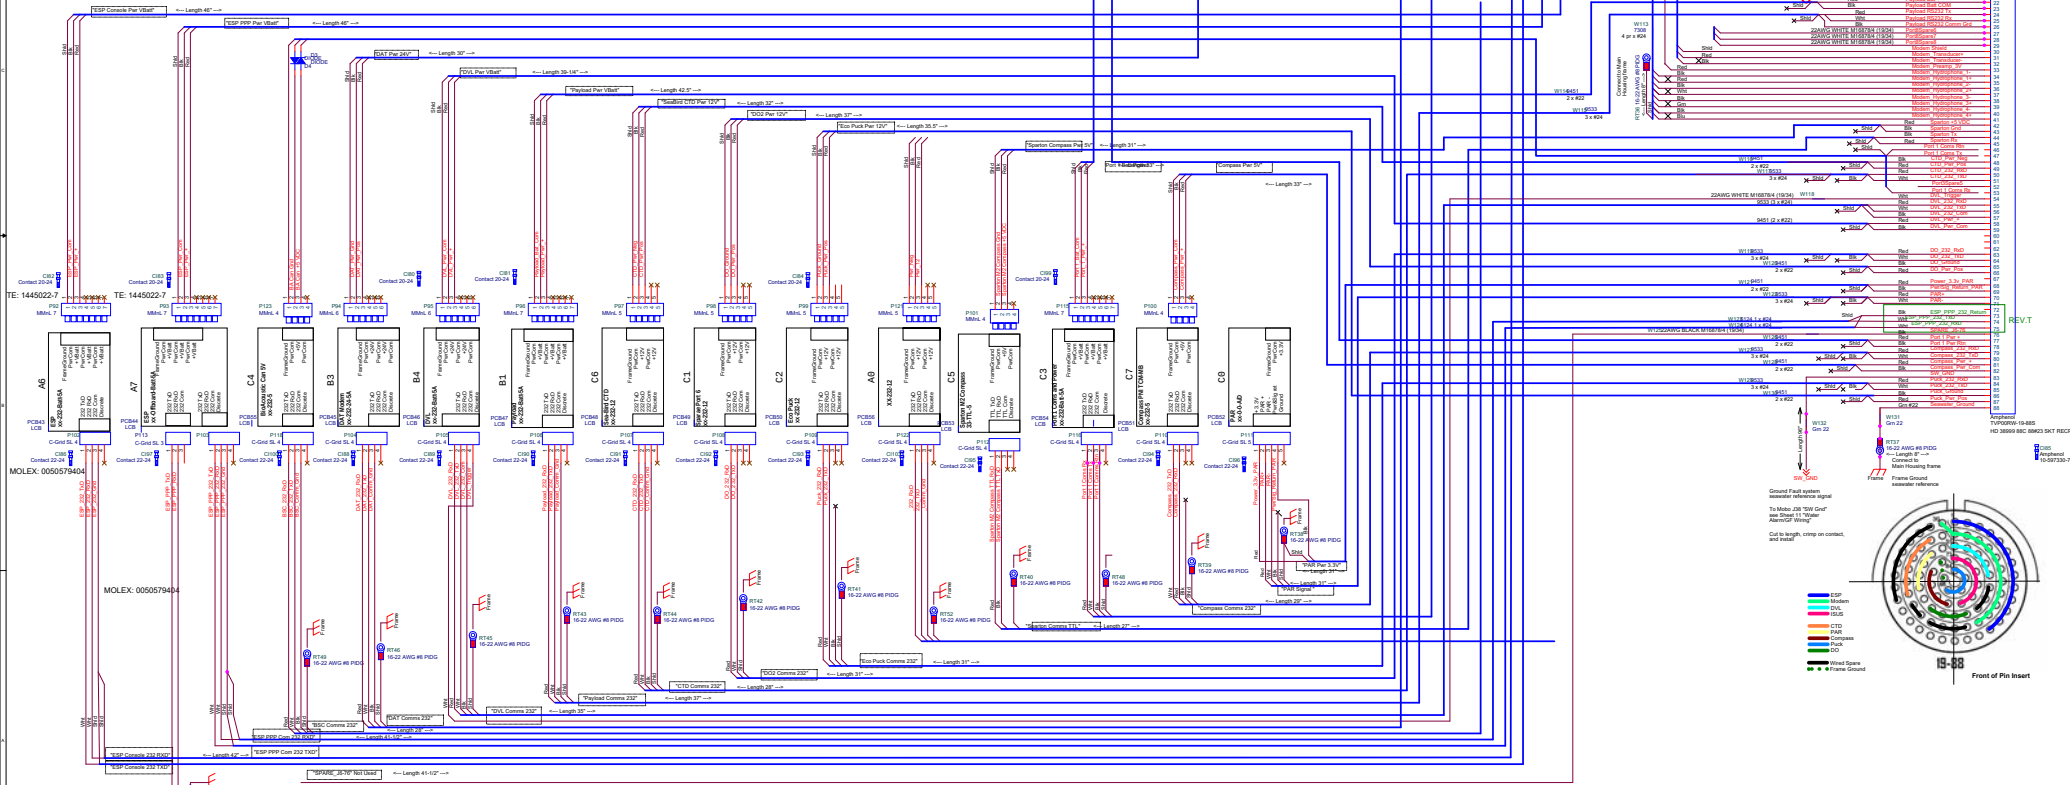

NOTE: Board position on drawing does not correspond to board position in vehicle. See vehicle/mission specific config doc

Rev	Date	Author	Description	Rev	Date	Author	Description	Rev	Date	Author	Description
1	17 Jan 2020	BH	Added Part 1 Ethernet-to-serial	1	5 Feb 2016	PC	Corrected wiring to the ESP PPP Control LCB	1	27 Jan 2016	ECM	Swapped TxD on DAT, DVI, CTS, DCD, and Puck LCBs. Add lengths from redline markings.
2	4 Aug 2018	BH	Added ESP PPP 68B Jumper and LCBs	2	20 Jan 2016	PC	Changed cable lengths and labels. Added connectors for ESP LCBs to be ESP main.	2	19 Nov 2015	ECM	Change Compress LCB and wiring to 2355V
4	21 Aug 2018	MAC	Modified wiring for ESP serial control to enable single conductor to reduce cable.	4	20 Jan 2016	ECM	Change CTS, Power from 30V to 100V (change LCB, change PMS)	4	1 Jan 2015	ECM	Joined M8000 Manufacturer and Distributor control pins (Batteries in Boxes)
5	29 May 2018	PC	Added wiring and LCB to Synchron Compress	5	19 Apr 2016	ECM	Replaced 1000 LCB cable, for ESP PPP via LCB to M8000. Delete old numbers from LCB cables.	5	4 May 2015	ECM	Change USB cable to Ethernet, add LCB M8000 Main-to-LCB contacts and correct DAT M8000 contacts

Monterey Bay Aquarium Research Institute

7700 Sandhollow Road

Marine Laboratory, CA 94038

831.775.0000

www.mbari.edu

10/20/2015

Rev

1

2

