


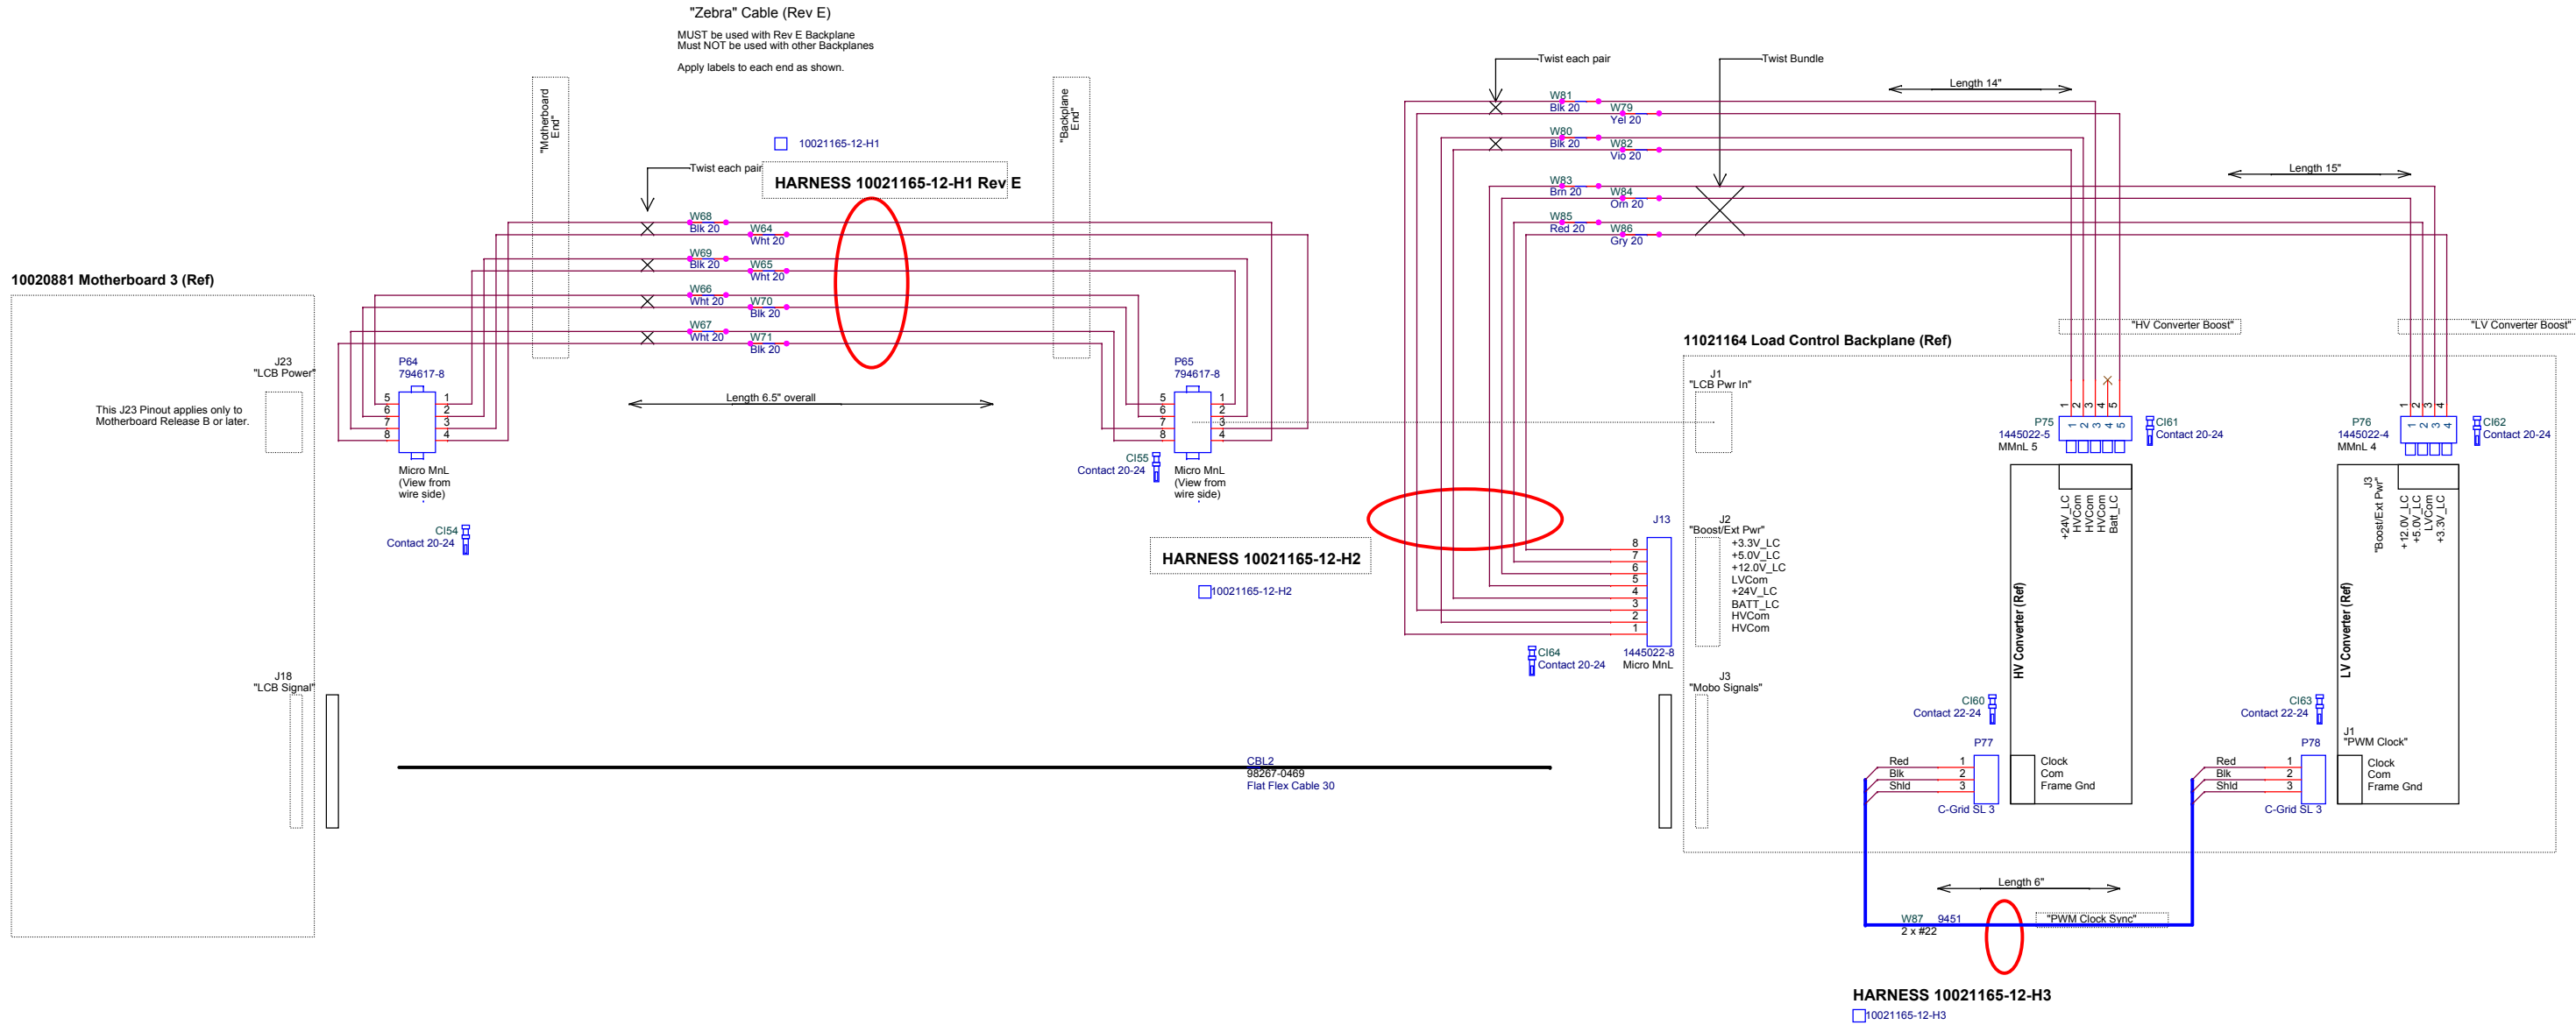

E	2018-May-24	ECM	Change H1 "Zebra" cable to match Rev E Backplane Change P75 HV Converter Boost pinout to match HV Converter as-built
D	2017-May-5	ECM	Add cable lengths, correct J13 callout
C	2016-May-11	ECM	Add Converter Boost and PWM Clock Cables
B	2015-Oct-22	ECM	Change flat flex cable CBL2 to 3" length
A	2015-Sep-10	ECM	move Test Cable to separate Schematic



Monterey Bay Aquarium Research Institute
7700 Sandholdt Road
Moss Landing, CA 95039
(831) 775-1700 www.mbari.org (c) MBARI 2015

Title		Document Number		Rev	
Load Control Backplane Wiring Fab, LRAUV Int Press Vess Wiring, Build5		10021165		E	
Size	Date:	Engineer	Sheet	of	
Custom	Thursday, May 24, 2018	Mollinger	12	15	
Design File					
I:\ATLAS\PROJECT\LIBRARY\981727-98_LRAUVS_BUILD5\DESIGN\DRAWINGS\SEE_DRAWINGS\LRAUV_WIRING\SYSTEM\WIRING\10021165_LRAUV_BUILD5_SYSTEM\WIRING\10021165_LRAUV_BUILD5_LAYOUT.LAY					
Schematic Name		Page Name		Layout File	
LRAUVSBuildInternalWiring		12 Ld Cbl Backplane Wiring Fab		<Layout File>	