

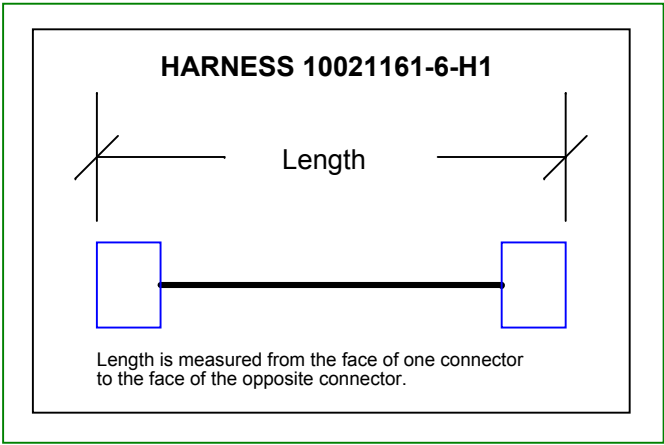




REV.C

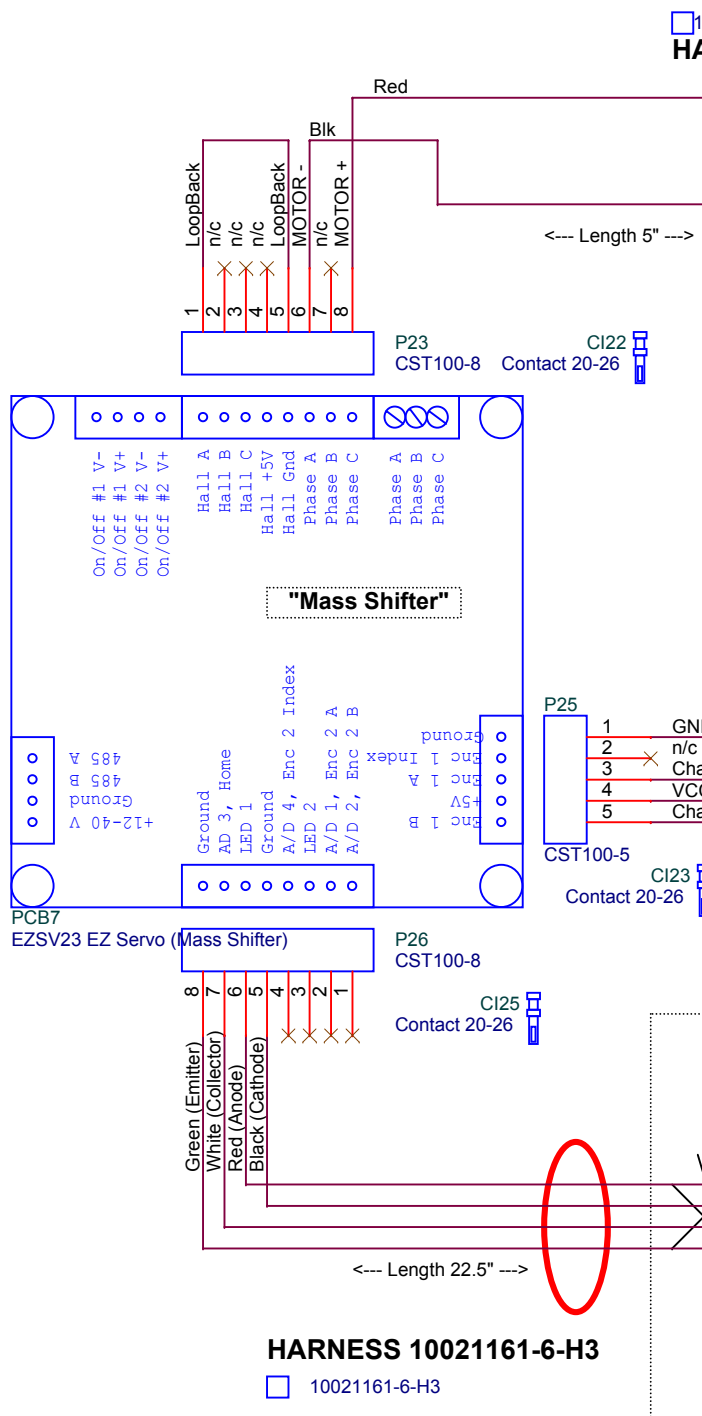

10021161-6-H1
HARNESS 10021161-6-H1

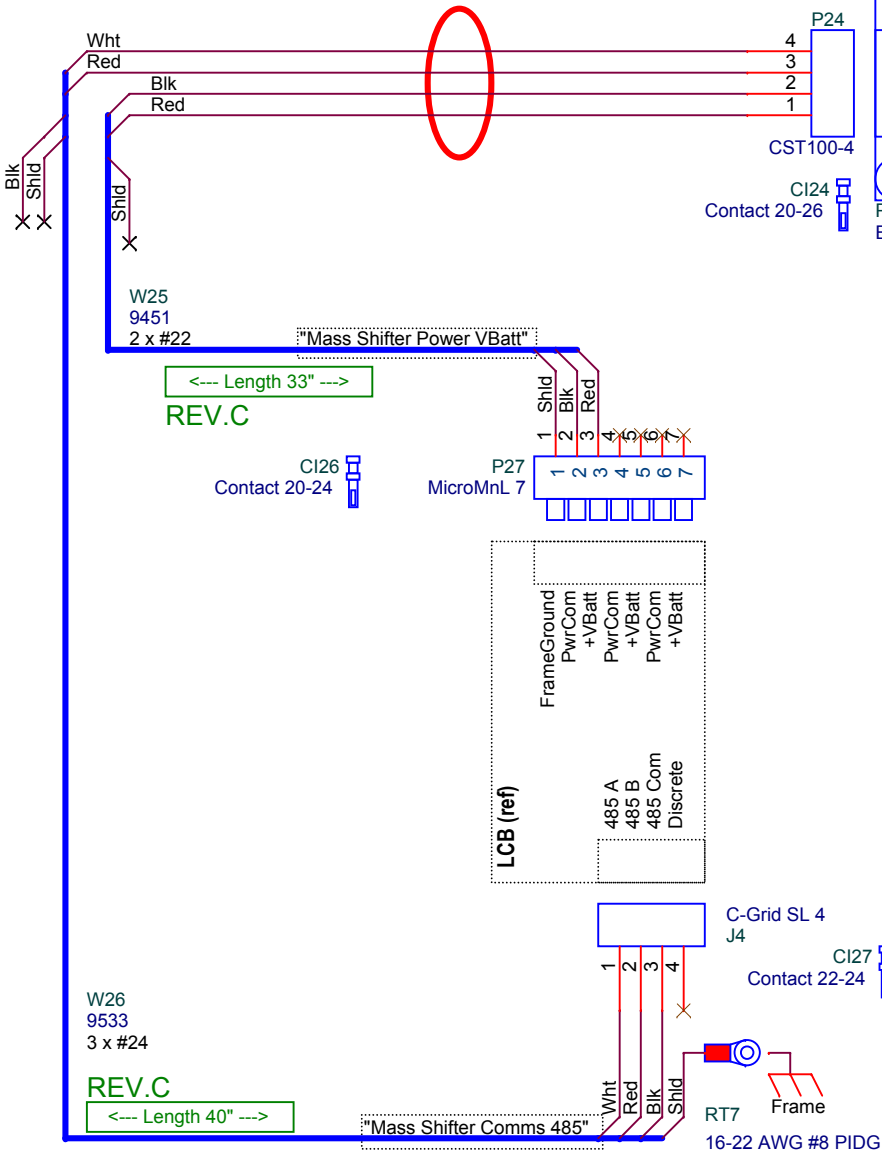

10021161-6-H2
HARNESS 10021161-6-H2

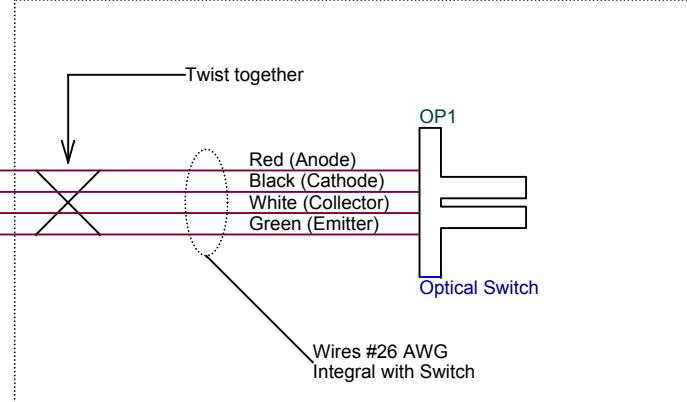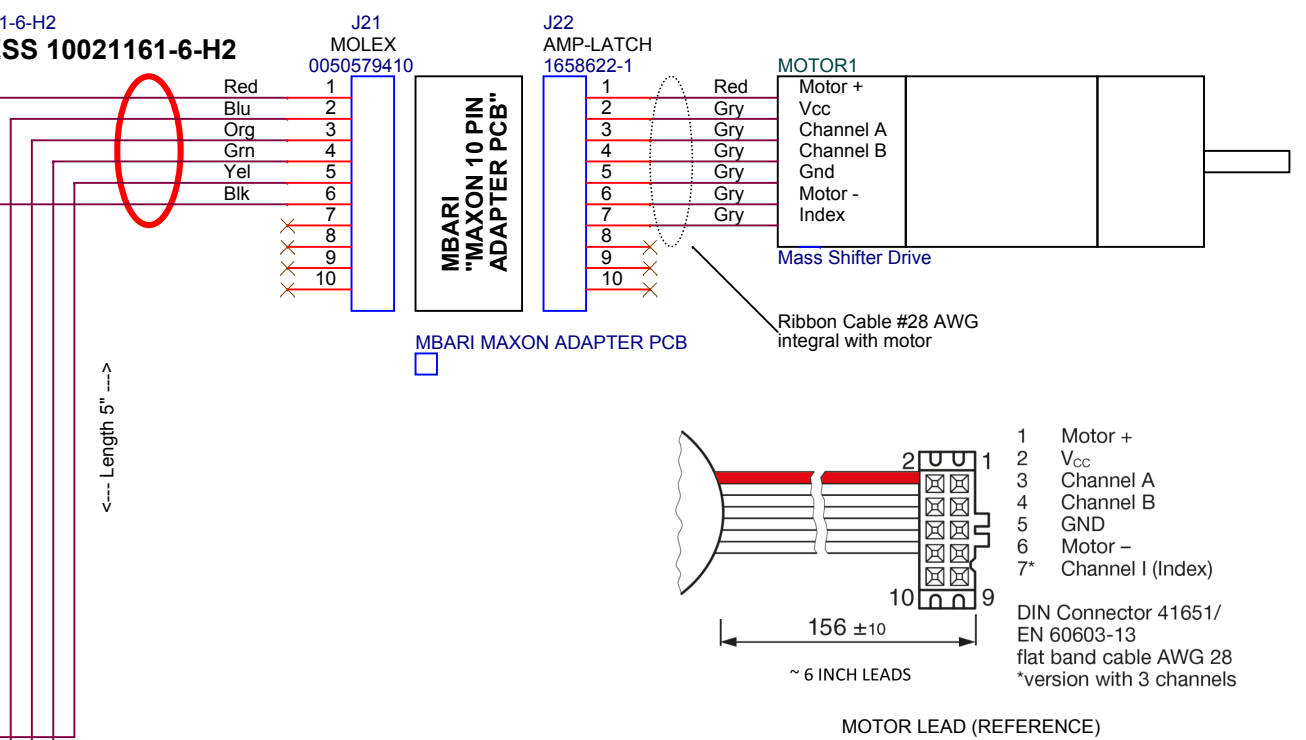

C	24 Jan 2018	PC	Changed LCB wire lengths. PWR: 39" to 33" ; COMS: 58" to 40".
B	20 JUN 2017	MRC	Added ECO to include adapter board for Maxon motor ribbon cable.
A	27 Jan 2016	ECM	Add lengths from redlines.
-	13 Feb 2015	ECM	Fork from Dwg 10020580 "Makai Pressure Vessel2-5"



Monterey Bay Aquarium Research Institute
7700 Sandholdt Road
Moss Landing, CA 95039
(831) 775-1700 www.mbari.org

MBARI proprietary information
(c) MBARI 2017
(c) MBARI 2015

Title Mass Shifter Wiring Fab, LRAUV Int Press Vess Wiring, Build5		Document Number 100221161	Rev C
Size B	Date: Tuesday, July 31, 2018	Engineer Mellinger	Sheet 6 of 15
Design File \\ATLAS\PROJECT\LIBRARY\901727.99_LRAUV5_BUILD\DESIGNDRAWINGS\EE_DRAWINGS\LRAUV\WIRING\SYSTEMWIRING\100221189_LRAUV_BUILD5_SYSTEMWIRINGDRAWING		Page Name 06 Mass Shifter Wiring Fab	
Schematic Name LRAUV5BuildInternalWiring		Layout File <Layout File>	