


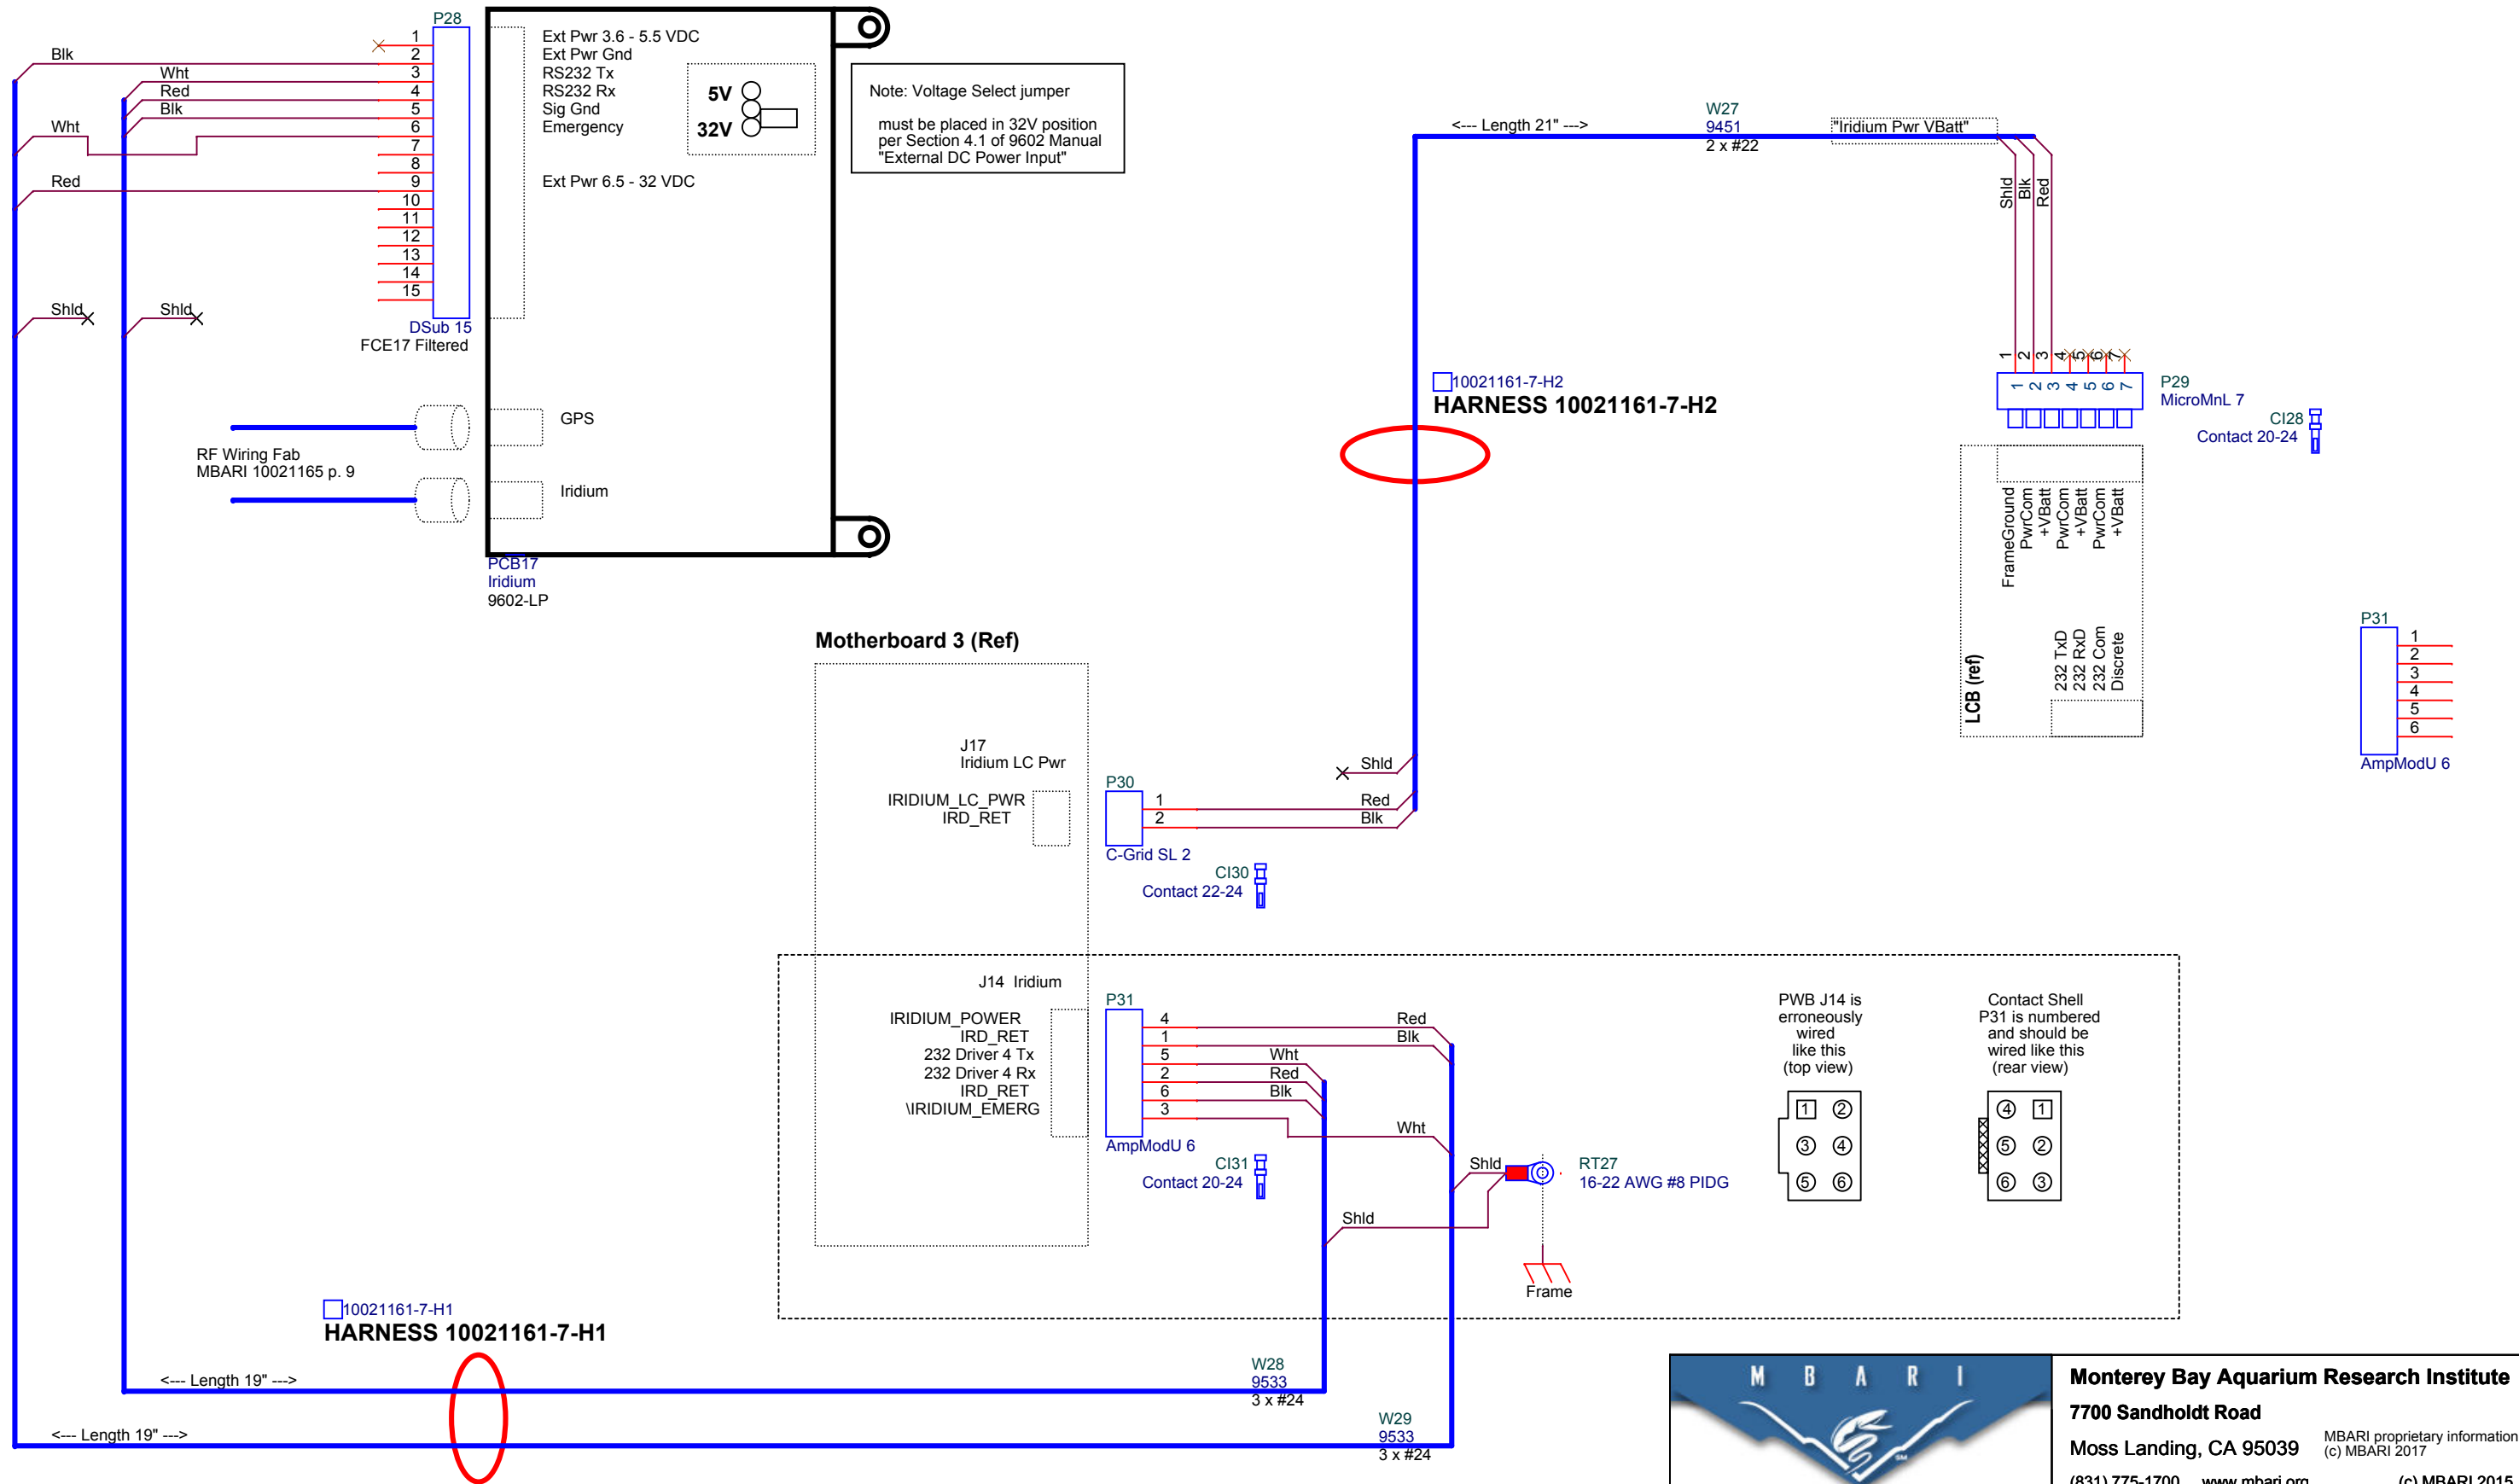

Monterey Bay Aquarium Research Institute
7700 Sandholdt Road
Moss Landing, CA 95039
(831) 775-1700 www.mbari.org

MBARI proprietary information
(c) MBARI 2017

(c) MBARI 2015

C	25 Jul 2017	ECM	Revise P31 to match manufacturer numbering scheme and adapt to existing CPU pinout
B	16 Mar 2016	ECM	Change P28 D-Sub to Amphenol FCE17 Filtered type; delete CI29 contact.
A	27 Jan 2016	ECM	Add lengths from redlines. Add ground lugs to Iridium cable shields. Add Voltage Select Jumper note.

Title NAL9602 Iridium Wiring Fab, LRAUV Int Press Vess Wiring, Build5		Document Number 100221161	Rev C
Size B	Date: Wednesday, July 26, 2017	Engineer Mellinger	Sheet 7 of 15
Design File \\ATLAS\PROJECT\LIBRARY\LRAUV\DRAWINGS\IEEL\RAUV\WIRING\SYSTEM\WIRING\100221189_LRAUV_BUILD5_SYSTEM\WIRING\DRAWINGSET.DSN		Page Name 07 NAL9602 Iridium Wiring Fab	
Schematic Name LRAUV5BuildInternalWiring		Layout File <Layout File>	