


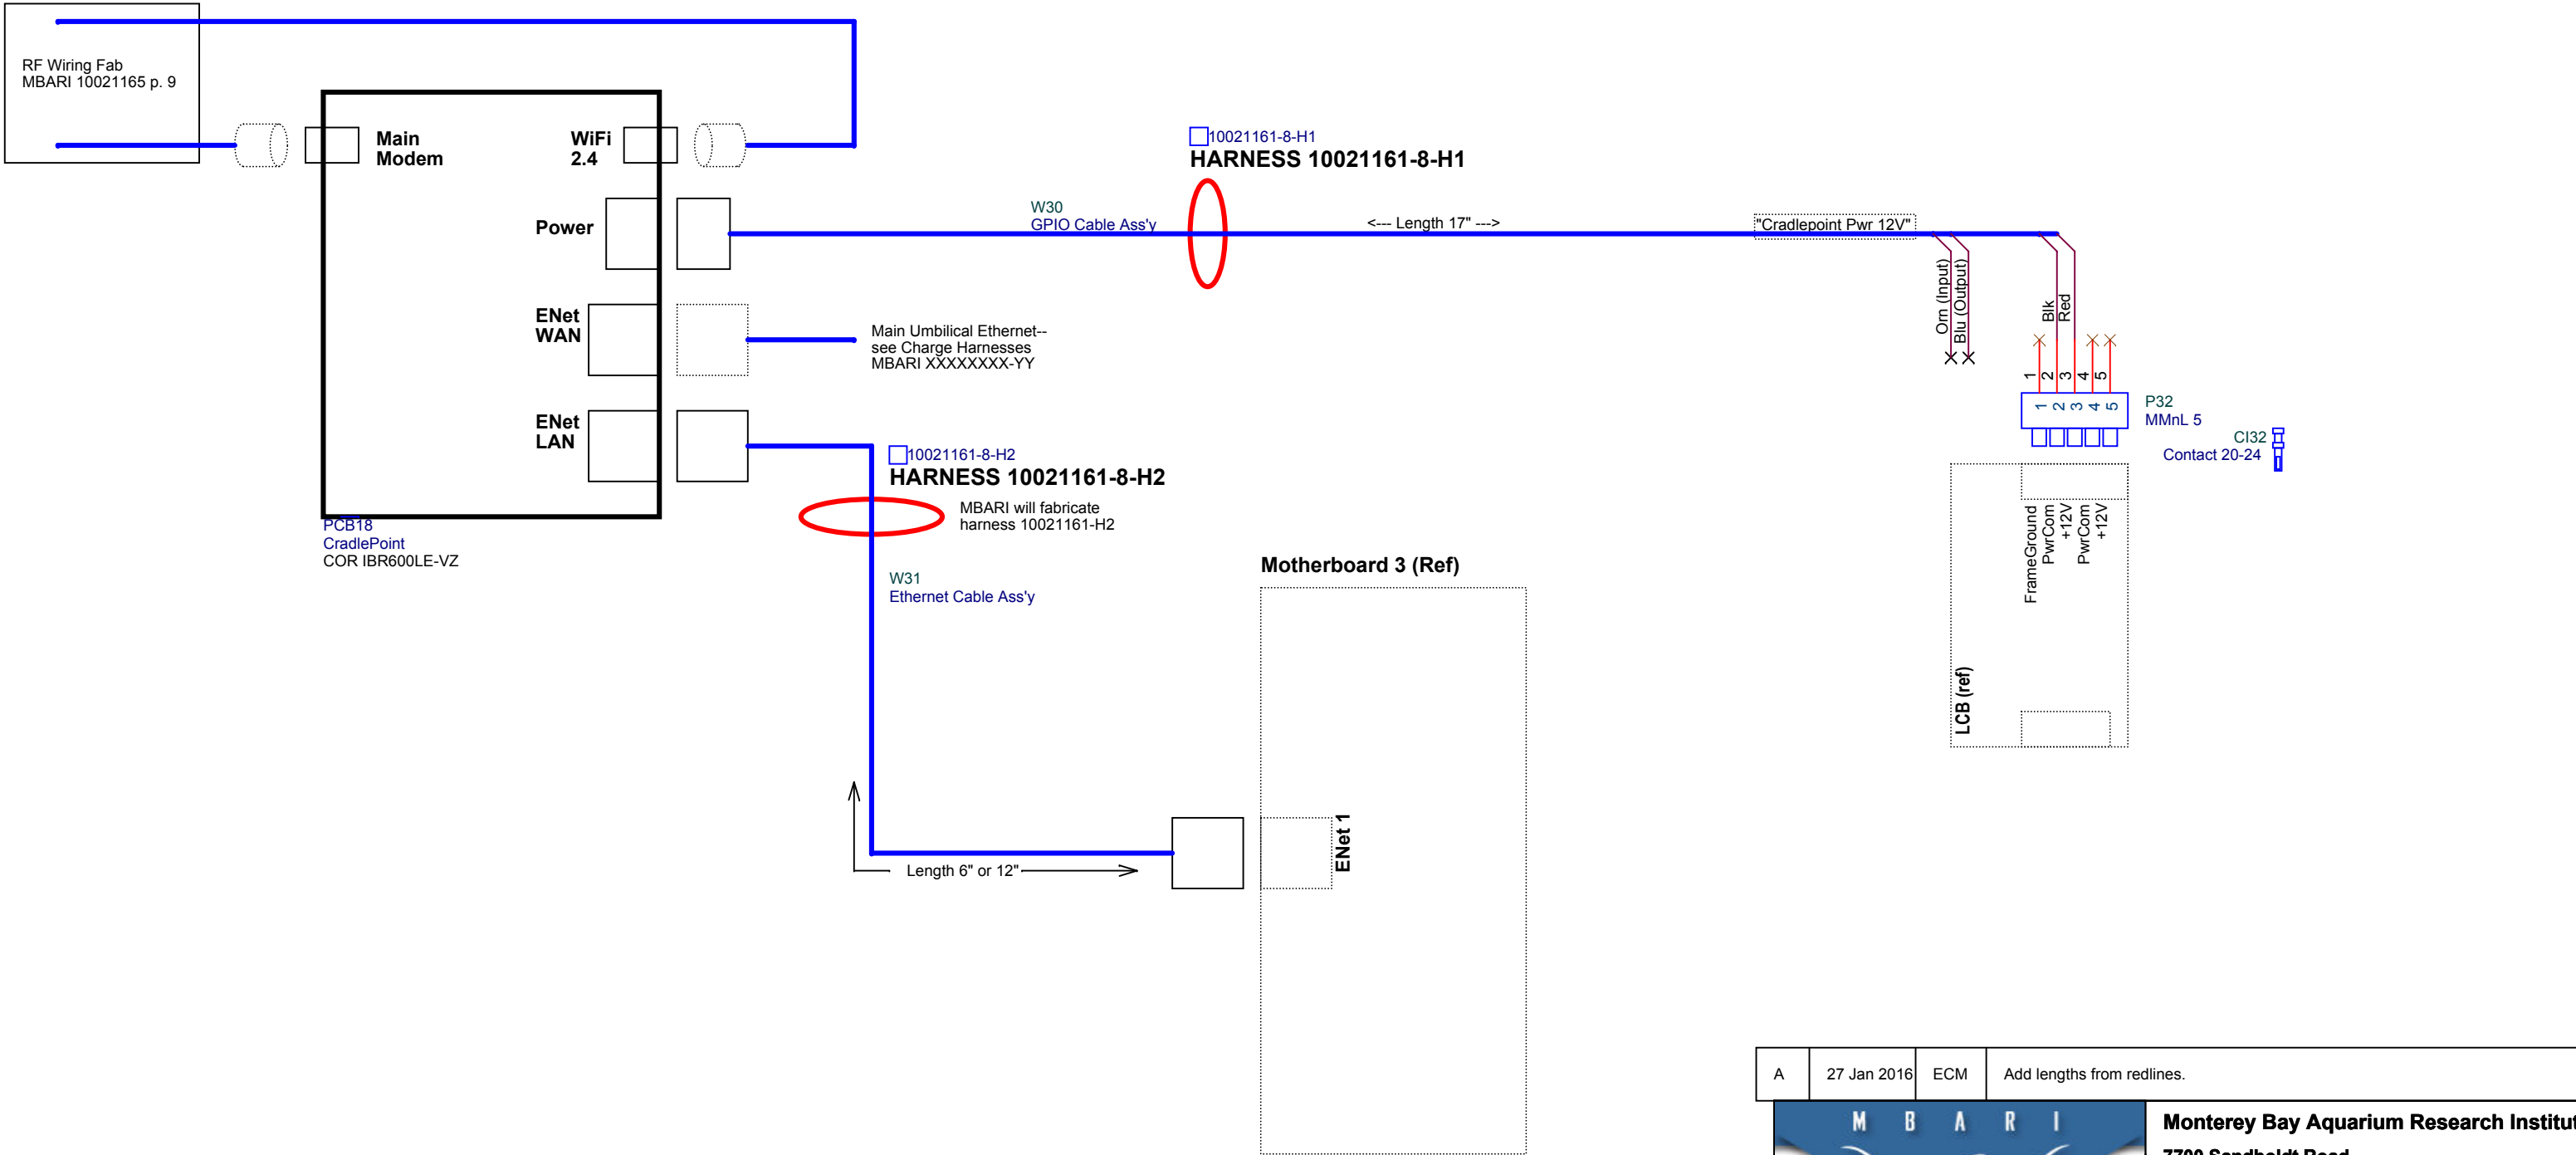

A	27 Jan 2016	ECM	Add lengths from redlines.	
			Monterey Bay Aquarium Research Institute 7700 Sandholdt Road Moss Landing, CA 95039 (831) 775-1700 www.mbari.org	MBARI proprietary information (c) MBARI 2017 (c) MBARI 2015
Title		Document Number		Rev
Cradlepoint 3G/WiFi Wiring Fab, LRAUV Int Press Vess Wiring, Daphne		100221161		A
Size	Date:	Engineer	Sheet	of
B	Wednesday, July 26, 2017	Mellinger	8	15
Design File \\ATLAS\PROJECT\LIBRARY\LRAUV\DRAWINGS\IEEL\LRAUV\WIRING\SYSTEM\WIRING\100221189_LRAUV_BUILD5_SYSTEM\WIRING\DRAWINGSET.DSN				
Schematic Name		Page Name	Layout File	
LRAUV5BuildInternalWiring		08 Cradlepoint 3G/WiFi Wiring	<Layout File>	