


Motherboard 3 (Ref)

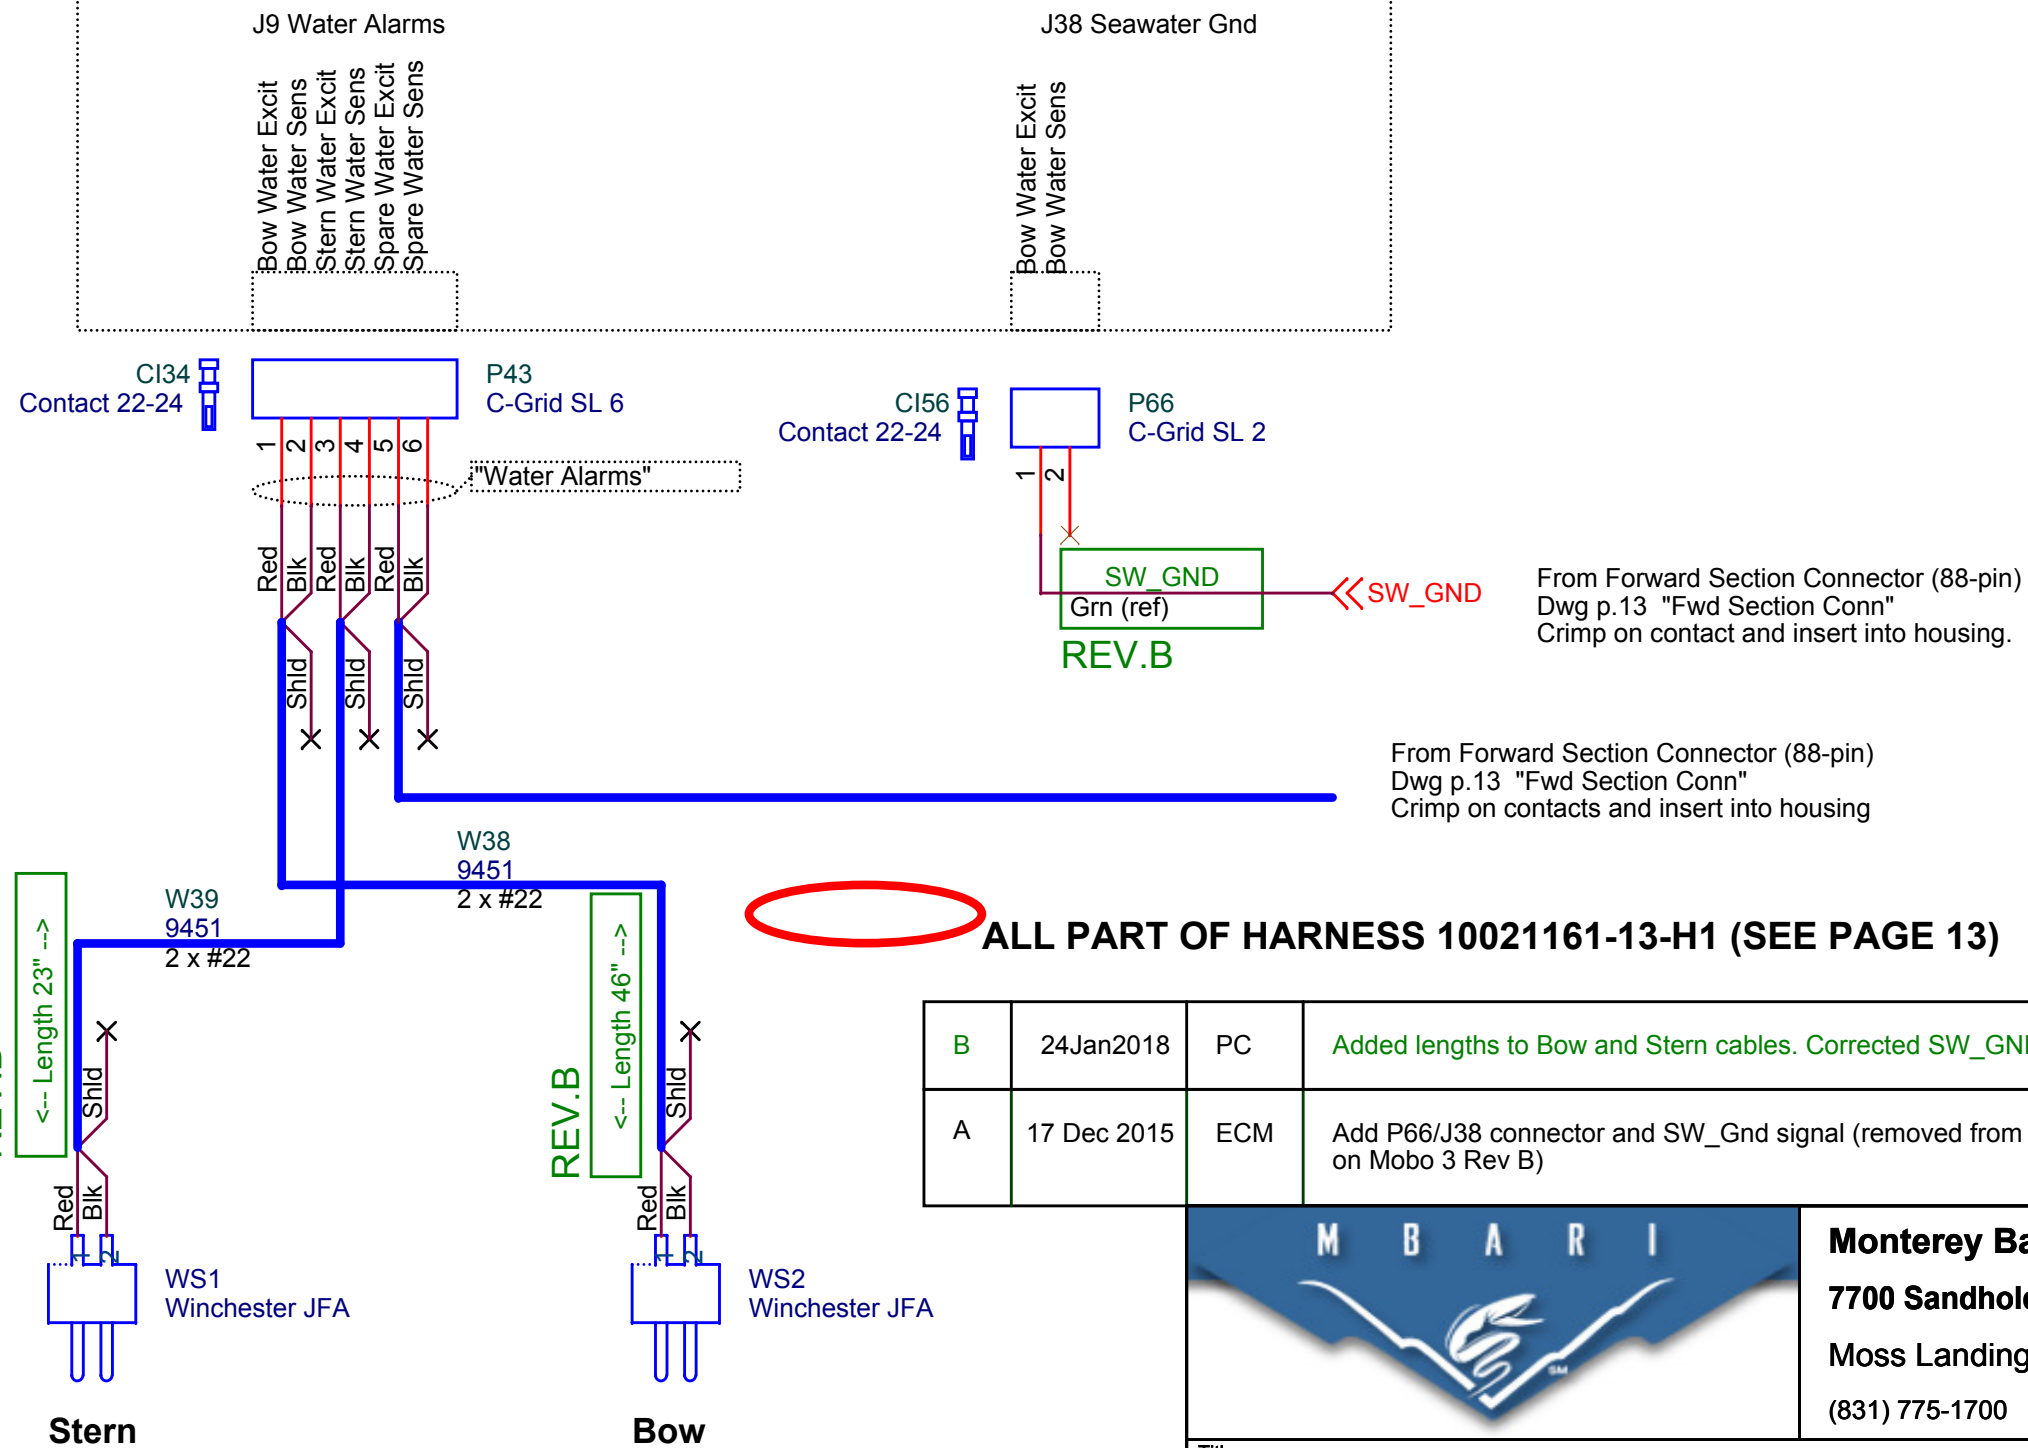

ALL PART OF HARNESS 10021161-13-H1 (SEE PAGE 13)

B	24Jan2018	PC	Added lengths to Bow and Stern cables. Corrected SW_GND net name.		
A	17 Dec 2015	ECM	Add P66/J38 connector and SW_Gnd signal (removed from Mobo J33 and given its own connector on Mobo 3 Rev B)		
			Monterey Bay Aquarium Research Institute 7700 Sandholdt Road Moss Landing, CA 95039 (831) 775-1700 www.mbari.org MBARI proprietary information (c) MBARI 2017 (c) MBARI 2015		
Title			Document Number		Rev
Water Alarm/GF Wiring Fab, LRAUV Int Press Vess Wiring, Build5			100221161		B
Size	Date:	Engineer	Sheet		of
A	Thursday, August 02, 2018	Mellinger	11		15
Design File					
X:\901727.99_LRAUV5_BUILD\DESIGNDRAWINGS\IEE_DRAWINGS\LRAUVWIRING\SYSTEMWIRING\100221189_LRAUV_BUILD5_SYSTEMWIRINGDRAWINGSET.DSN					
Schematic Name		Page Name	Layout File		
LRAUV5BuildInternalWiring		11P Water Alarm/GF Wiring Fab	<Layout File>		