
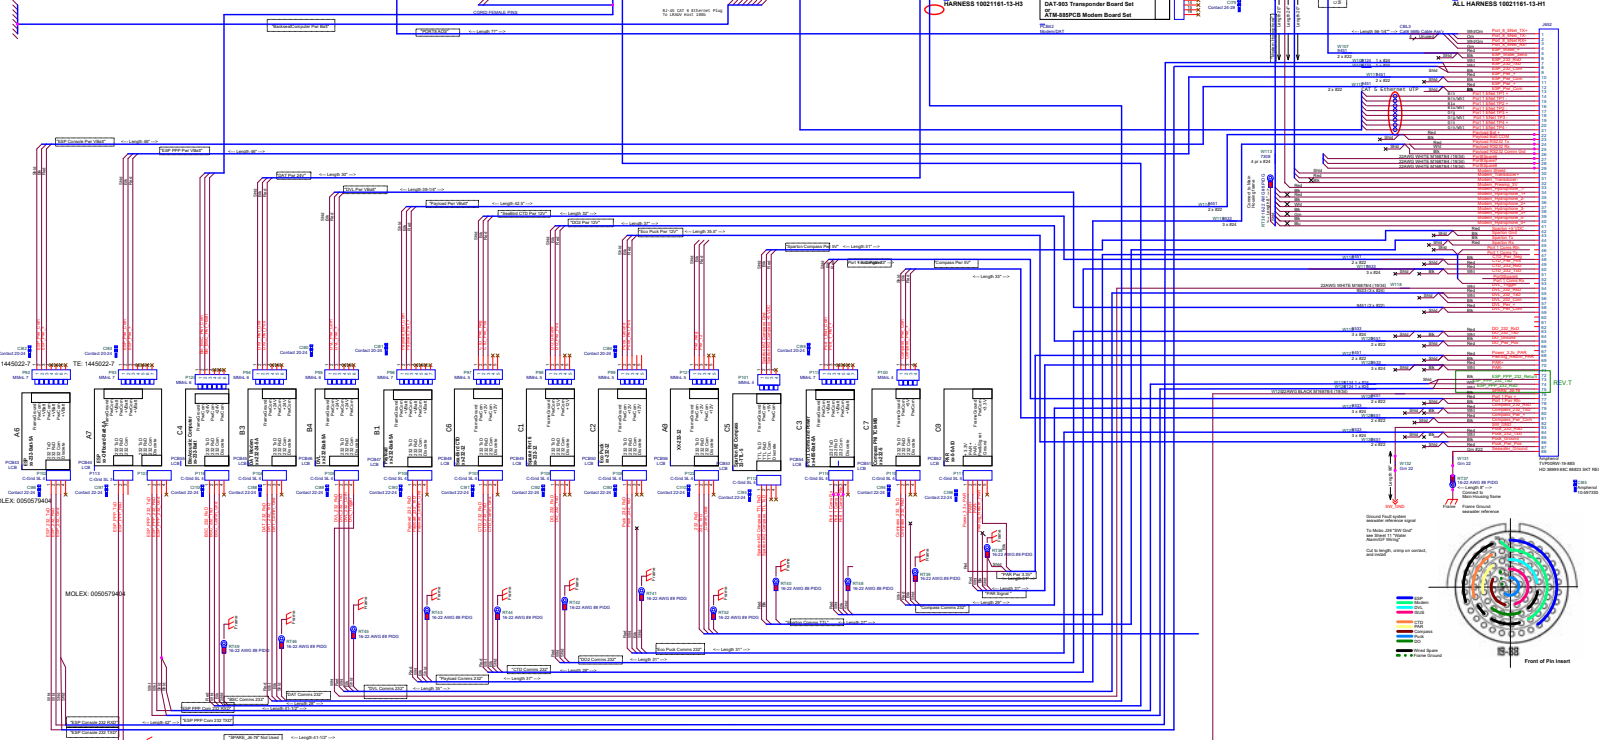
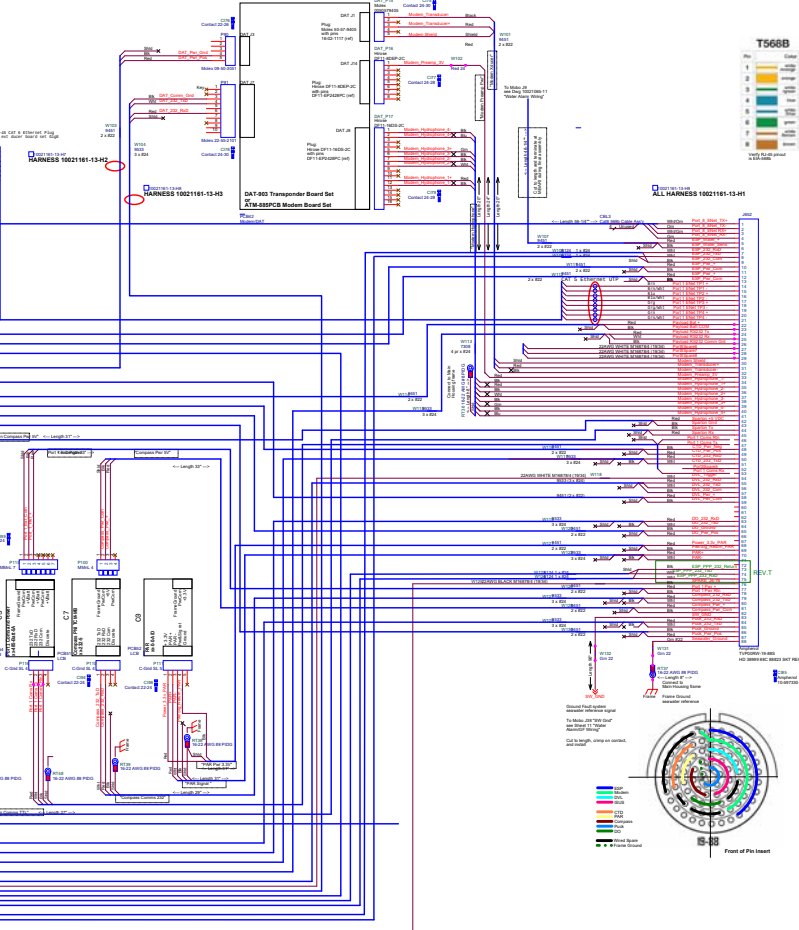


T000:

- update connectors
- check r/r/x on connector
- what LC voltage/current?

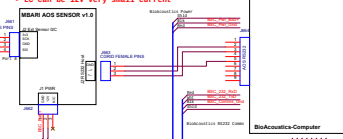

NOTE: Board position on drawing does not correspond to board position in vehicle. See vehicle-specific config doc.

Rev	Date	Author	Description	Rev	Date	Author	Description	Rev	Date	Author	Description




