


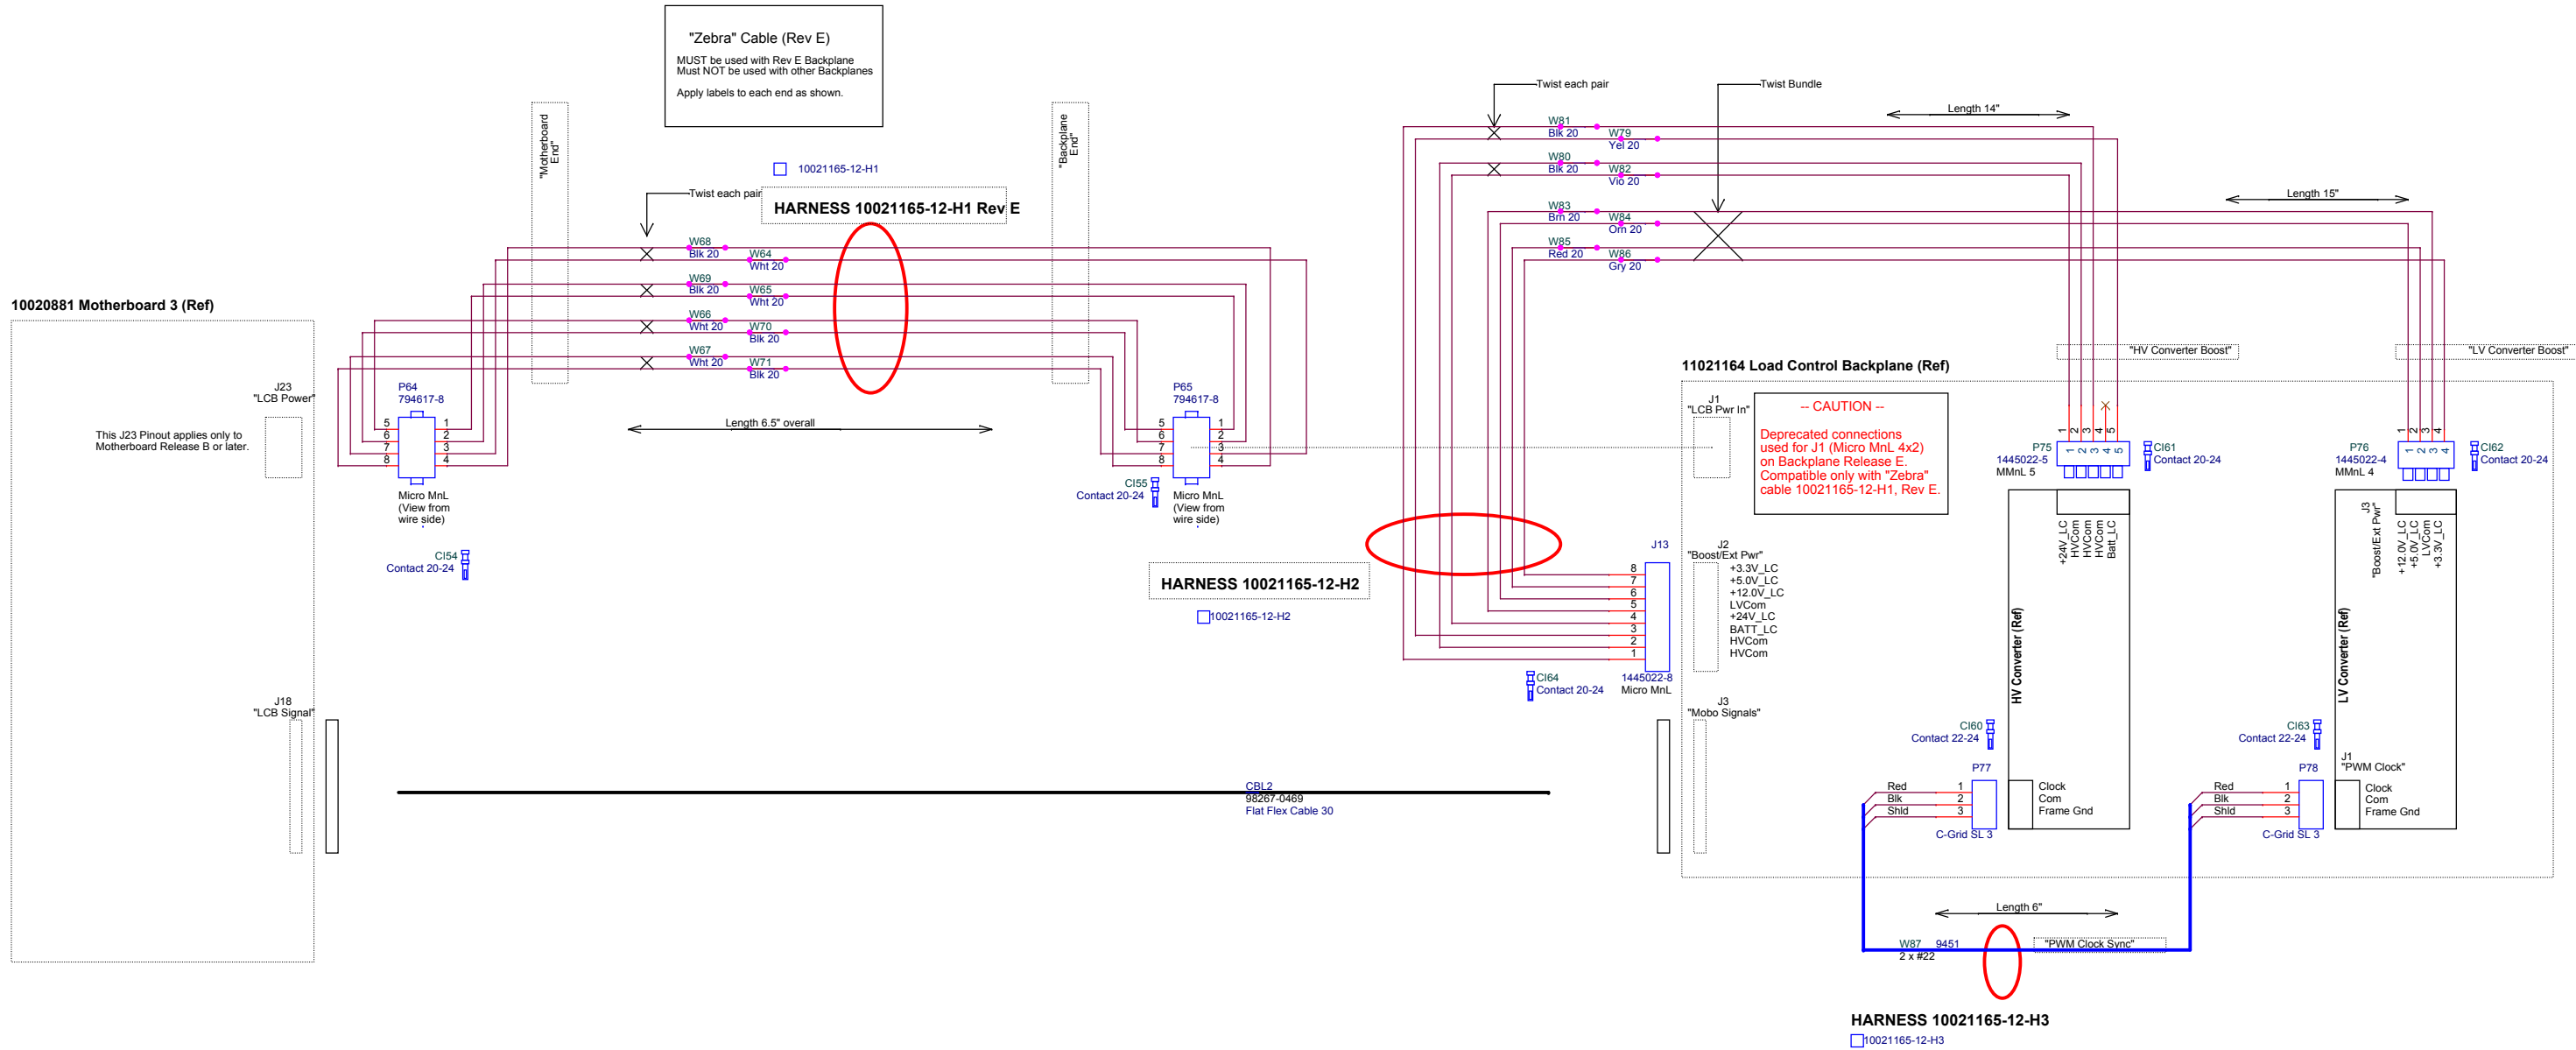

E	2018-May-24	ECM	Change H1 "Zebra" cable to match Rev E Backplane Change P75 HV Converter Boost pinout to match HV Converter as-built
D	2017-May-5	ECM	Add cable lengths, correct J13 callout
C	2016-May-11	ECM	Add Converter Boost and PWM Clock Cables
B	2015-Oct-22	ECM	Change flat flex cable CBL2 to 3" length
A	2015-Sep-10	ECM	move Test Cable to separate Schematic



Monterey Bay Aquarium Research Institute
7700 Sandholdt Road
Moss Landing, CA 95039
(831) 775-1700 www.mbari.org (c) MBARI 2015

Title Load Control Backplane Wiring Fab, LRAUV Int Press Vess Wiring, Build5		Document Number 10021165	Rev E
Size Custom	Date: Thursday, May 24, 2018	Engineer Mollinger	Sheet 12 of 15
Design File O:\DRAWINGS\ELRAUV\WIRING\SYSTEM\WIRING\10021165_LRAUV_BUILD5_SYSTEM\WIRING\DRAWINGSET.DSN			
Schematic Name LRAUVBuildInternalWiring		Page Name 12 Ld Cbl Backplane Wiring Fab	Layout File <Layout File>