


| | | | |
|---|---|---|---|
| C | 25 Jul 2017 | ECM | Revise P31 to match manufacturer numbering scheme and adapt to existing CPU pinout |
| B | 16 Mar 2016 | ECM | Change P28 D-Sub to Amphenol FCE17 Filtered type; delete CI29 contact. |
| A | 27 Jan 2016 | ECM | Add lengths from redlines. Add ground lugs to Iridium cable shields. Add Voltage Select Jumper note. |


**Monterey Bay Aquarium Research Institute**
7700 Sandholdt Road
Moss Landing, CA 95039
(831) 775-1700 www.mbari.org

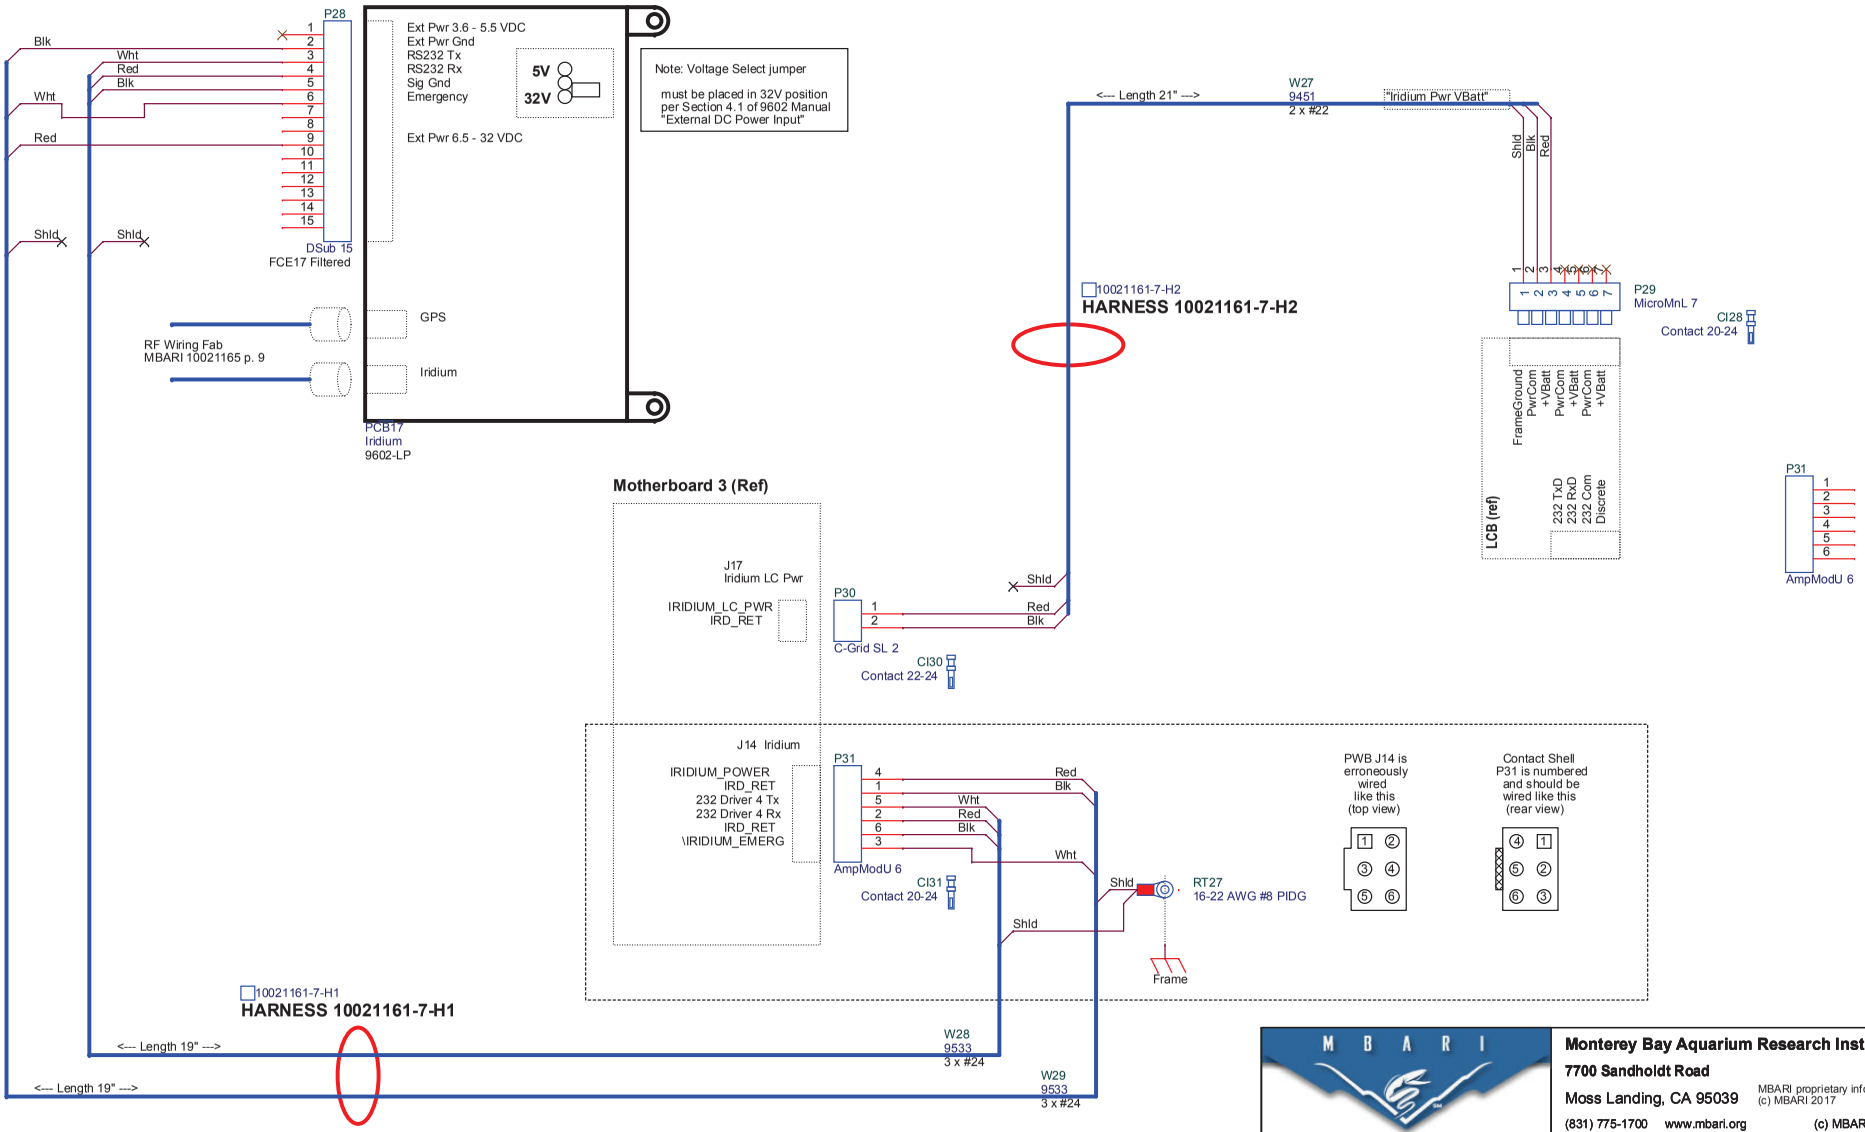

MBARI proprietary information
(c) MBARI 2017
(c) MBARI 2015


Title: **NAL9602 Iridium Wiring Fab, LRAUV Int Press Vess Wiring, Build5**

Document Number: **100221161** Rev: **C**

Size: **B** Date: **Wednesday, July 26, 2017** Engineer: **Mellinger** Sheet **7** of **15**

Design File: X:\LRAUV5\DRAWINGS\EE\LRAUVWIRING\SYSTEMWIRING\100221189_LRAUV_BUILD5_SYSTEMWIRINGDRAWINGSET.DSN

Schematic Name: LRAUV5BuildInternalWiring | Page Name: 07 NAL9602 Iridium Wiring Fab | Layout File: <Layout File>