


CounterA - CounterB = 0.9V
CounterB = -1.402V

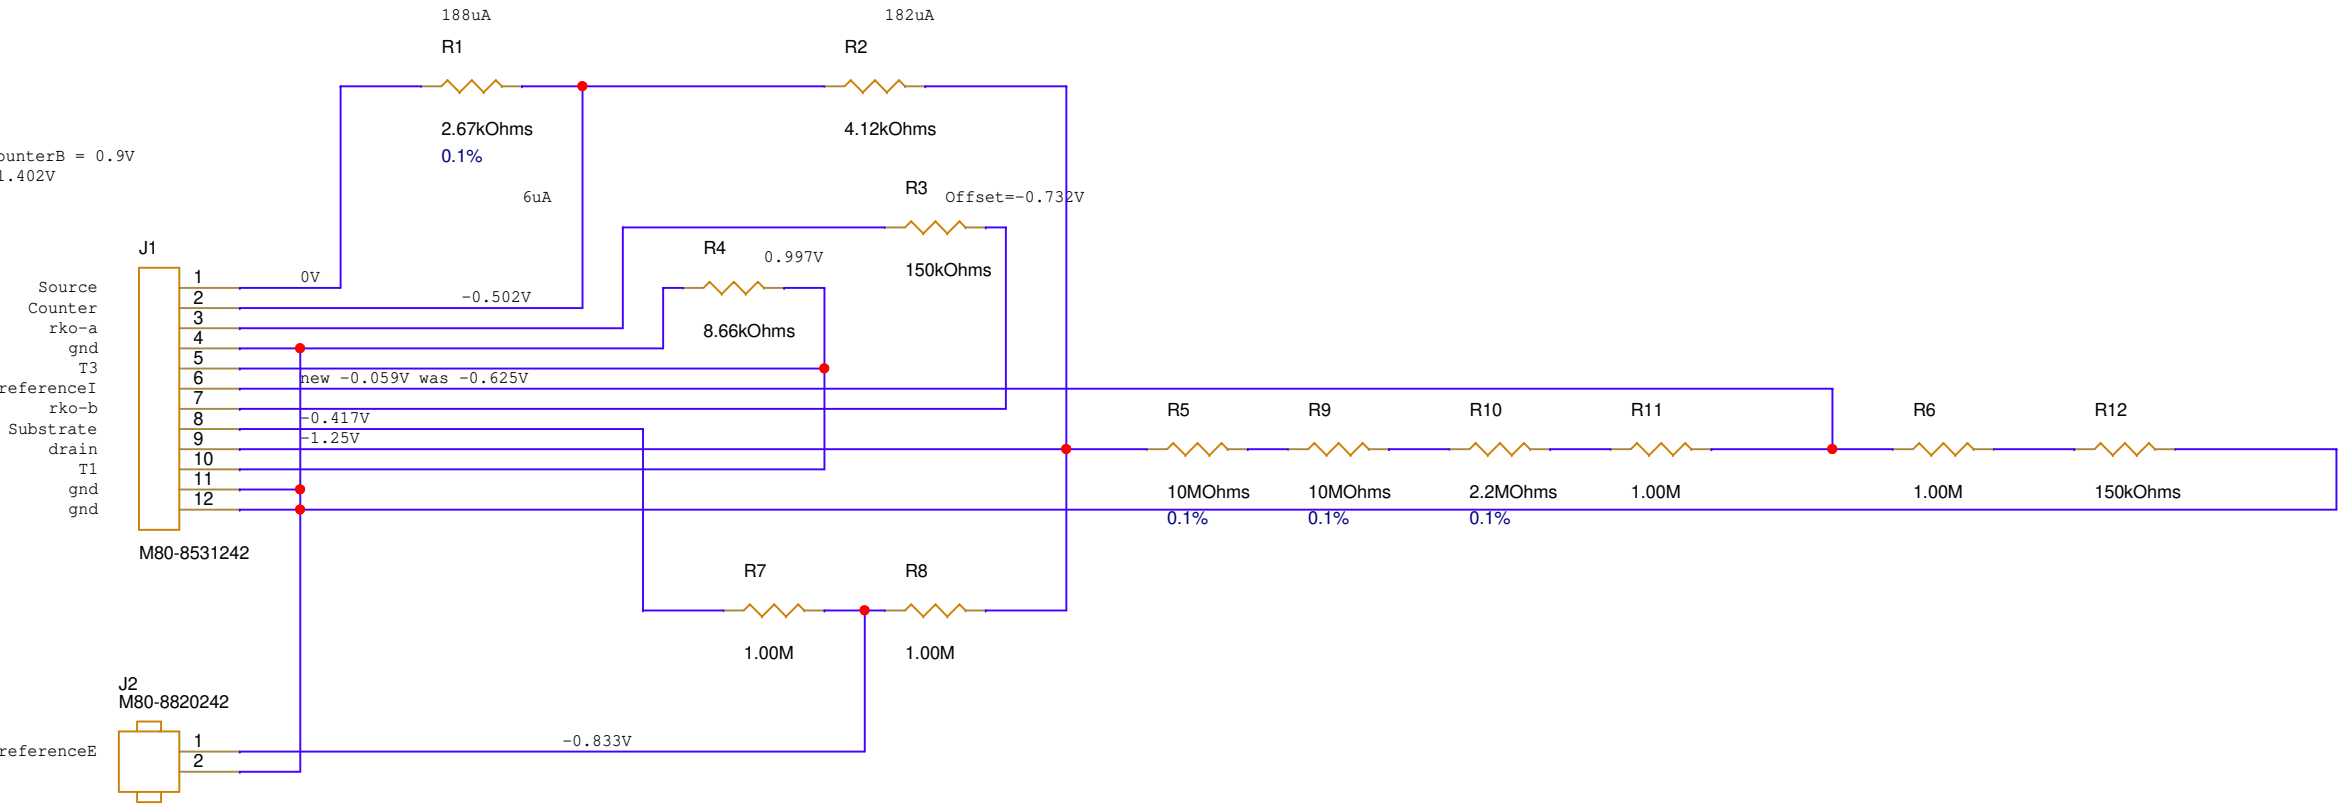

Schematic Name: MCAP Tester			
Page Title: MCAP Tester			Engineer: Sjensen
Project Name: Coastal Biogeochemical Sensing			Designer: Sjensen
Group Name: Coastal Biogeochemical Sensing	System: MCAP	Subsystem: MCAP	Last Updated By: sjensen
Drawing Number: 100221509		Release: A	Version: 9
Page Modify Date: Wednesday, February 17, 2021		Check In Date: 2/17/2021 8:57:41 AM	
		Status: Active	Size: B
Sheet 1 of 1			