

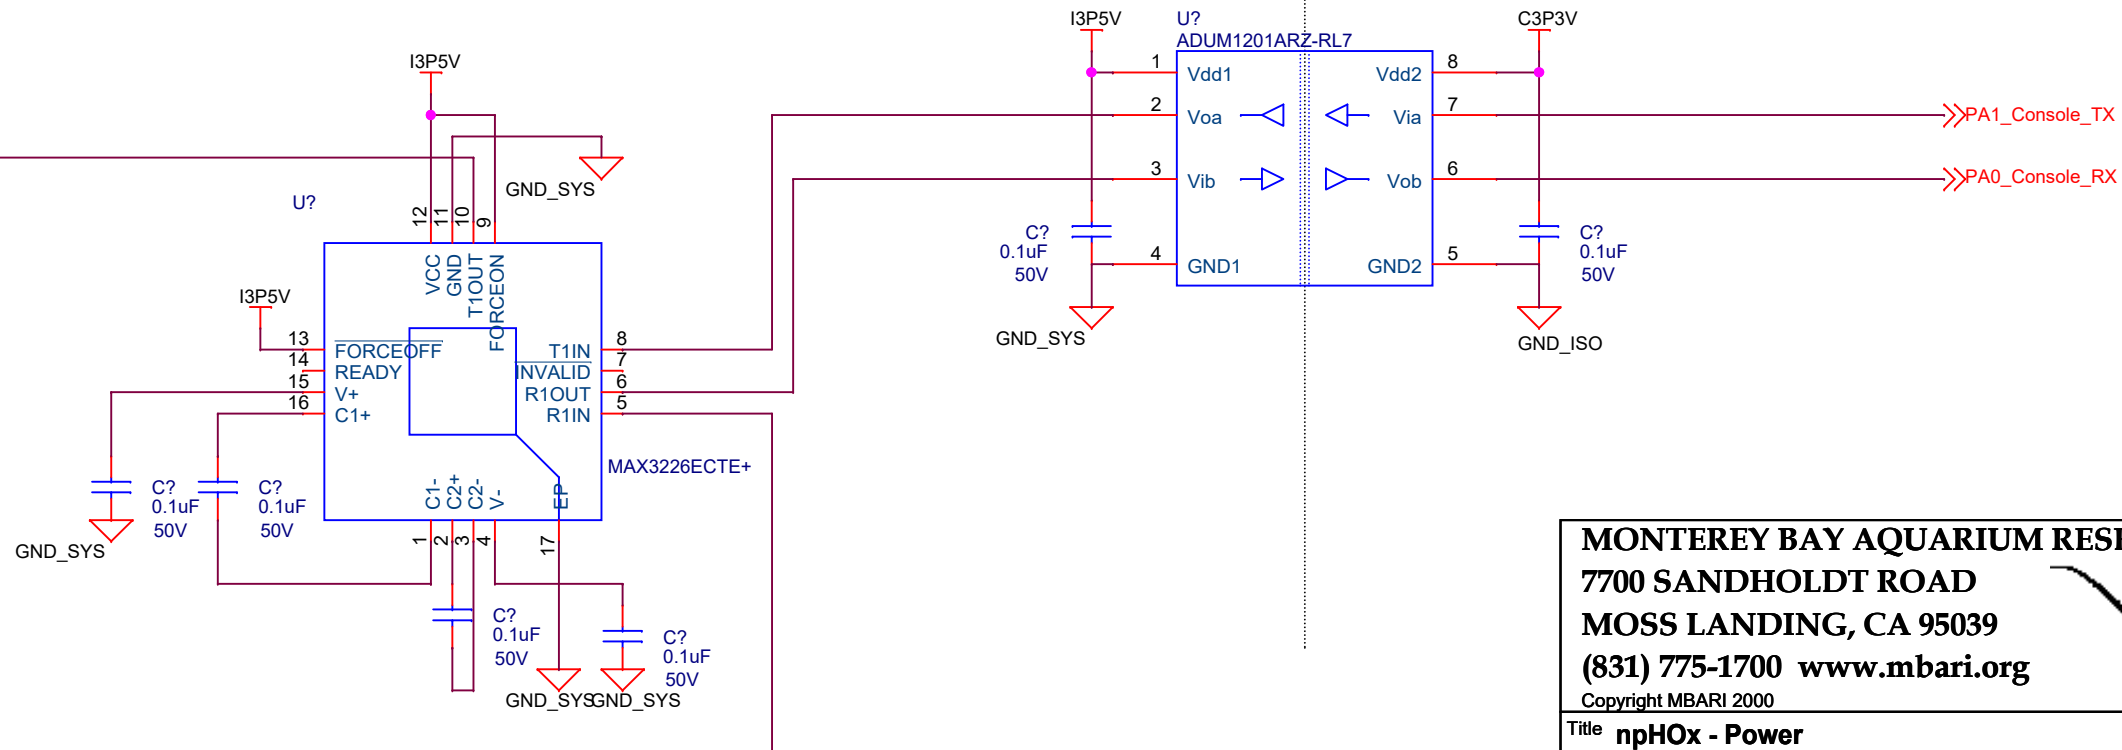


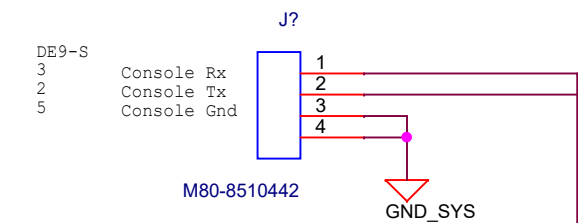

MONTEREY BAY AQUARIUM RESEARCH INSTITUTE 7700 SANDHOLDT ROAD MOSS LANDING, CA 95039 (831) 775-1700 www.mbari.org Copyright MBARI 2000					
Title npHOx - Power			Number <Doc>		
Size B	Engineer SJensen	Path npHOx	Filename MFET.opj		Rev A
	Date: Monday, January 27, 2020		Sheet 1 of 7		

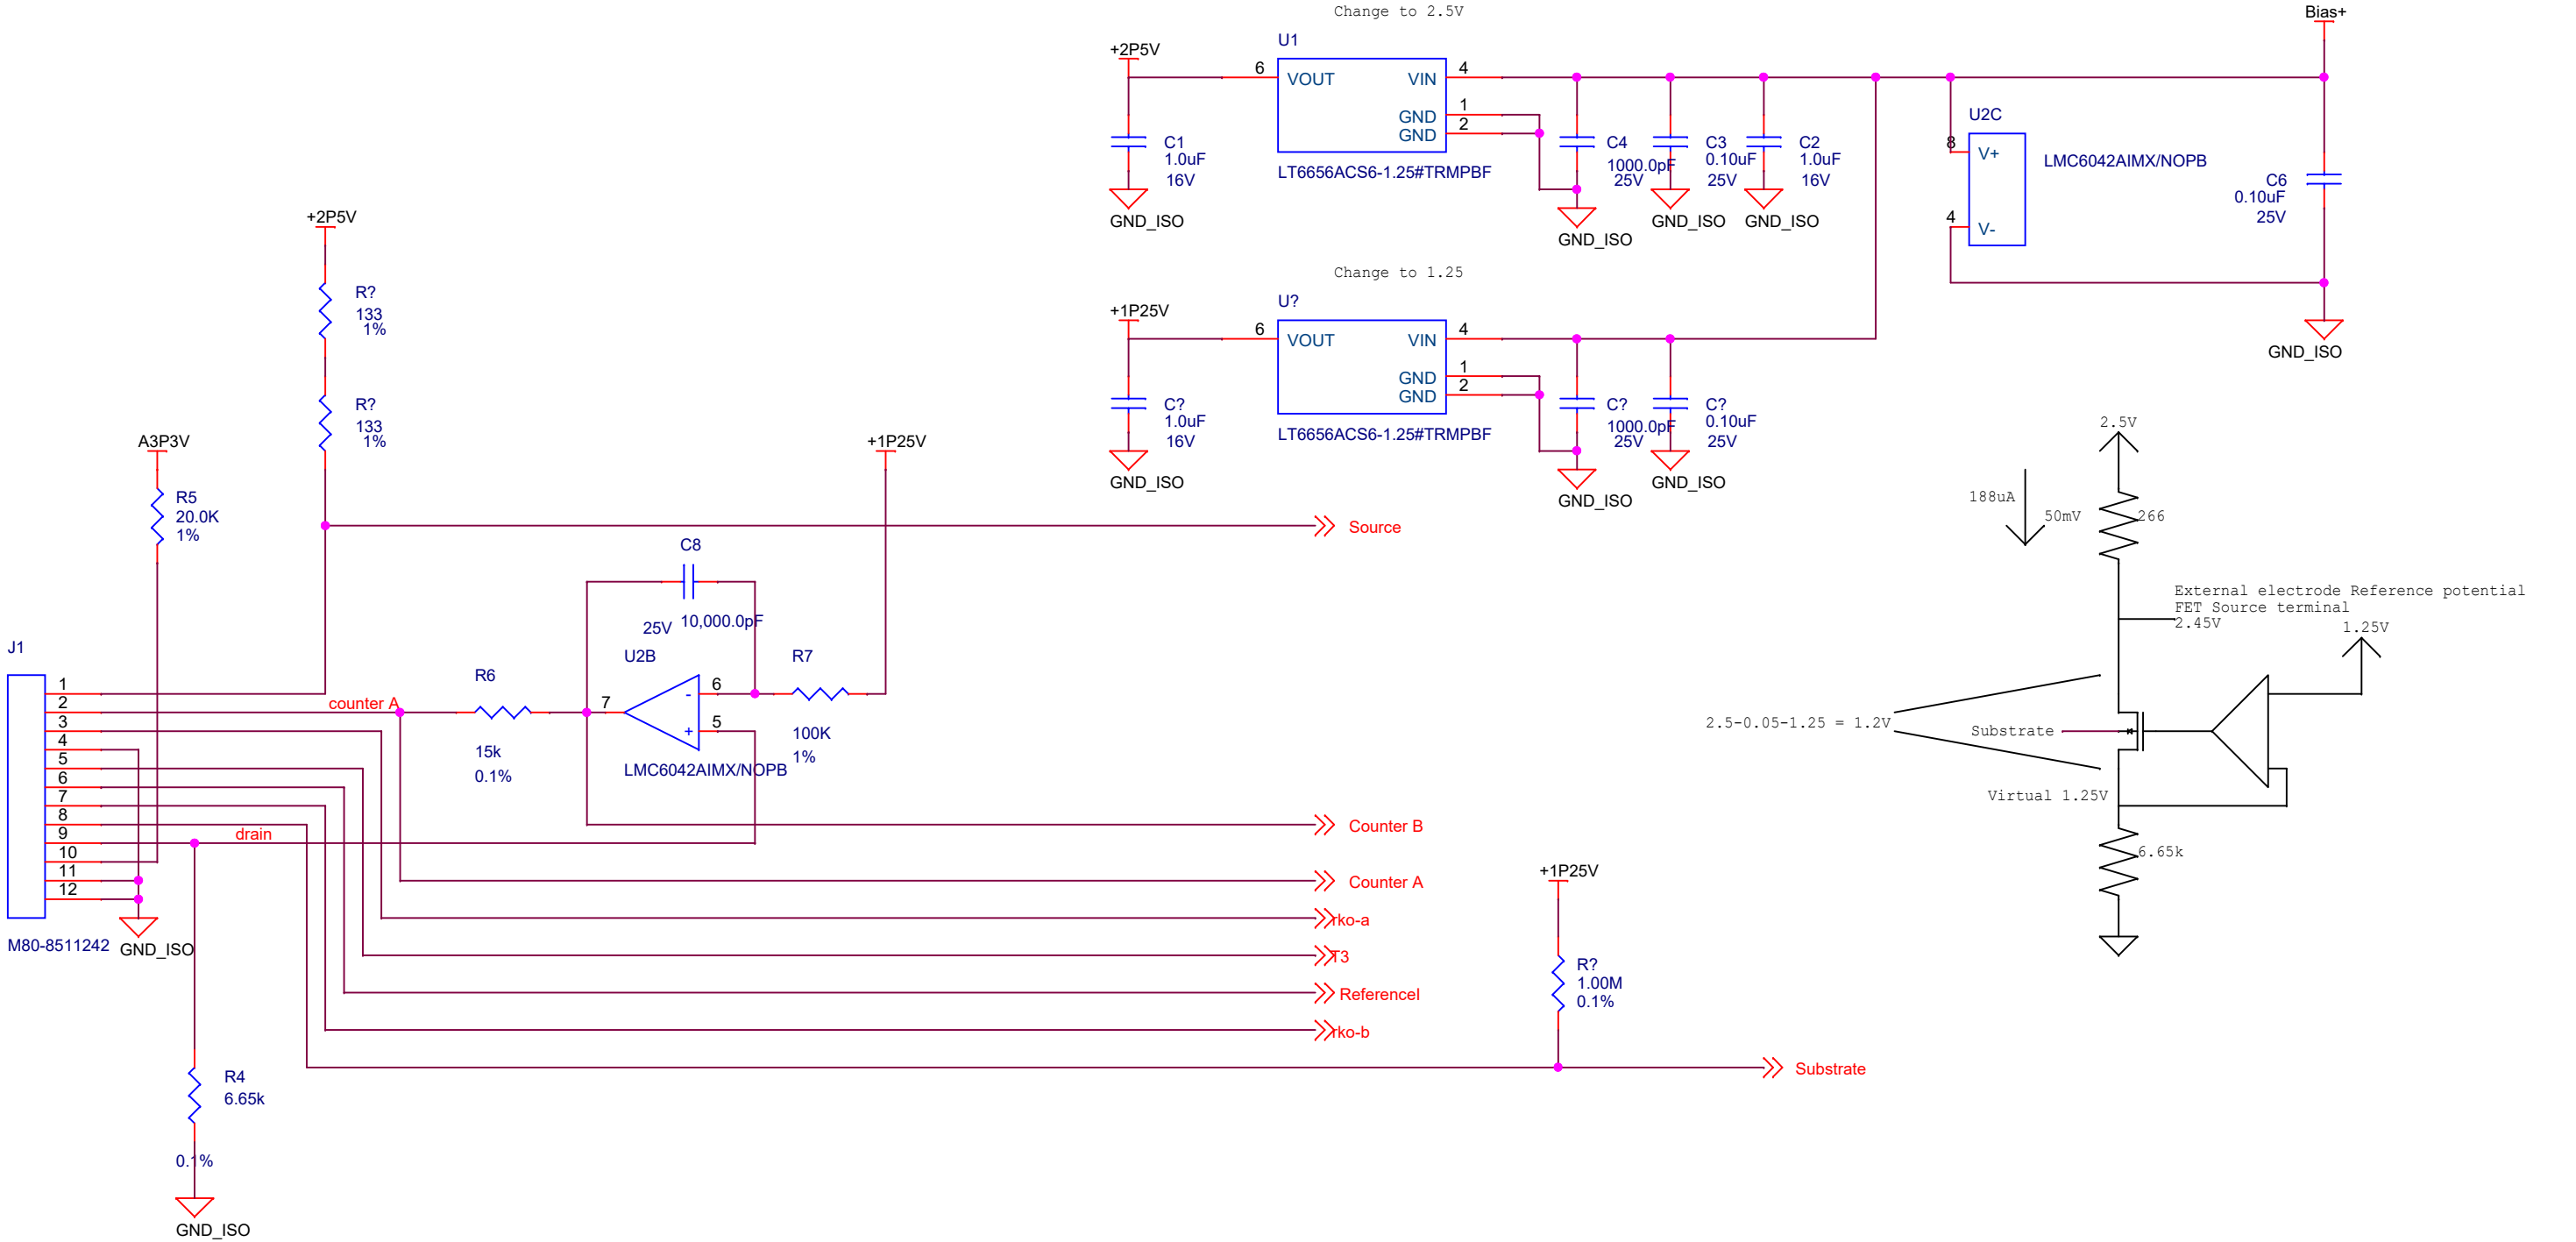

J1	Name	Color
1	Source	Orange
2	Counter A	White/Black
3	rko-a	Green
4	T1	Red/Black
5	T3	Orange/Black
6	Reference	Black
7	rko-b	Green/Black
8	Substrate	Red
9	Drain	Brown
10	T2	White

MONTEREY BAY AQUARIUM RESEARCH INSTITUTE

7700 SANDHOLDT ROAD


MOSS LANDING, CA 95039


(831) 775-1700 www.mbari.org

Copyright MBARI 2000






Title npHOx - Bias		Number 100221250rA		
Size B	Engineer SJensen	Path <Path>	Filename MCAP.opj	Rev
	Date: Monday, January 27, 2020		Sheet 1 of 5	C

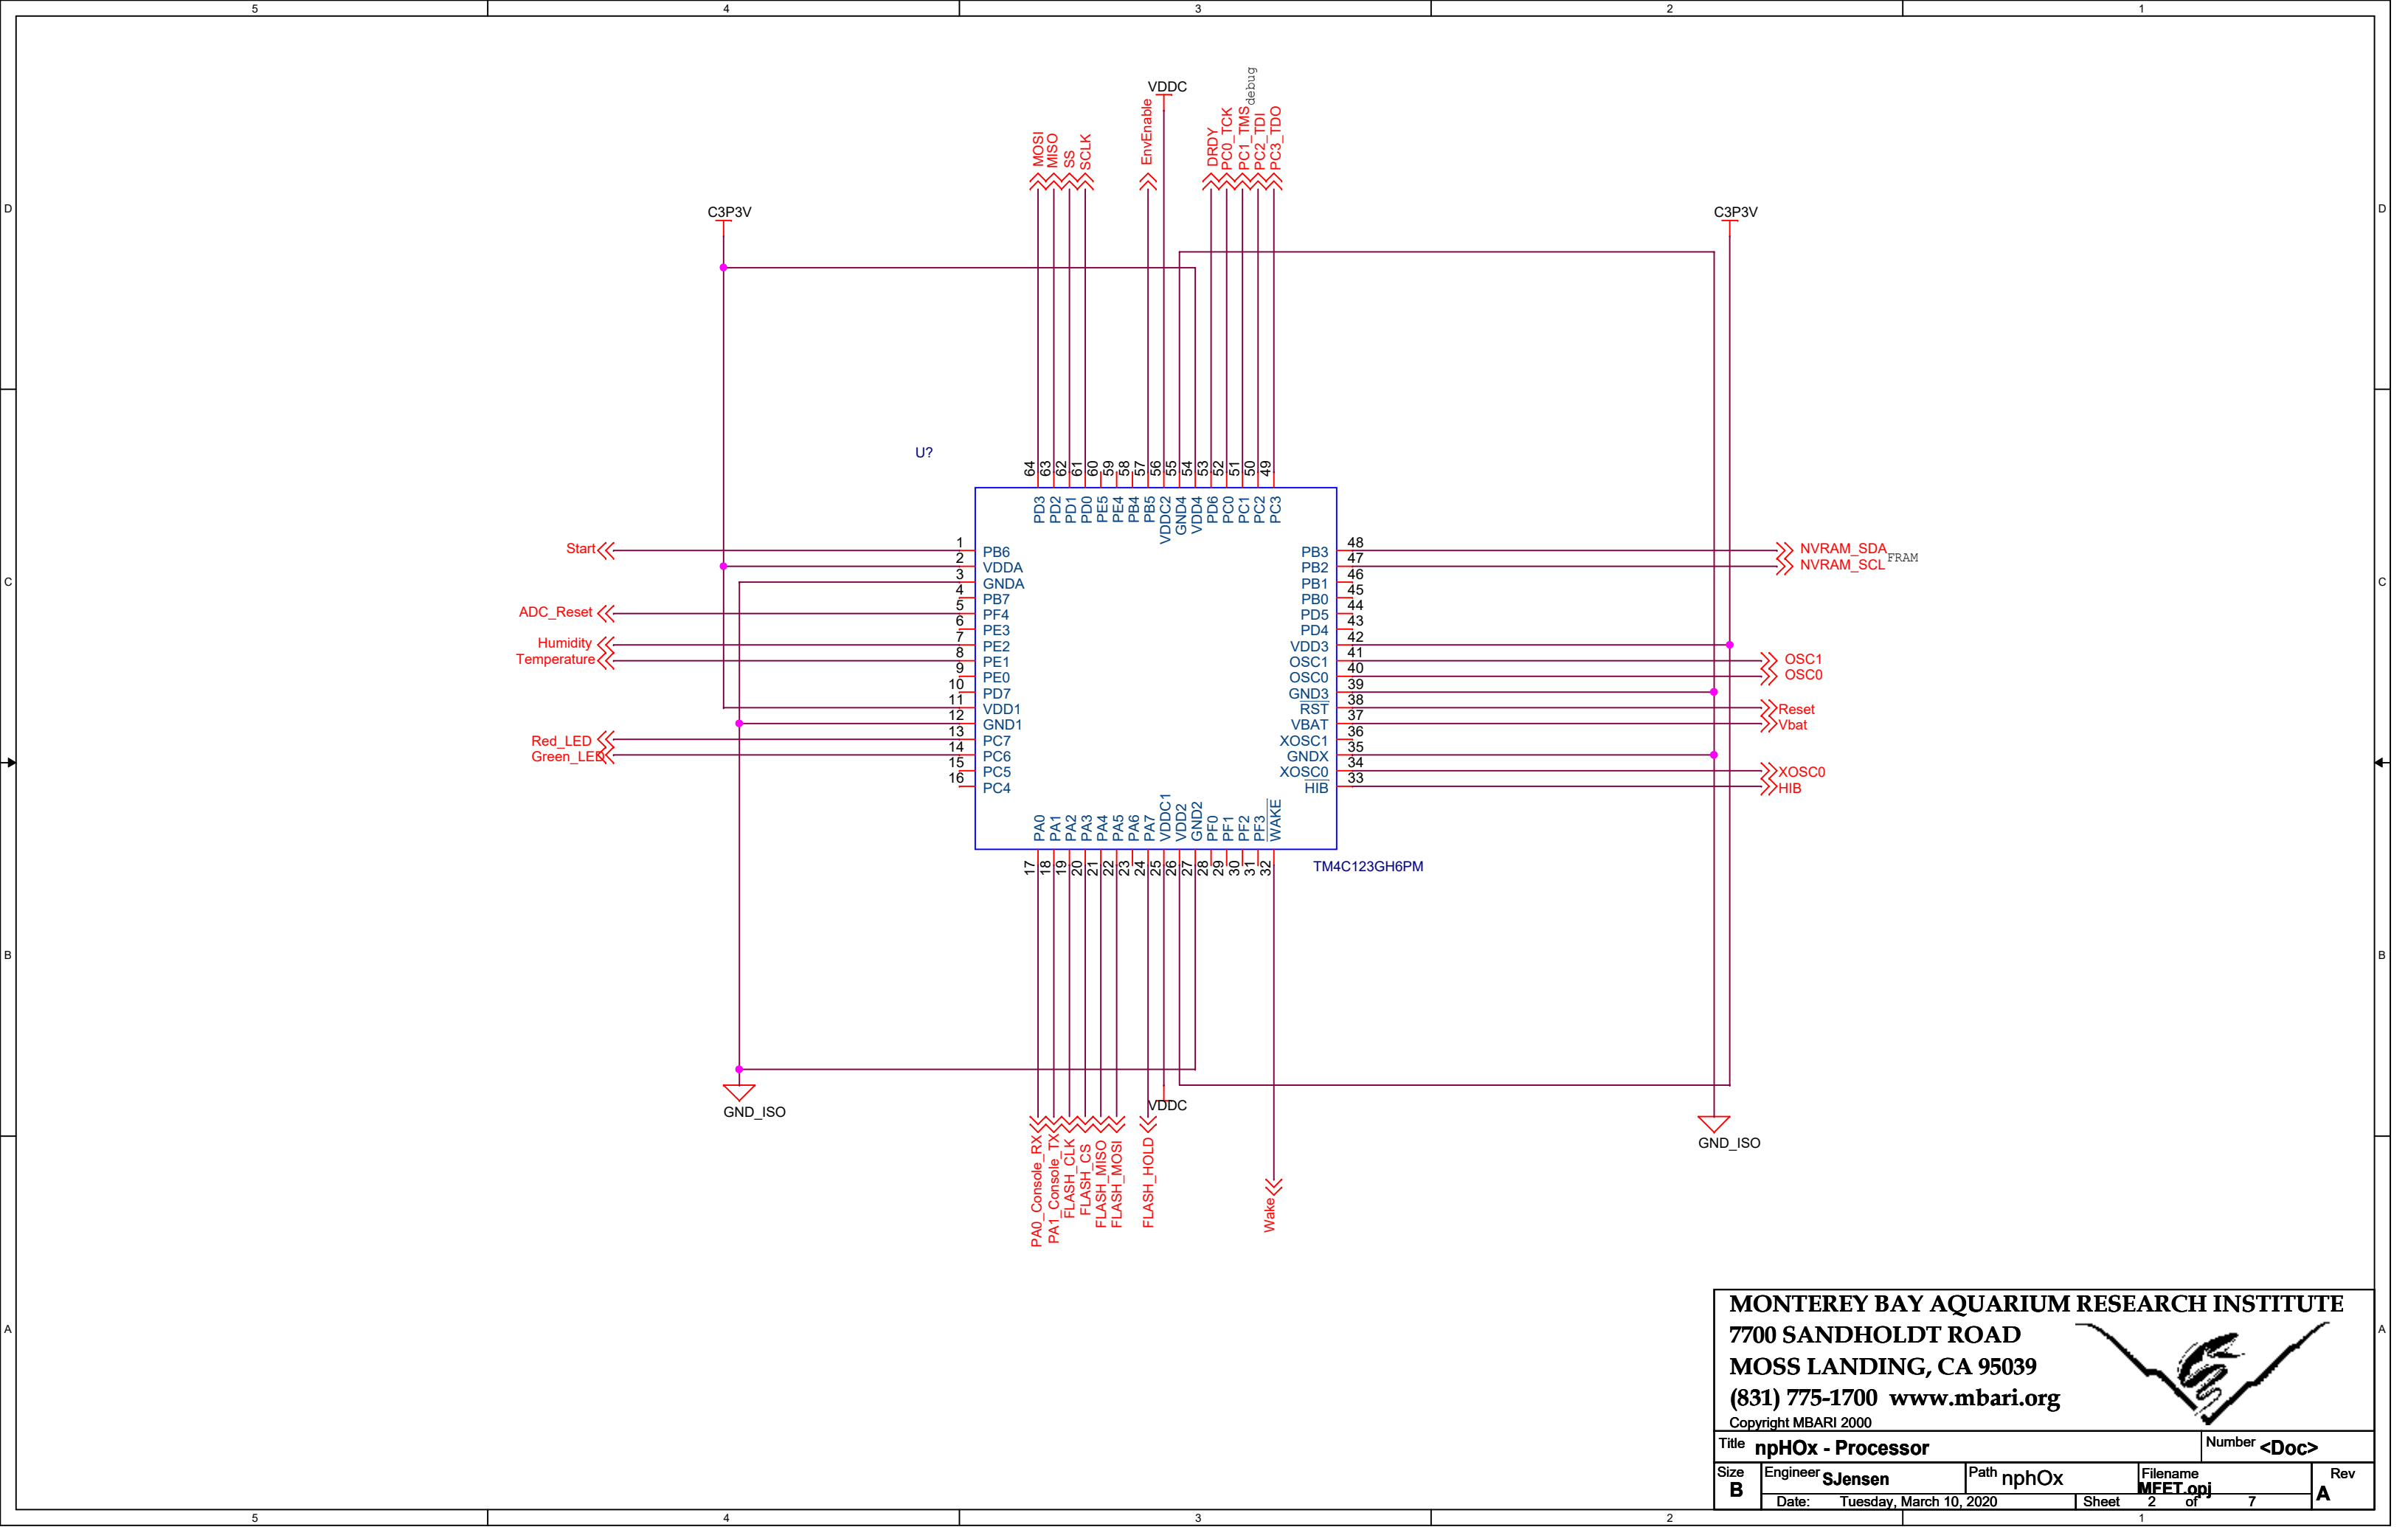

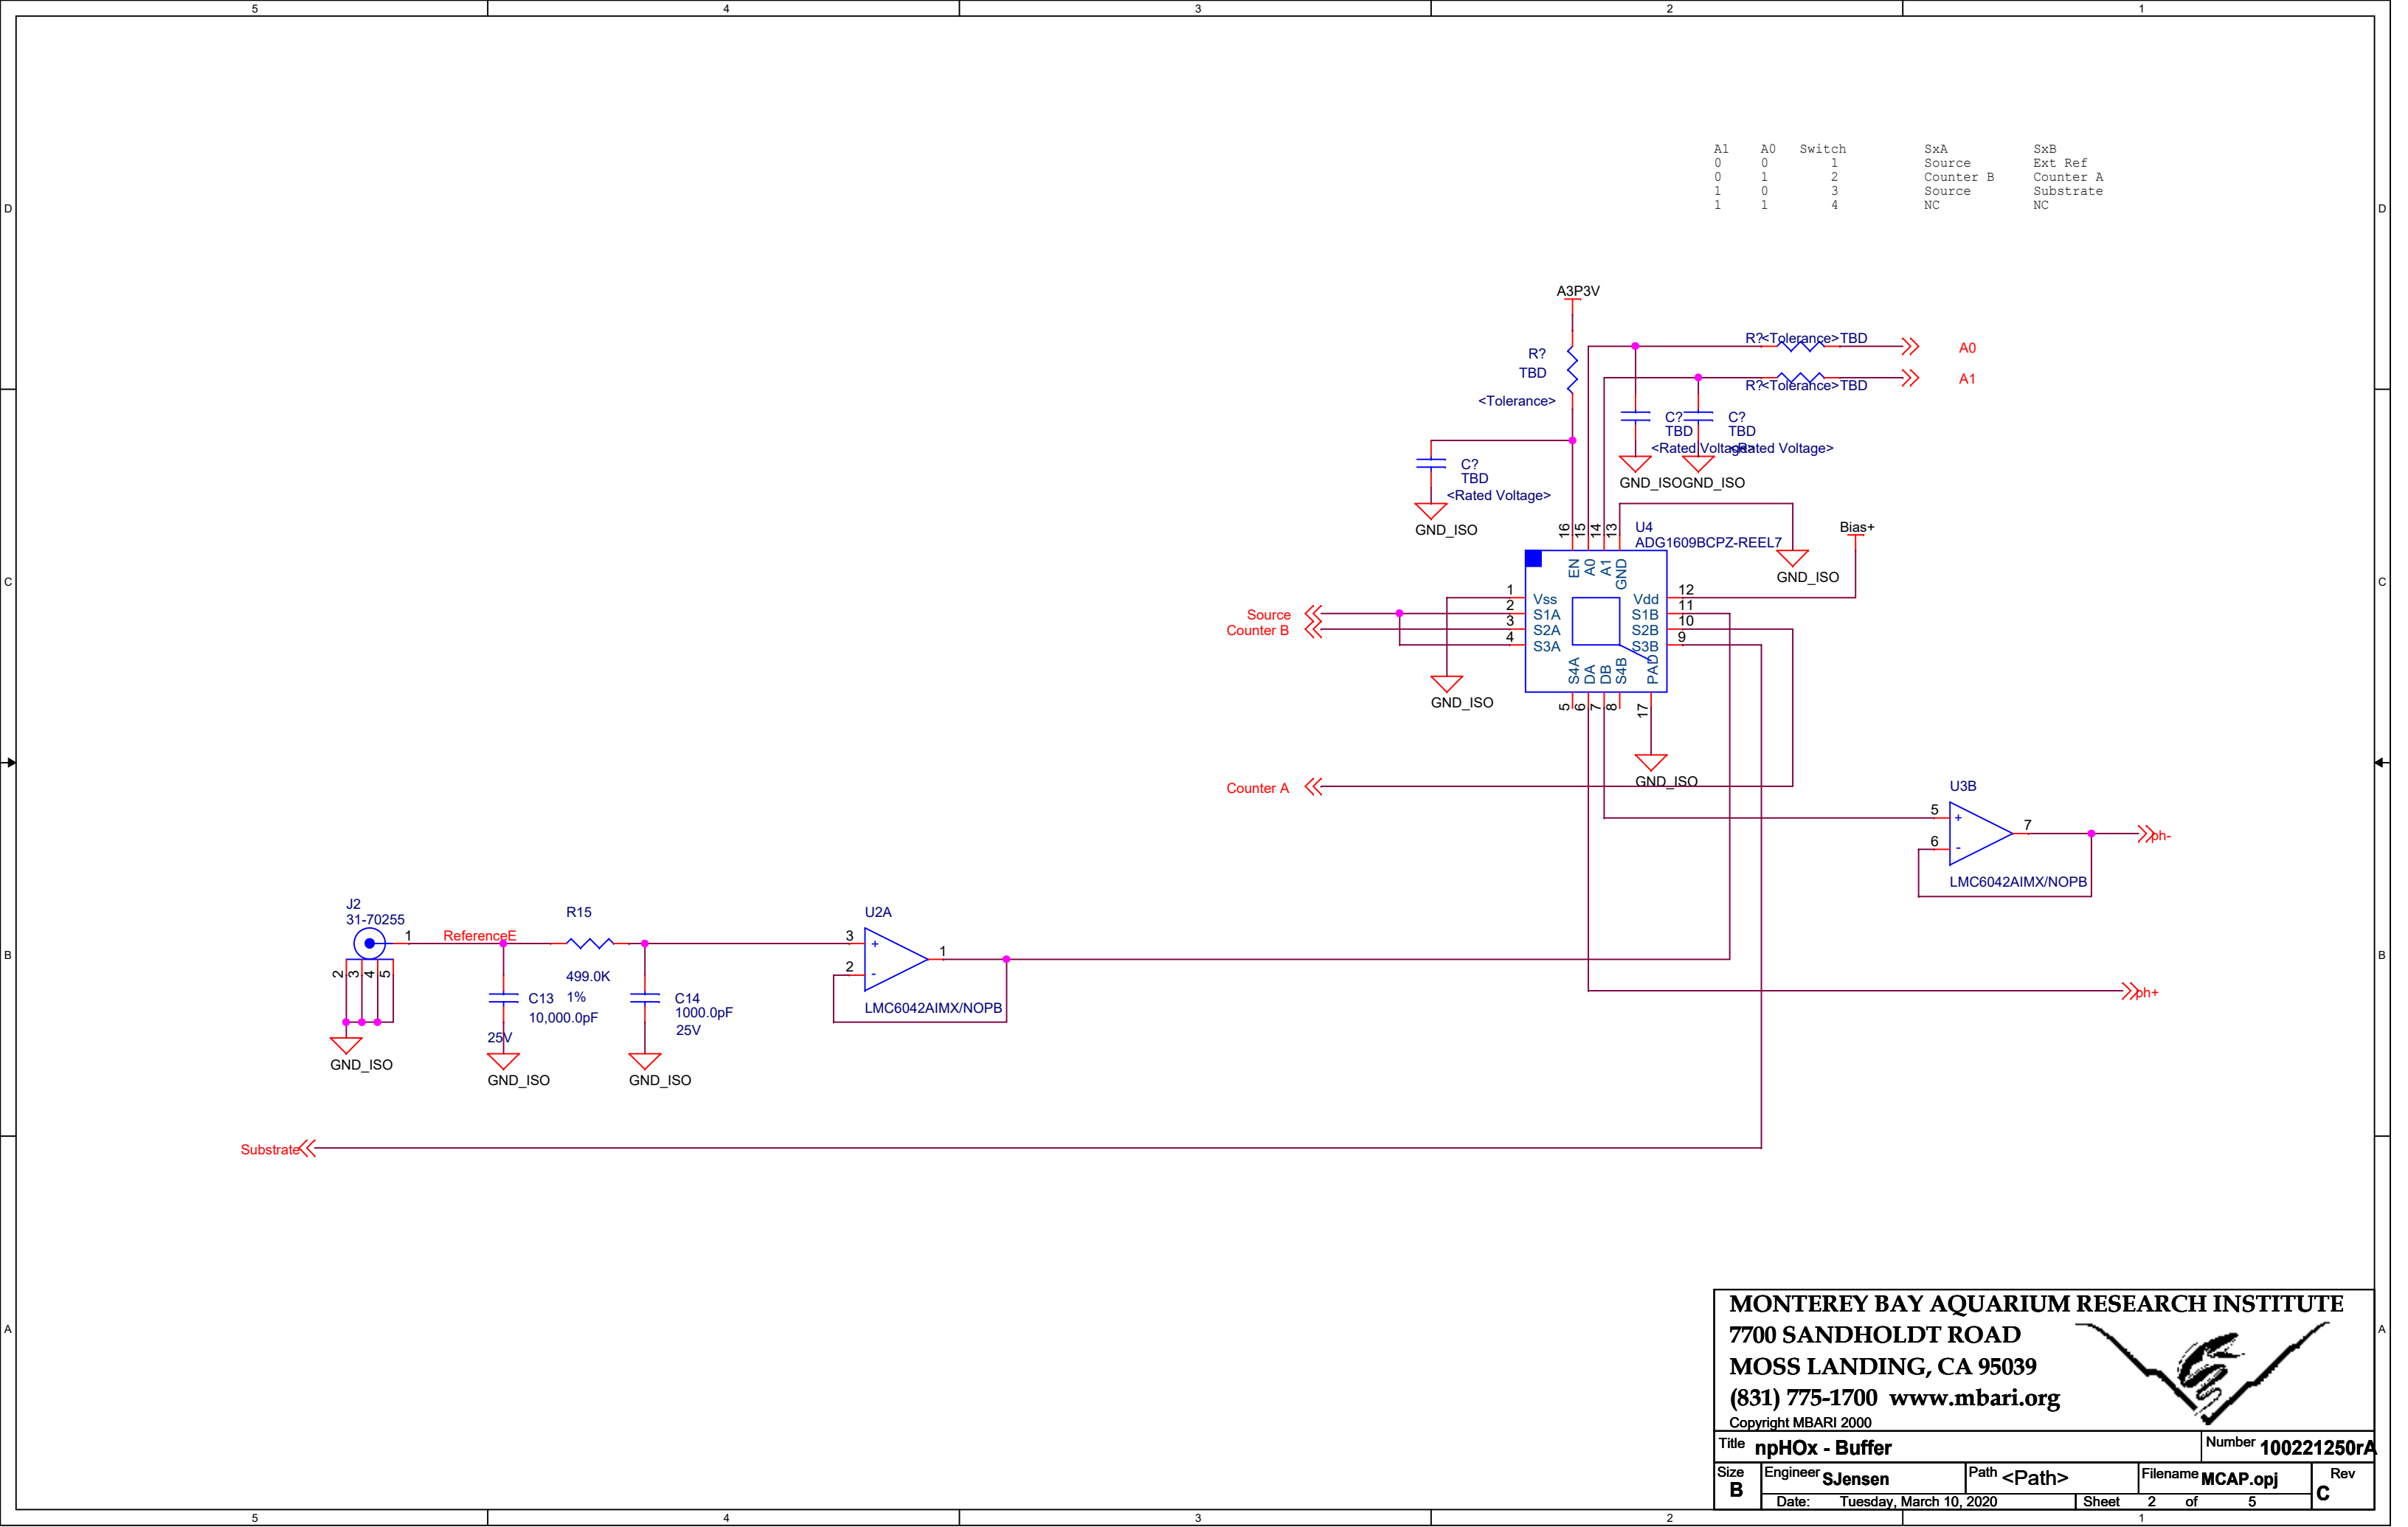

DuraFET isolated Bias power

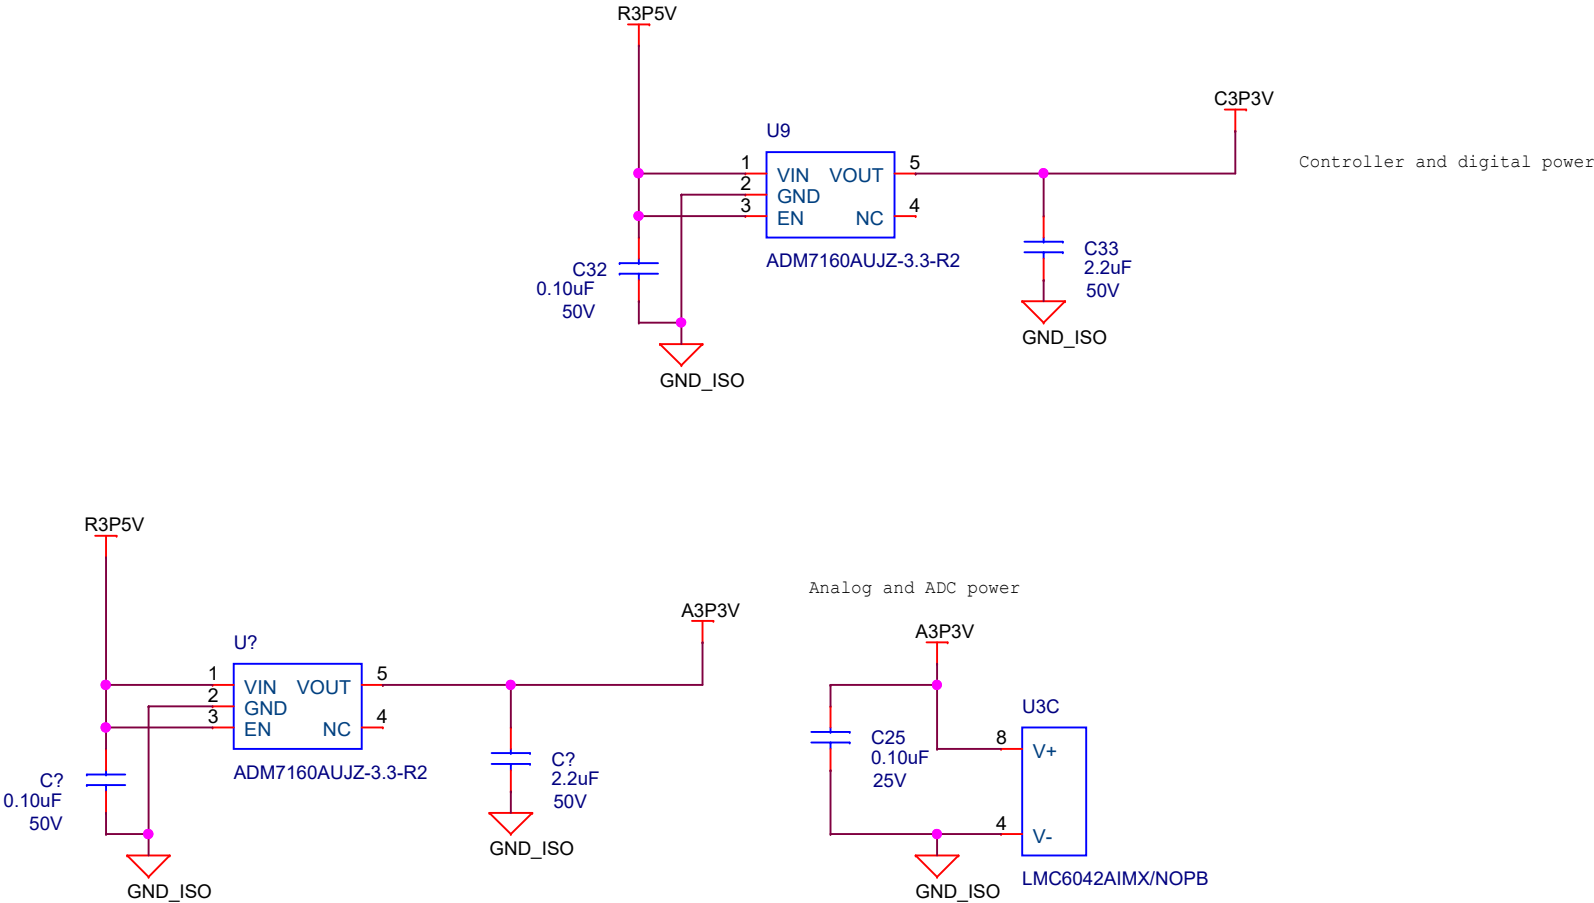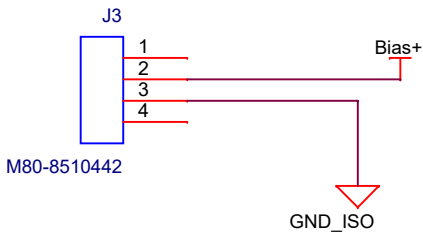

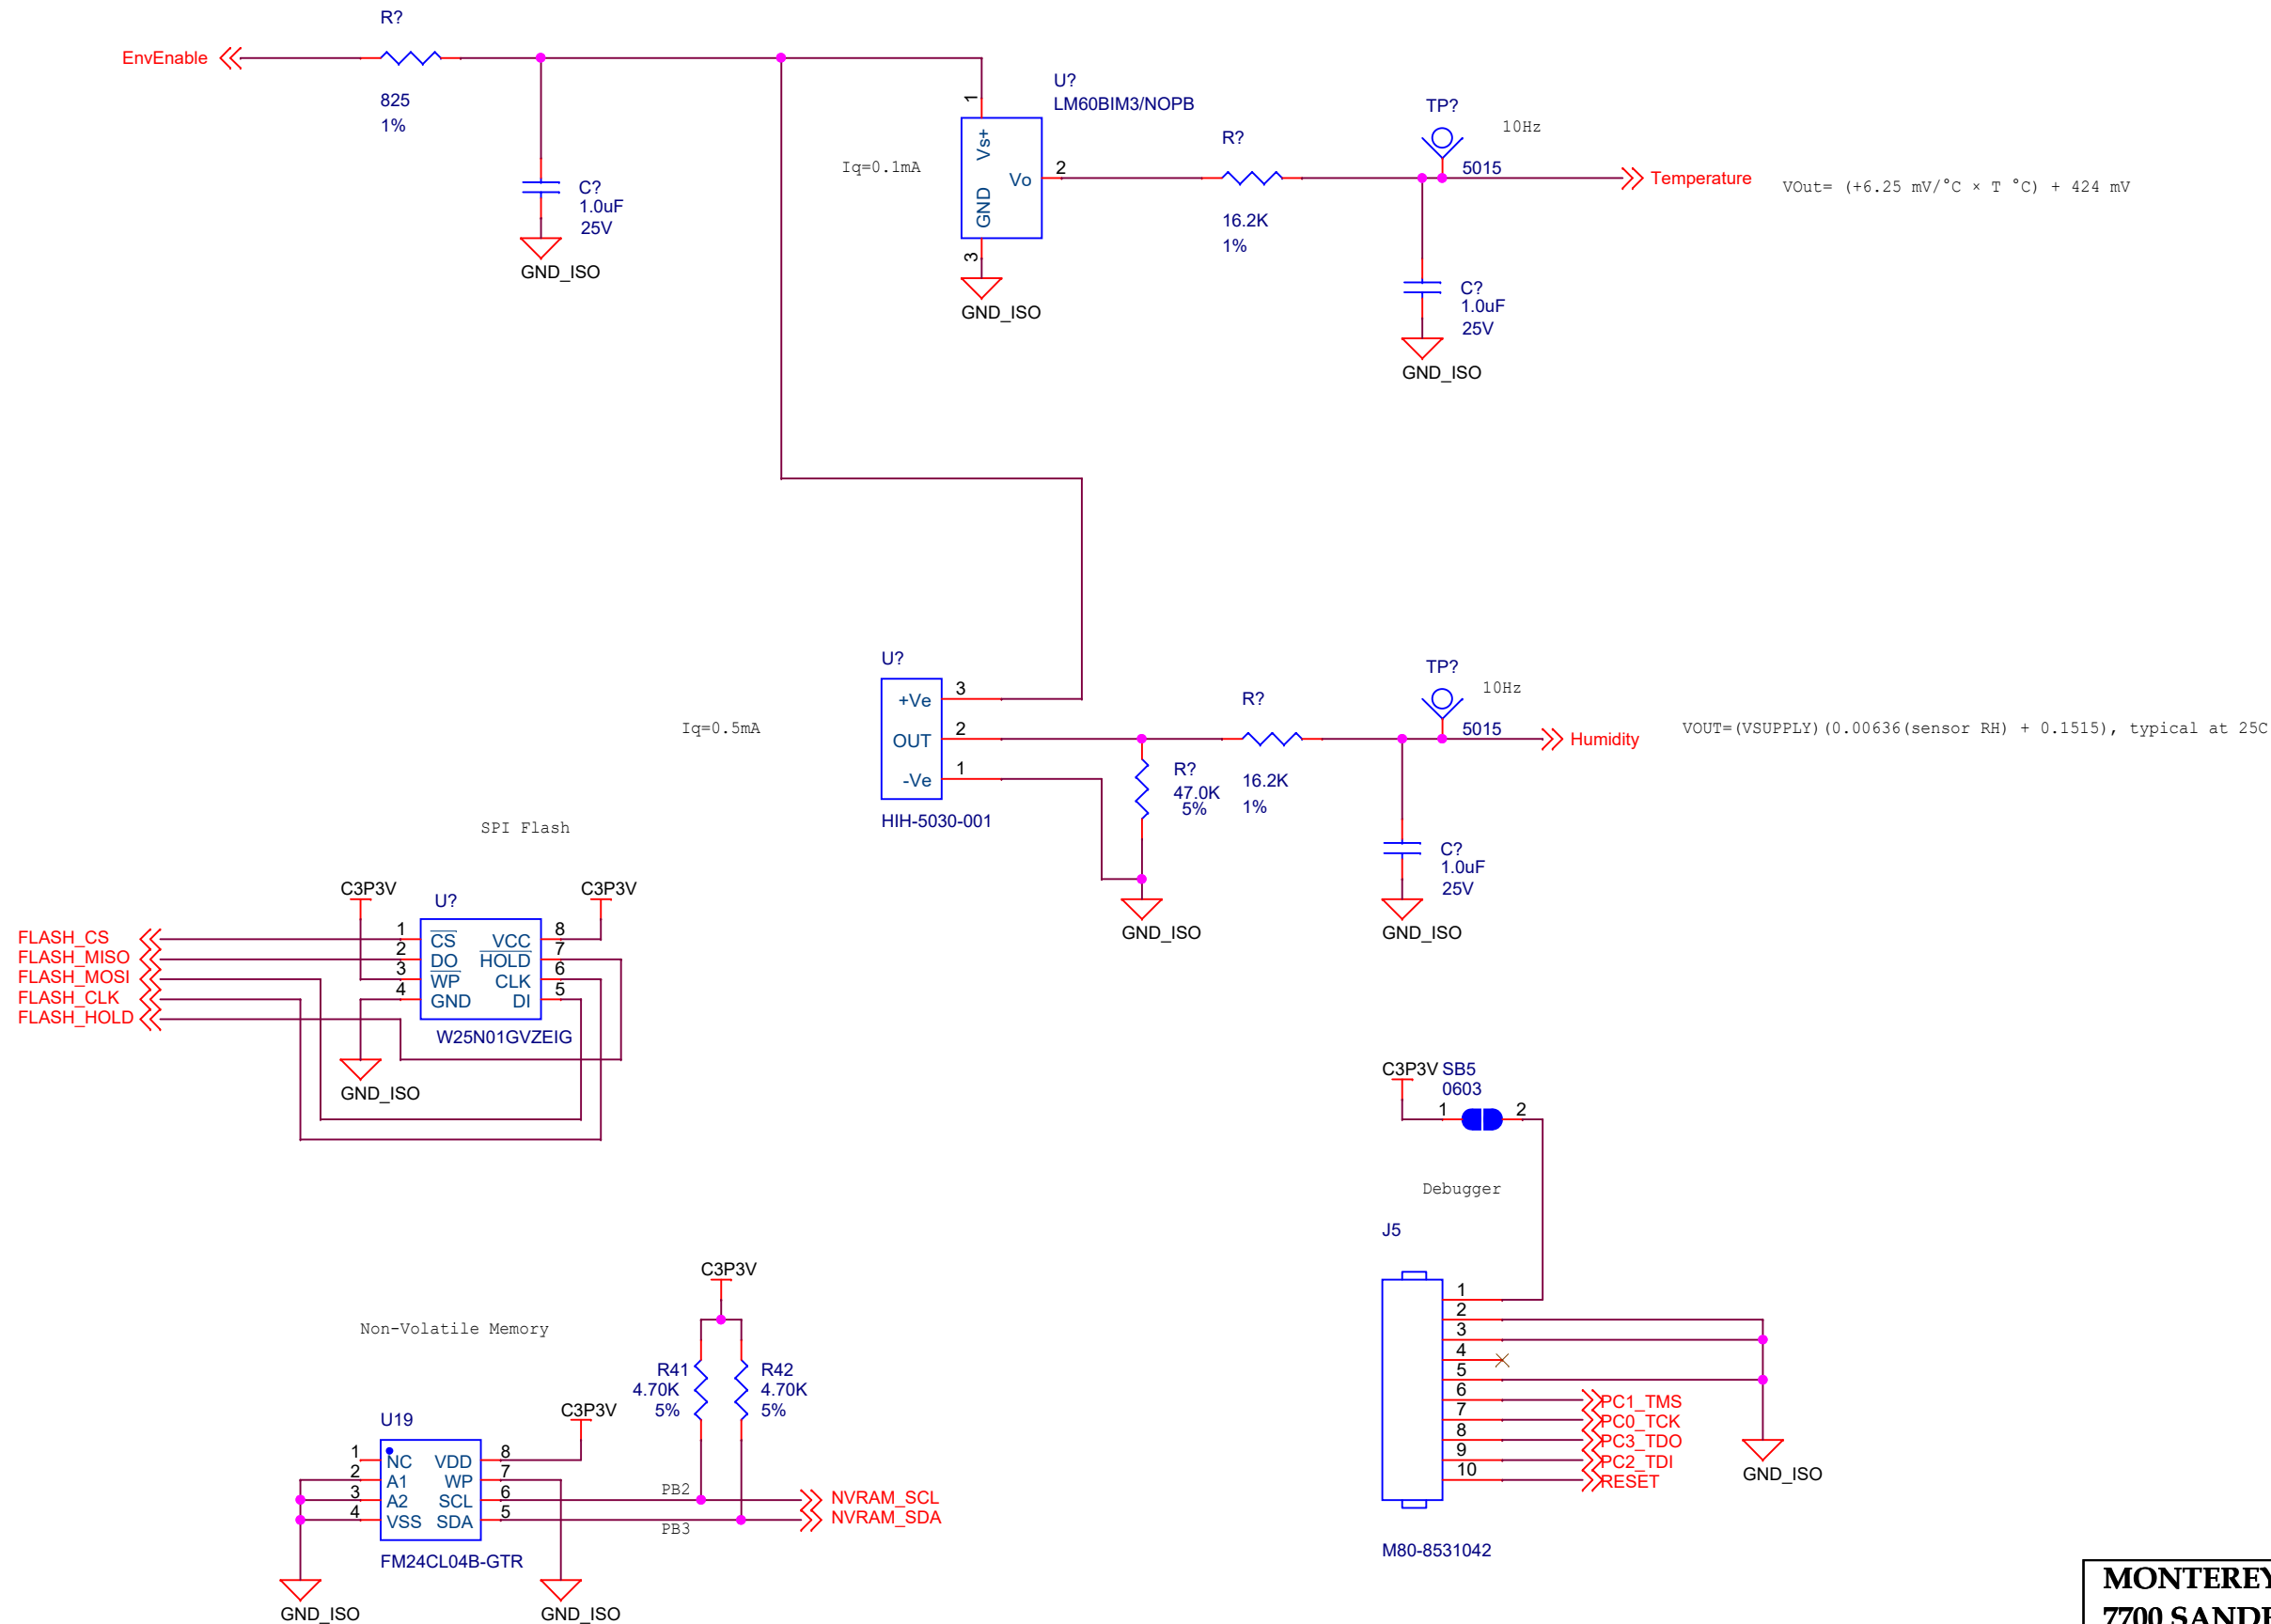

Bigger FRAM
<https://www.digikey.com/product-detail/en/fujitsu-electronics-america-inc/MB85RC1MTPNF-G-JNERE1/865-1268-1-ND/5456442>

MONTEREY BAY AQUARIUM RESEARCH INSTITUTE 7700 SANDHOLDT ROAD MOSS LANDING, CA 95039 (831) 775-1700 www.mbari.org Copyright MBARI 2000					
Title npHOx - Miscellaneous Interfaces Number <Doc>					
Size B	Engineer SJensen	Path nphOx	Filename MFET.opj	Rev A	
Date: Monday, January 27, 2020		Sheet 5 of 7			