


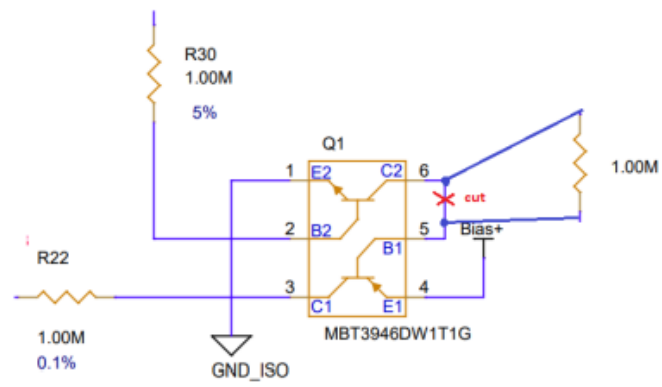

Please rework Q1 so that it has these values/jumper.

Thank you!