

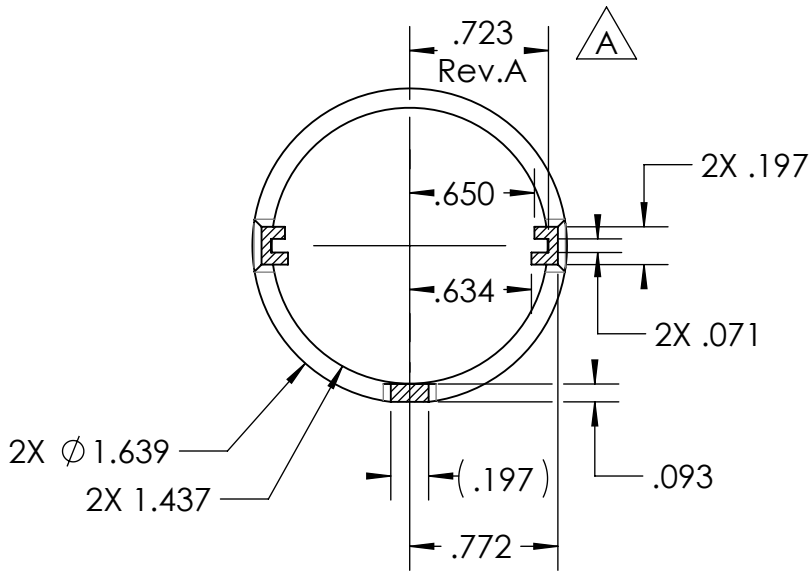
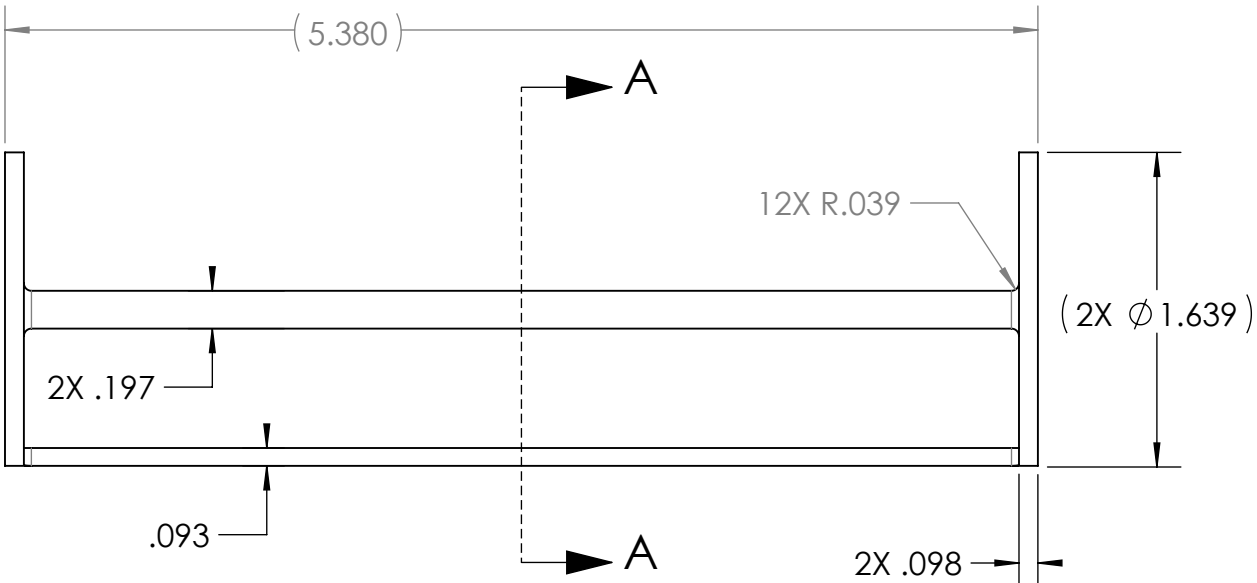
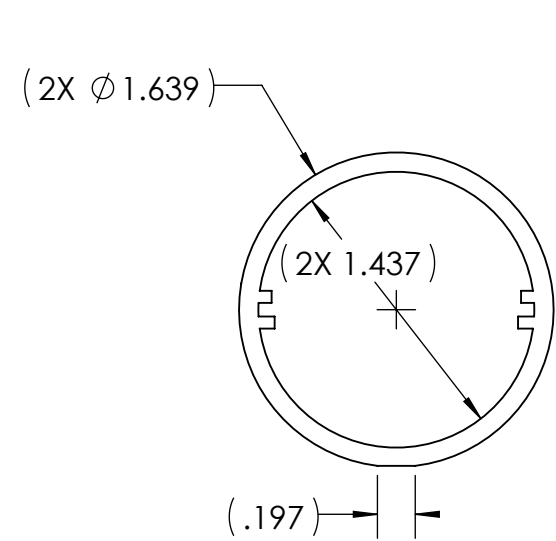


THE INFORMATION CONTAINED IN THIS DRAWING IS THE SOLE PROPERTY OF MBARI ANY REPRODUCTION IN PART OR WHOLE WITHOUT THE WRITTEN PERMISSION OF MBARI IS PROHIBITED.

REVISIONS				
INITIAL RELEASE			X/XX/01	J.E.
REVISIONS				
ZONE	REV.	DESCRIPTION	DATE	APPROVED
B1	A	CHG DIM frm .707" to .723"	8/10/2023	J.E.

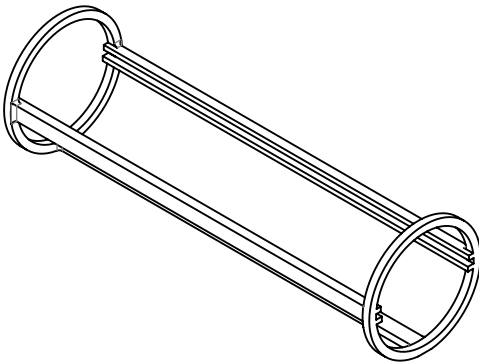

SECTION A-A
SCALE 1 : 1

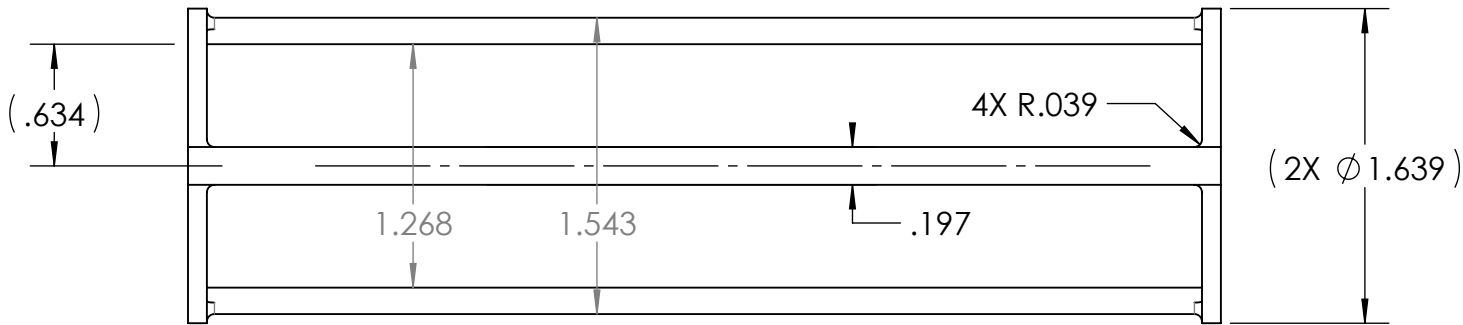

7. PROJECT LIBRARYX:\901805_Coastal_Biogeochemical_Sensing\Project.Drawings\
Project.ME.Dwgs\Interior

NOTES: (CONT. FROM TITLE BLOCK)

R.P.-UnionTech_SOMOS Watershed XC 11122

1	1	P-221932-23	nanoFET Board Chassis	MBARI	
ITEM NO.	QTY.	Part_Number	DESCRIPTION	Vendor	MATERIAL
BILL OF MATERIALS					
Shop / Q.C.		UNLESS OTHERWISE SPECIFIED TOLERANCES ARE:		APPROVALS DATE	
Inspector		1 PLACE DIM ±1/16	2 PLACE DIM ±.02	3 PLACE DIM ±.005	ANGLES ±1°
Shop Foreman		1. DIMENSIONS ARE IN INCHES		DRAWN J. ERICKSON	
Engineer		2. DIMENSION LIMITS HELD AFTER PLATING.		ENGINEER J. ERICKSON	
		3. REMOVE BURRS AND SHARP EDGES .015 MAX.		CHECKED	
		4. MACHINED FILLET RADII .0150-.030.		PROJECT NO. 901805	
NEXT ASSY Description	NEXT ASSY Number	5. MACHINED DIAMETERS ON A COMMON CENTERLINE CONCENTRIC WITHIN .005		PROJECT Coastal BioGeo	
		6. PERPENDICULARITY & PARALLELISM OF MACHINED SURFACES .002 PER INCH. MAX .012 INCHES FOR SINGLE SURFACE.		WEIGHT 0.014	
Application		DO NOT SCALE DRAWING		SIZE B DWG. NO. P-221932-23.DWG REV. A	
				SCALE 1:2 CAD FILE: MECH ENG ON TORNADO SHEET 1 OF 1	

Monterey Bay Aquarium Research Institute
MBARI
7700 Sandholdt RD.
Moss Landing, CA 95039
PH: (831) 775-1700



nanoFET
nanoFET Board Chassis