



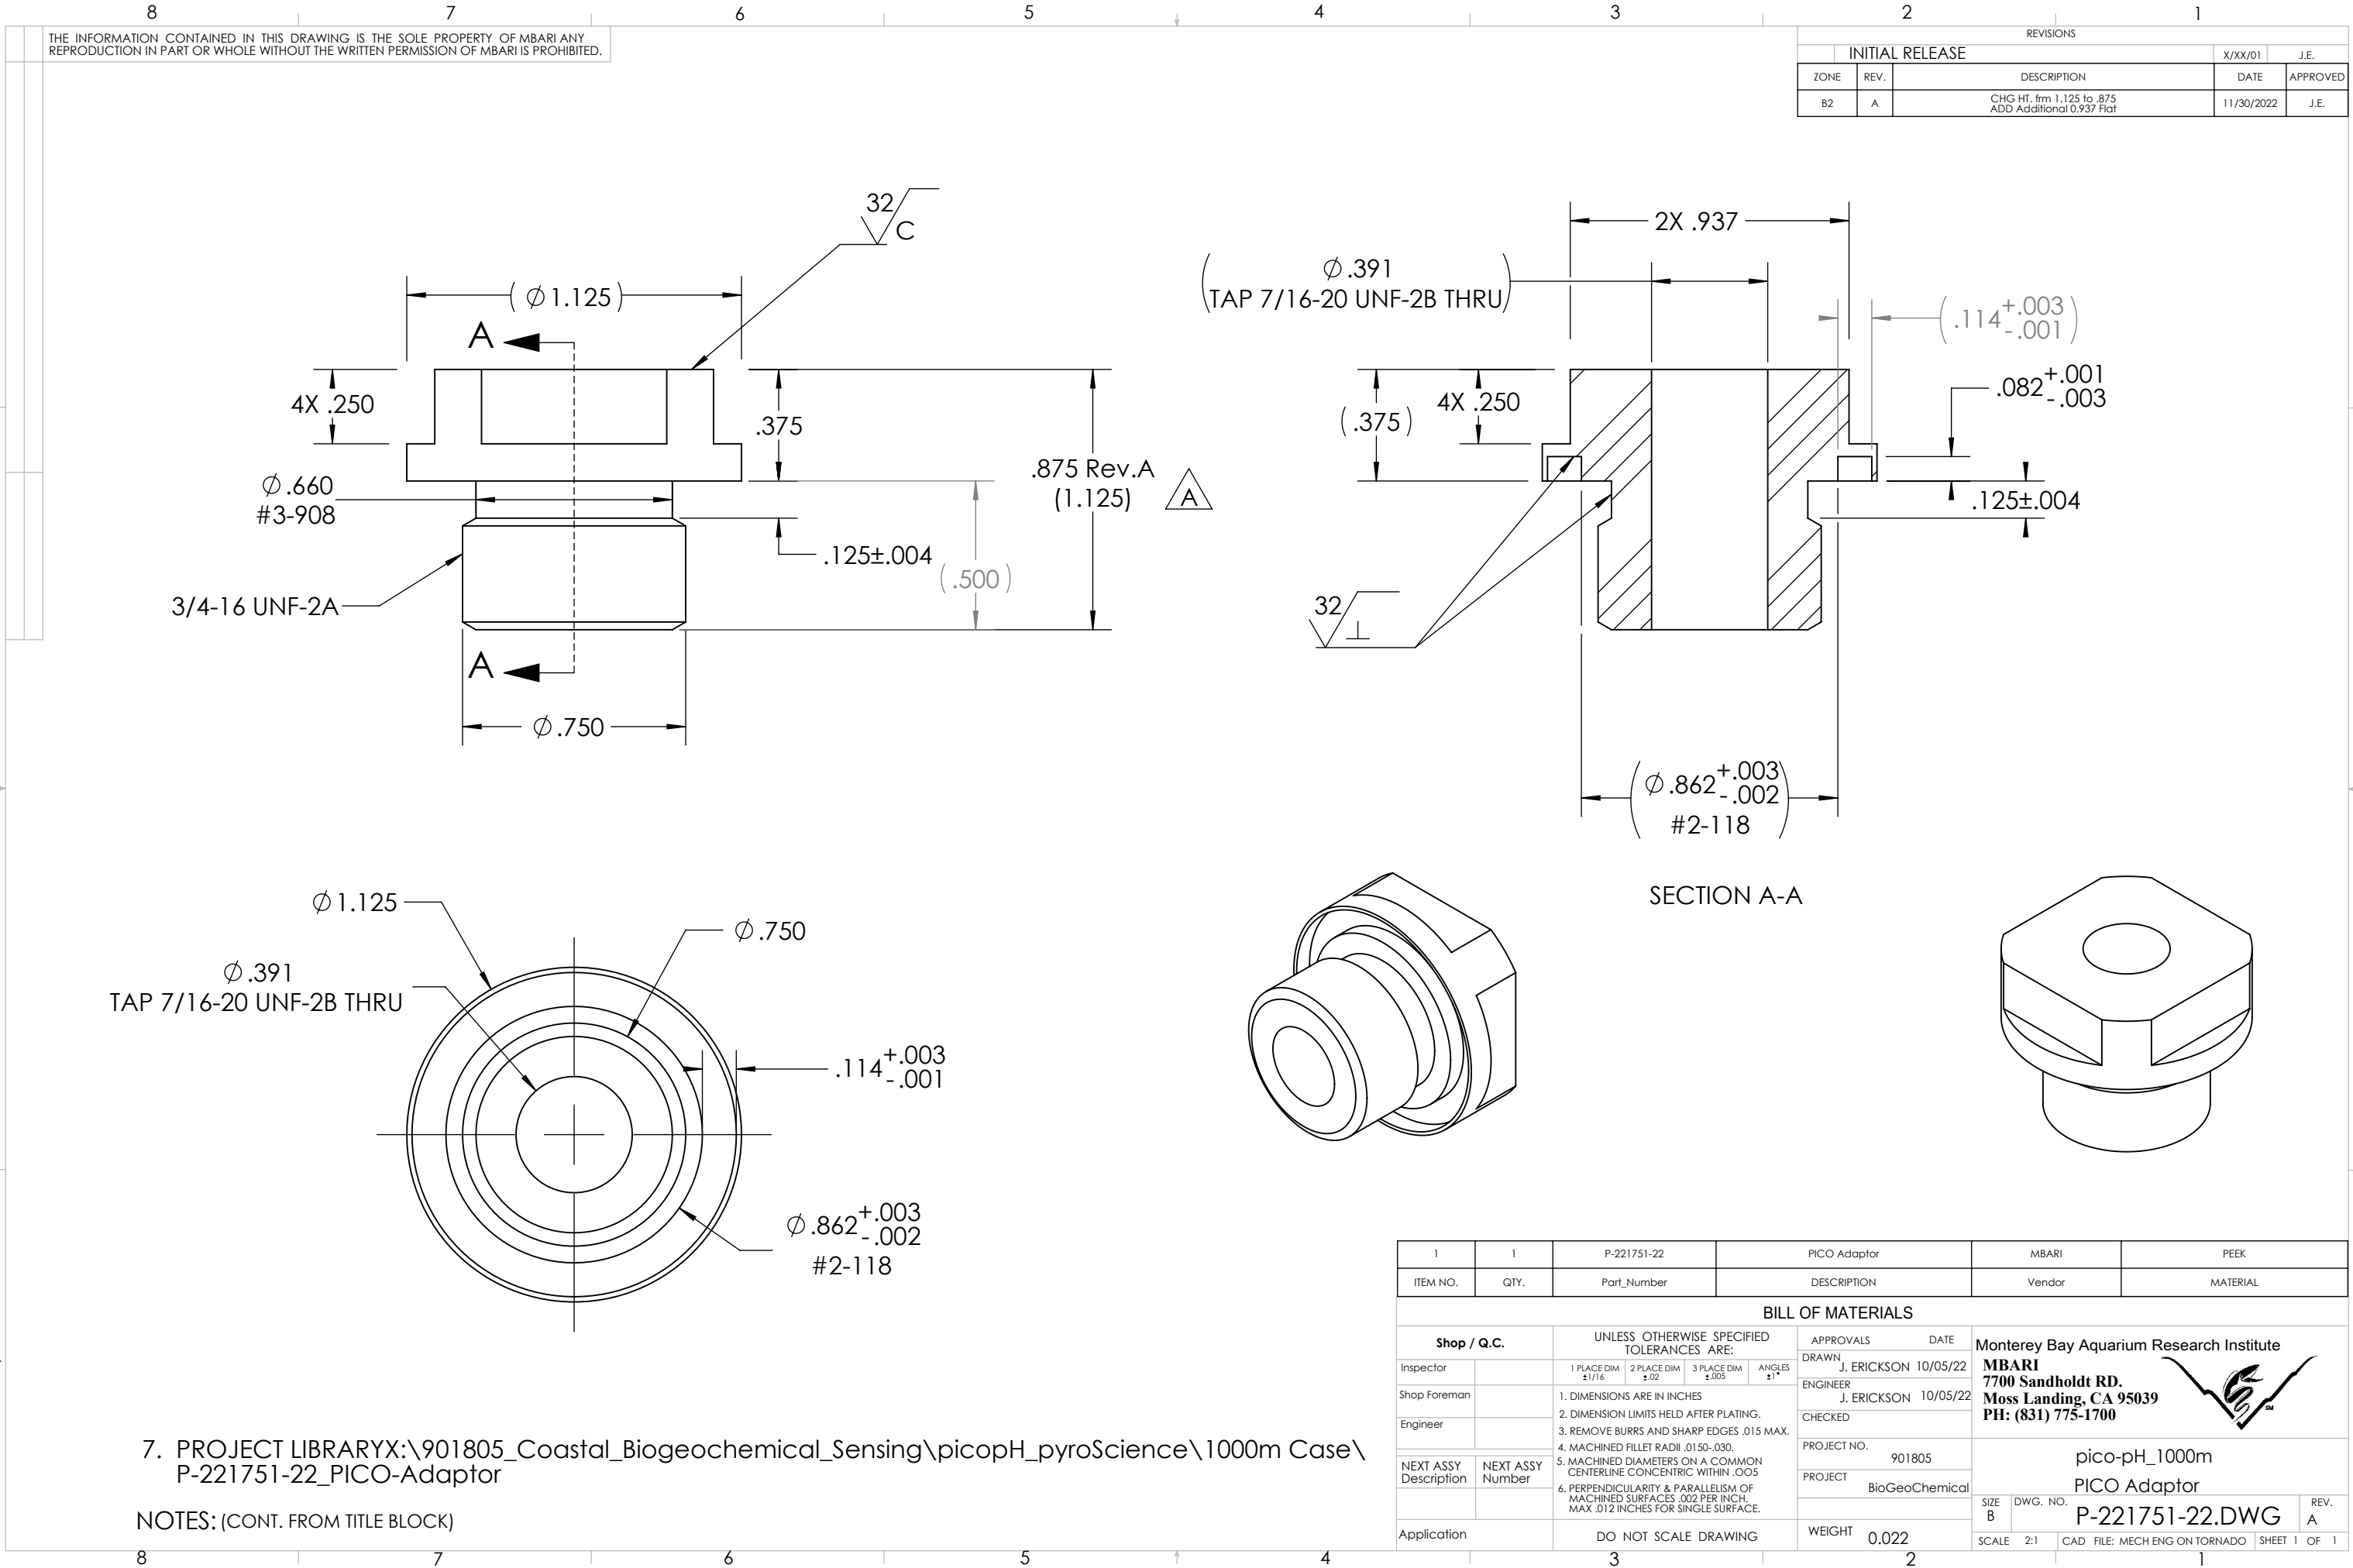

1	1	P-221751-22	PICO Adaptor			MBARI		PEEK	
ITEM NO.	QTY.	Part_Number	DESCRIPTION			Vendor		MATERIAL	
BILL OF MATERIALS									
Shop / Q.C.		UNLESS OTHERWISE SPECIFIED TOLERANCES ARE:			APPROVALS		DATE		Monterey Bay Aquarium Research Institute MBARI 7700 Sandholdt RD. Moss Landing, CA 95039 PH: (831) 775-1700 
Inspector		1 PLACE DIM ±1/16	2 PLACE DIM ±.02	3 PLACE DIM ±.005	ANGLES ±1°	DRAWN	J. ERICKSON	10/05/22	
Shop Foreman		1. DIMENSIONS ARE IN INCHES 2. DIMENSION LIMITS HELD AFTER PLATING. 3. REMOVE BURRS AND SHARP EDGES .015 MAX. 4. MACHINED FILLET RADII .0150-.030.			ENGINEER	J. ERICKSON	10/05/22		
Engineer					CHECKED				
NEXT ASSY Description	NEXT ASSY Number	5. MACHINED DIAMETERS ON A COMMON CENTERLINE CONCENTRIC WITHIN .005 6. PERPENDICULARITY & PARALLELISM OF MACHINED SURFACES .002 PER INCH. MAX .012 INCHES FOR SINGLE SURFACE.			PROJECT NO.	901805	pico-pH_1000m PICO Adaptor		
Application					PROJECT	BioGeoChemical			
					WEIGHT	0.022	SIZE B	DWG. NO. P-221751-22.DWG	REV. A
		DO NOT SCALE DRAWING					SCALE 2:1	CAD FILE: MECH ENG ON TORNADO	SHEET 1 OF 1

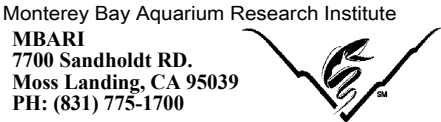

Monterey Bay Aquarium Research Institute
MBARI
7700 Sandholdt RD.
Moss Landing, CA 95039
PH: (831) 775-1700

pico-pH_1000m
PICO Adaptor
P-221751-22.DWG

SIZE B DWG. NO. REV. A