

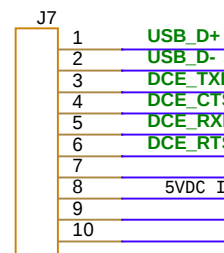
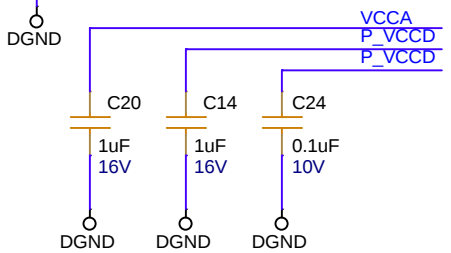
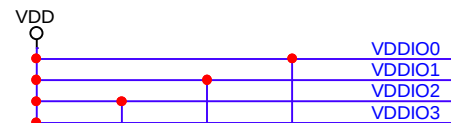
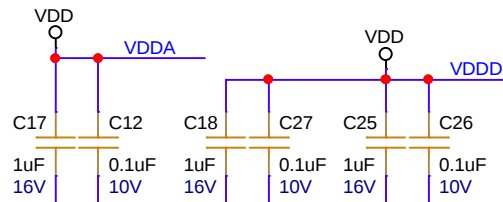
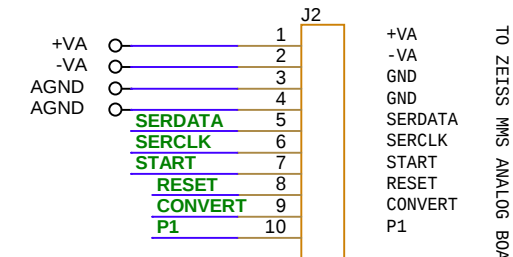
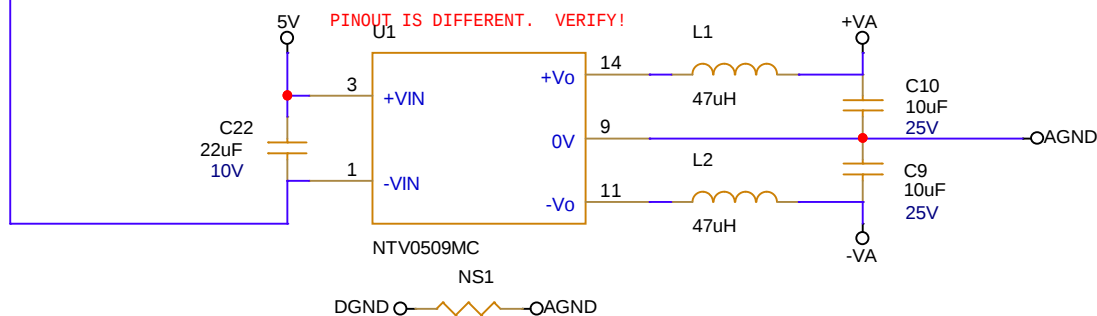
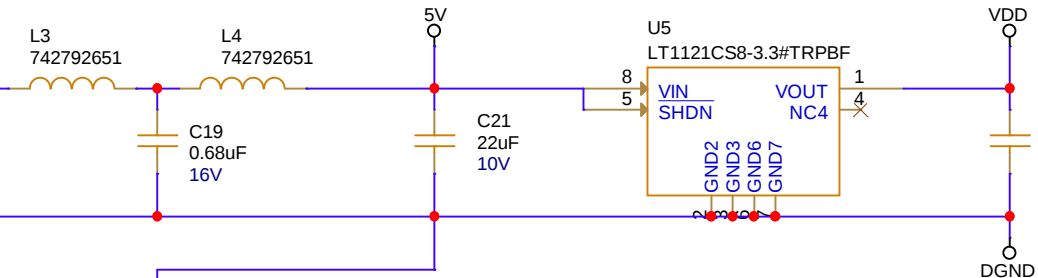
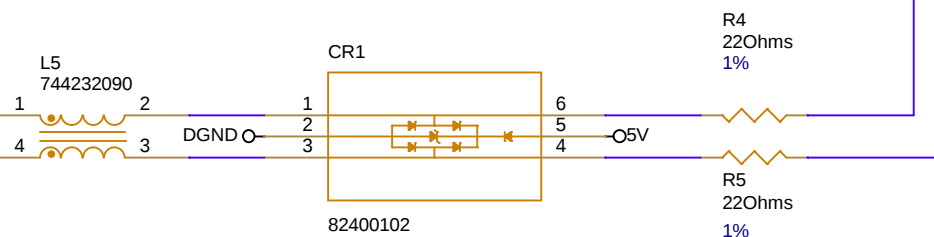








EC06-IDC

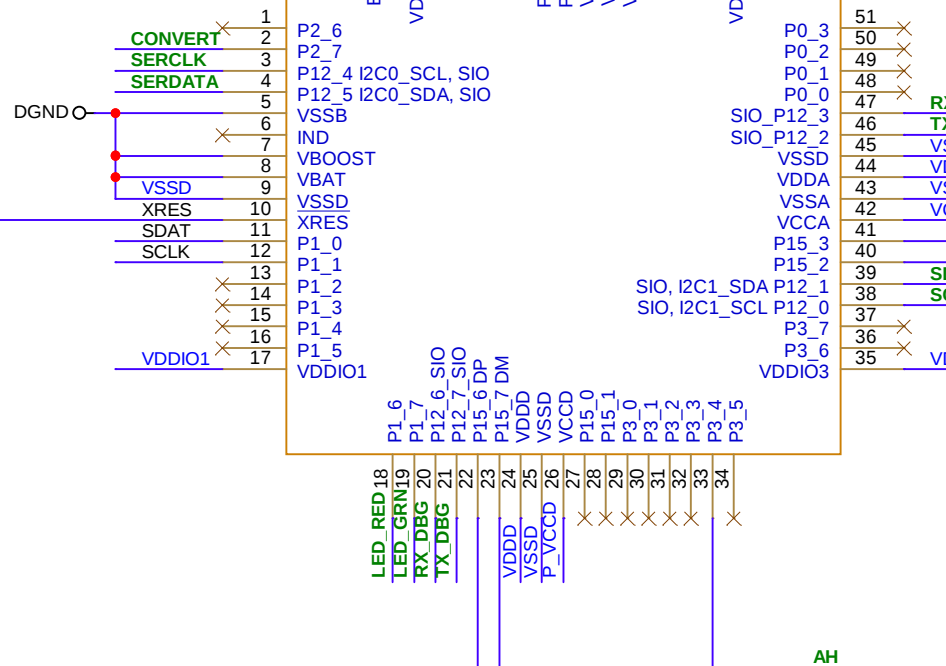

SEM-105-02-03.0-H-D-A

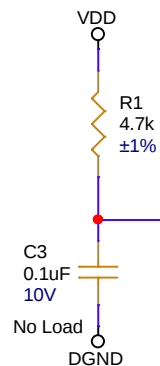

SEM-105-02-03.0-H-D-A

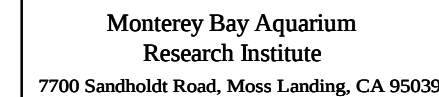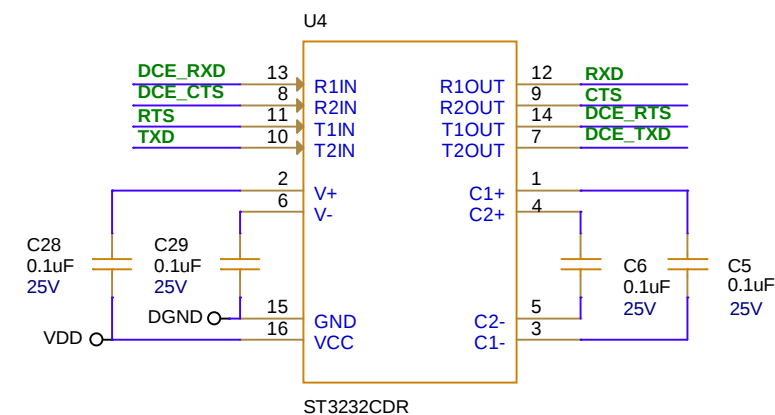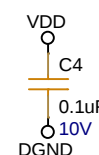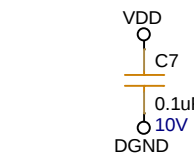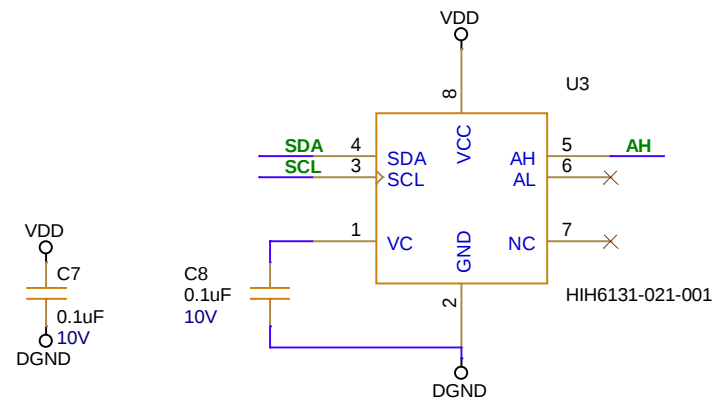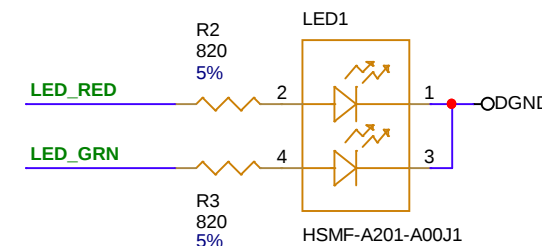

Schematic Name:				
MMS PSOC DIGITAL BOARD				
Page Title: Zeiss MMS Digital Board			Engineer: Luke Coletti	
Project Name: Chemical Sensors		Group Name: ChemicalSensors		Designer: Jose Rosal
System: ISUS V2		Subsystem: <Subsystem>		Last Updated By: jrosal
Drawing Number: 100221518		Release: A Version: 4		Status: Active
Page Modify Date: Tuesday, September 19, 2023		Check In Date: 9/19/2023 12:23:41 PM		Size: B
		Sheet 1 of 1		