
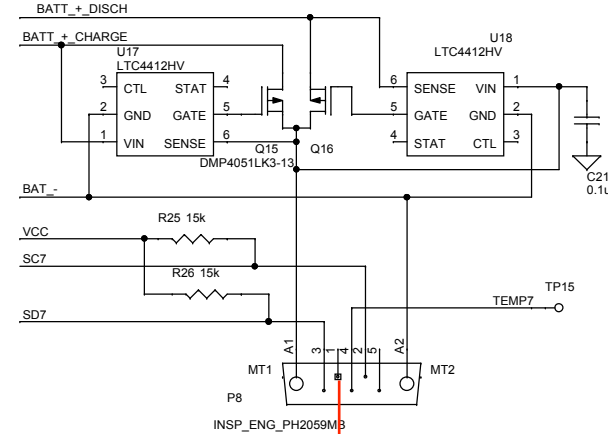
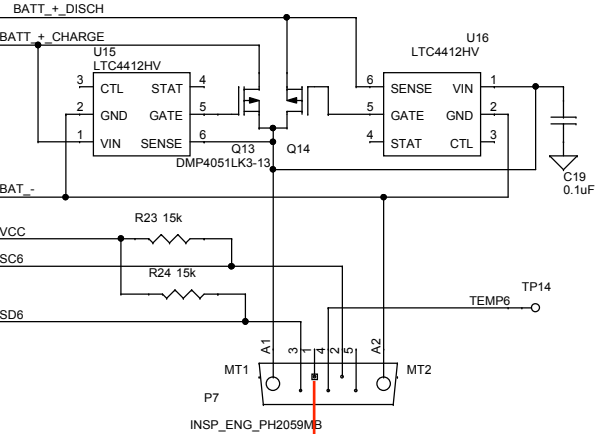
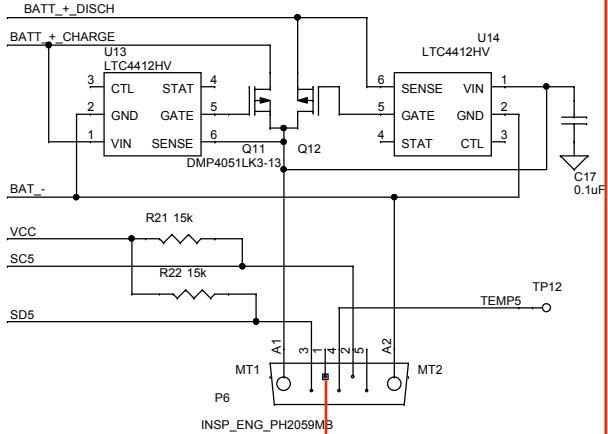
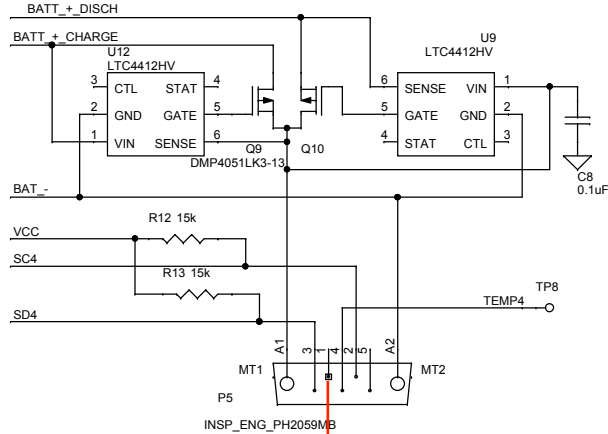
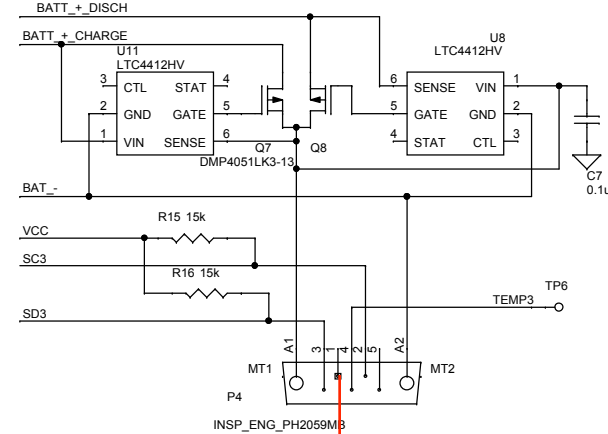
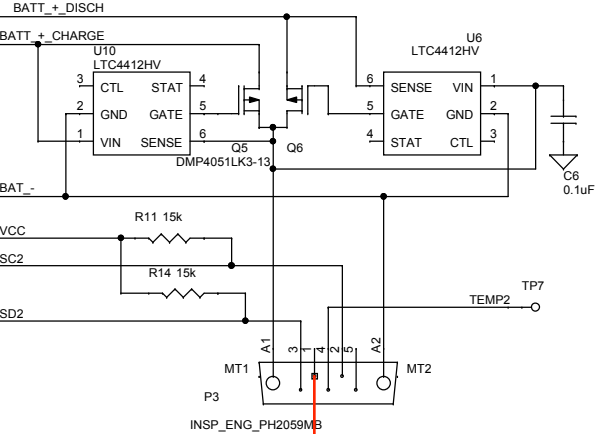
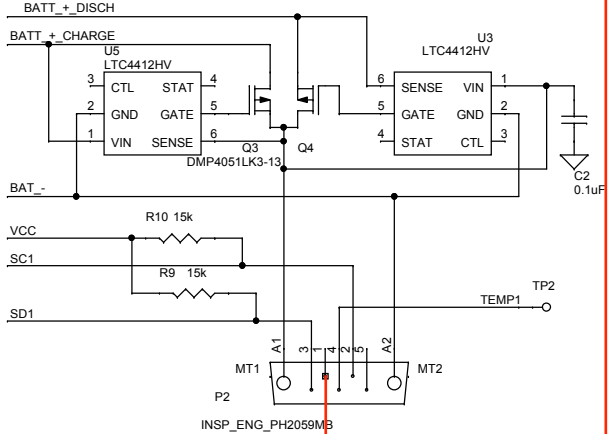
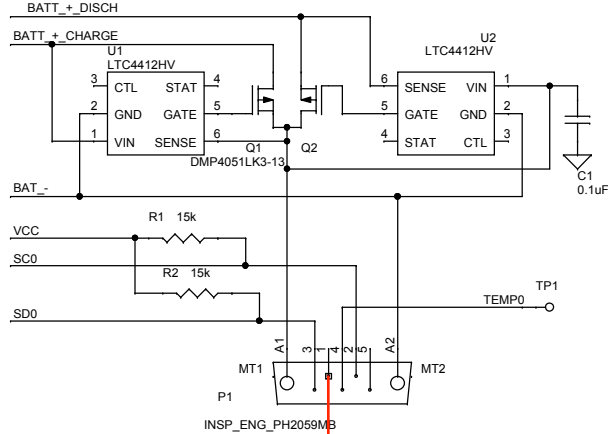
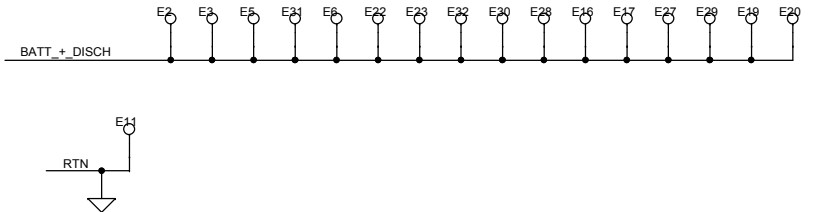
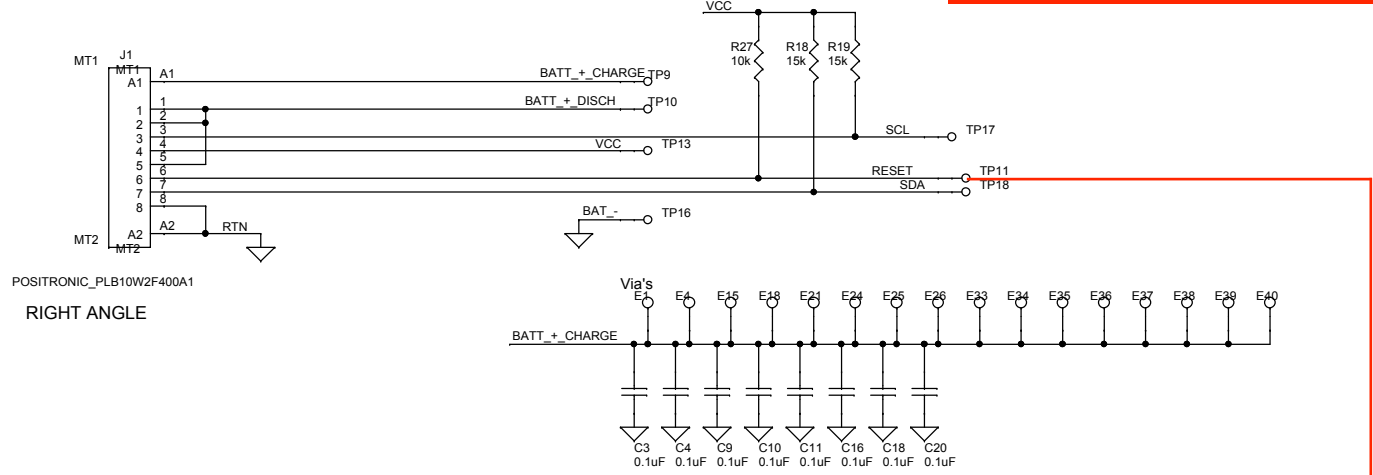


LIFT GULL WING ON PIN 3 U4

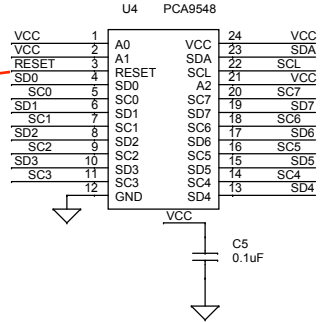

Rev B pcb uses Positronic 7W2s and PEM standoff's

Removed LT3080 Voltage Regulator and associated components: 12 Sept 13 drt

Set mux address to 7 hex: 11 Nov 13 drt

PH2059MB 28.8V Li Ion Battery

Title		
Insp_Eng_8_Pack_Cntlr		
Size	Document Number	Rev
C	10020932_8	B
Date:	Monday, December 23, 2013	Sheet 1 of 1