



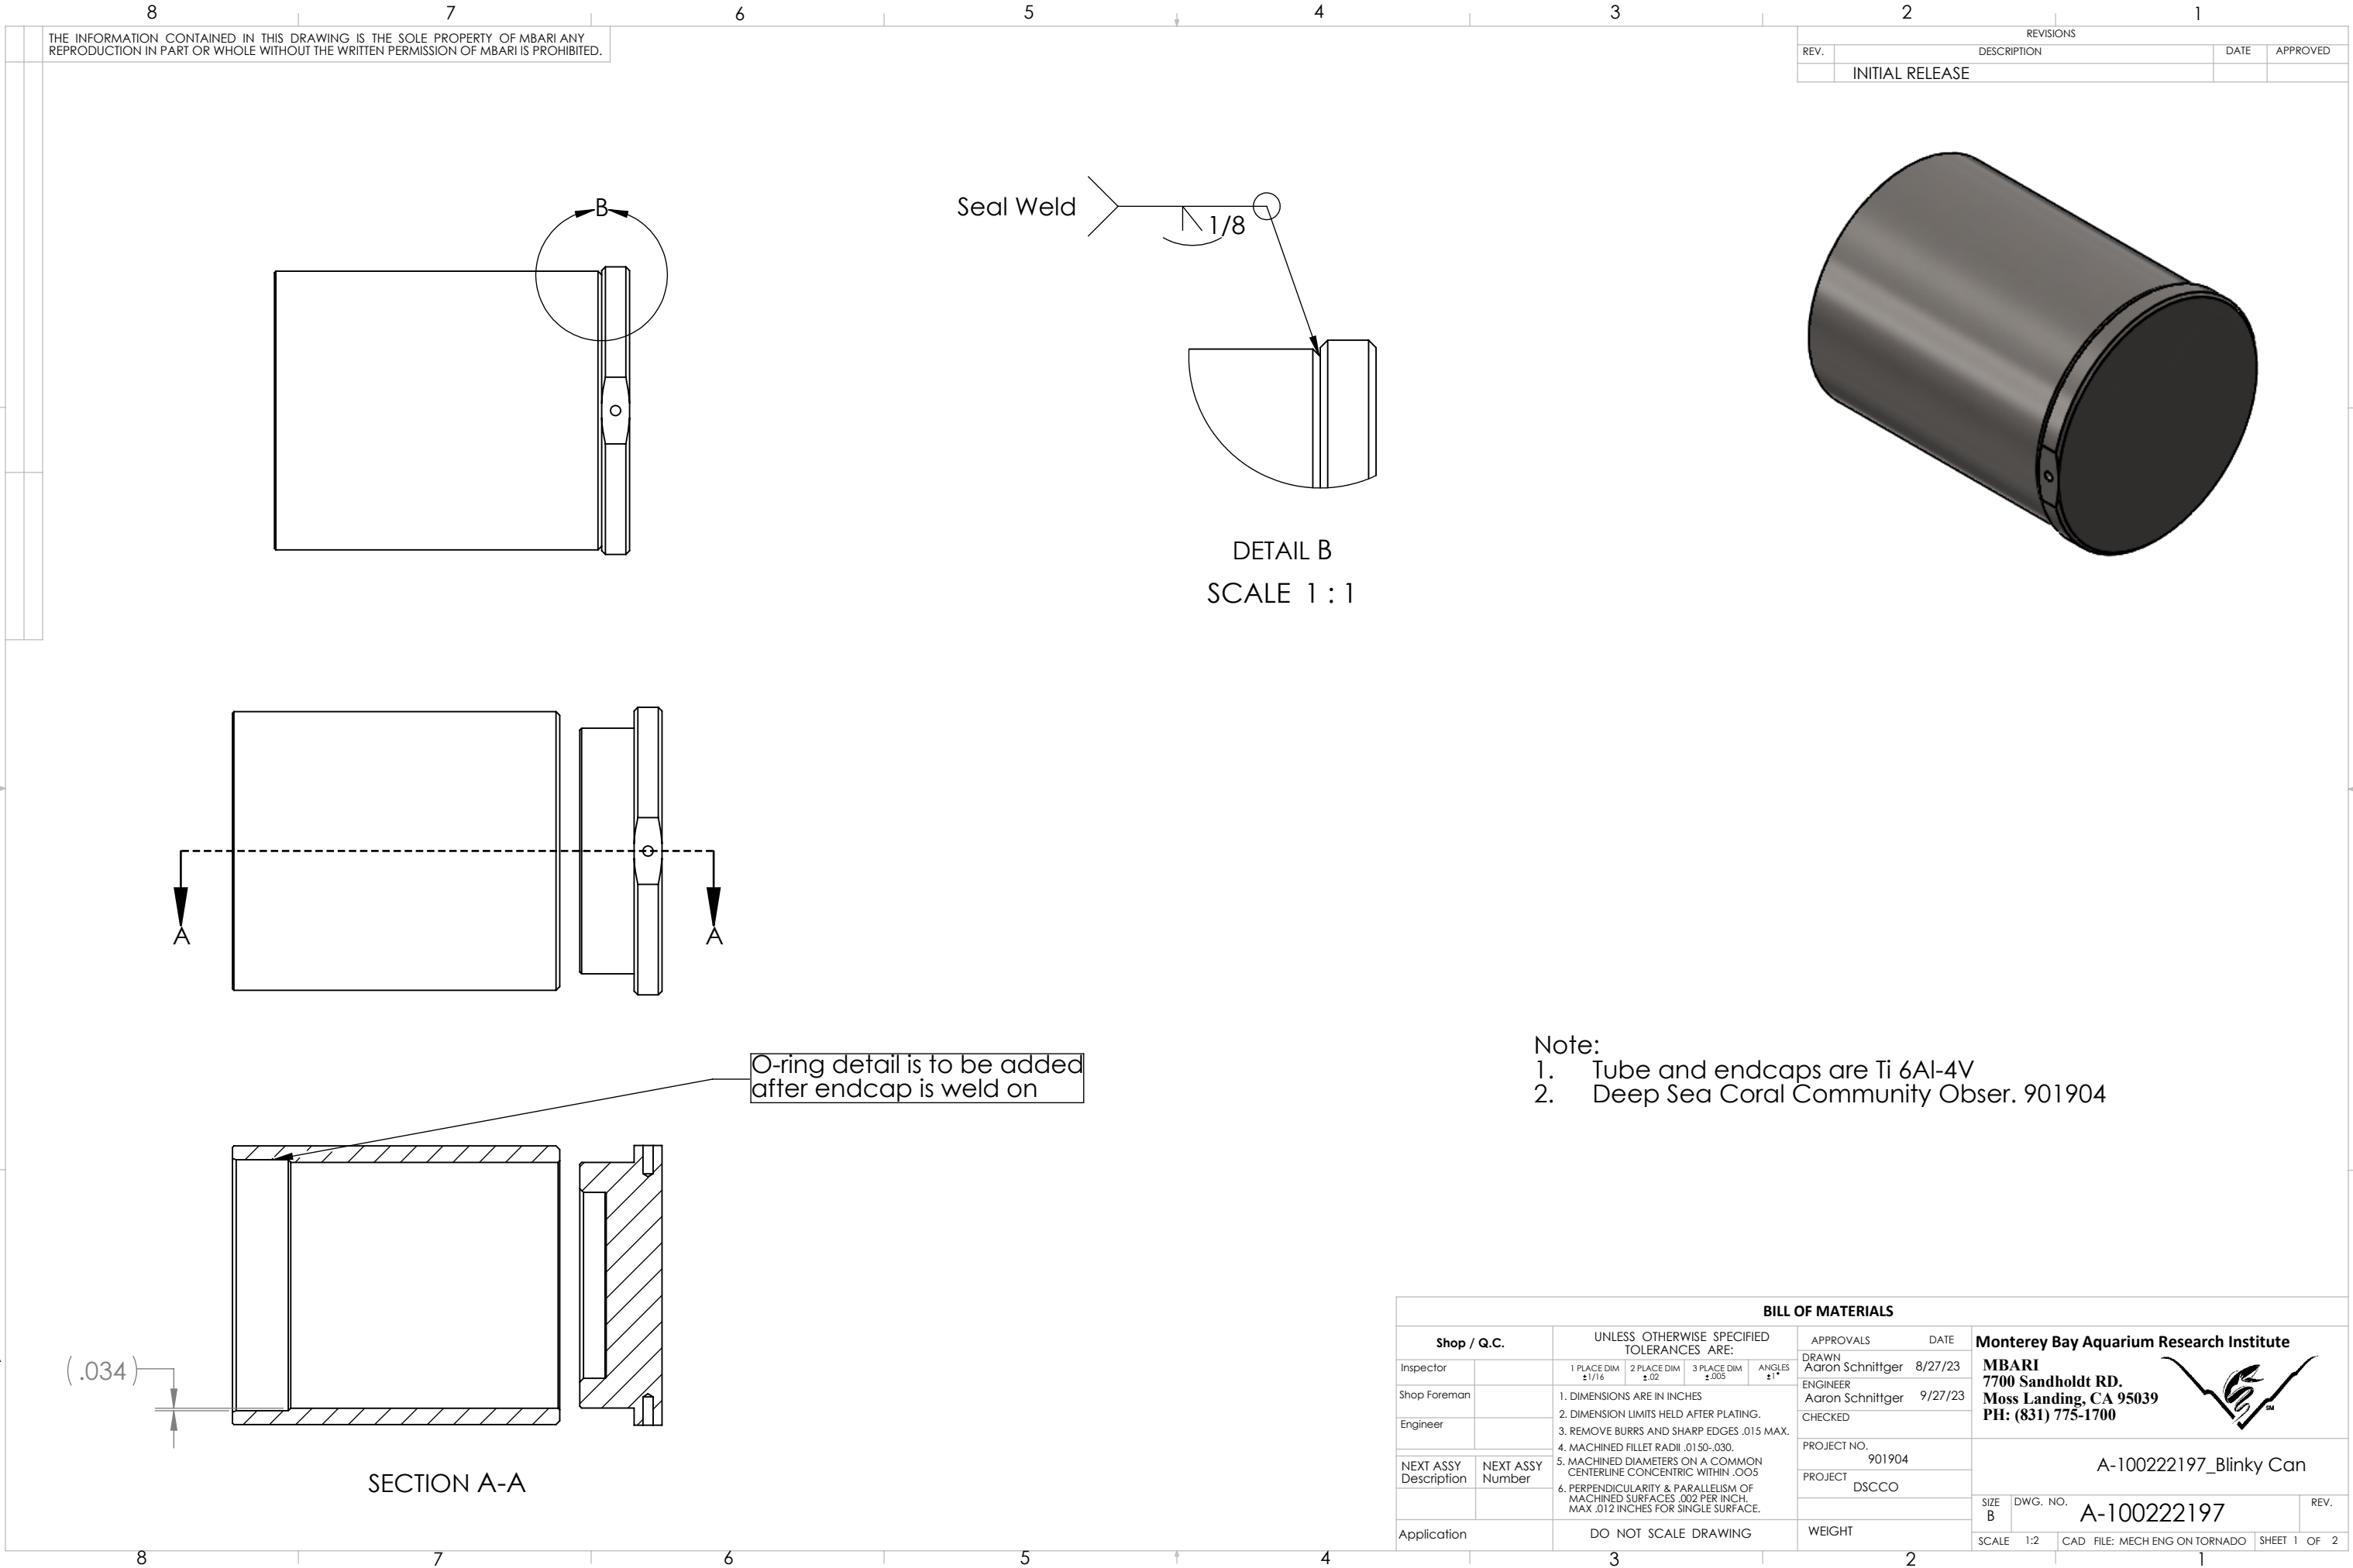

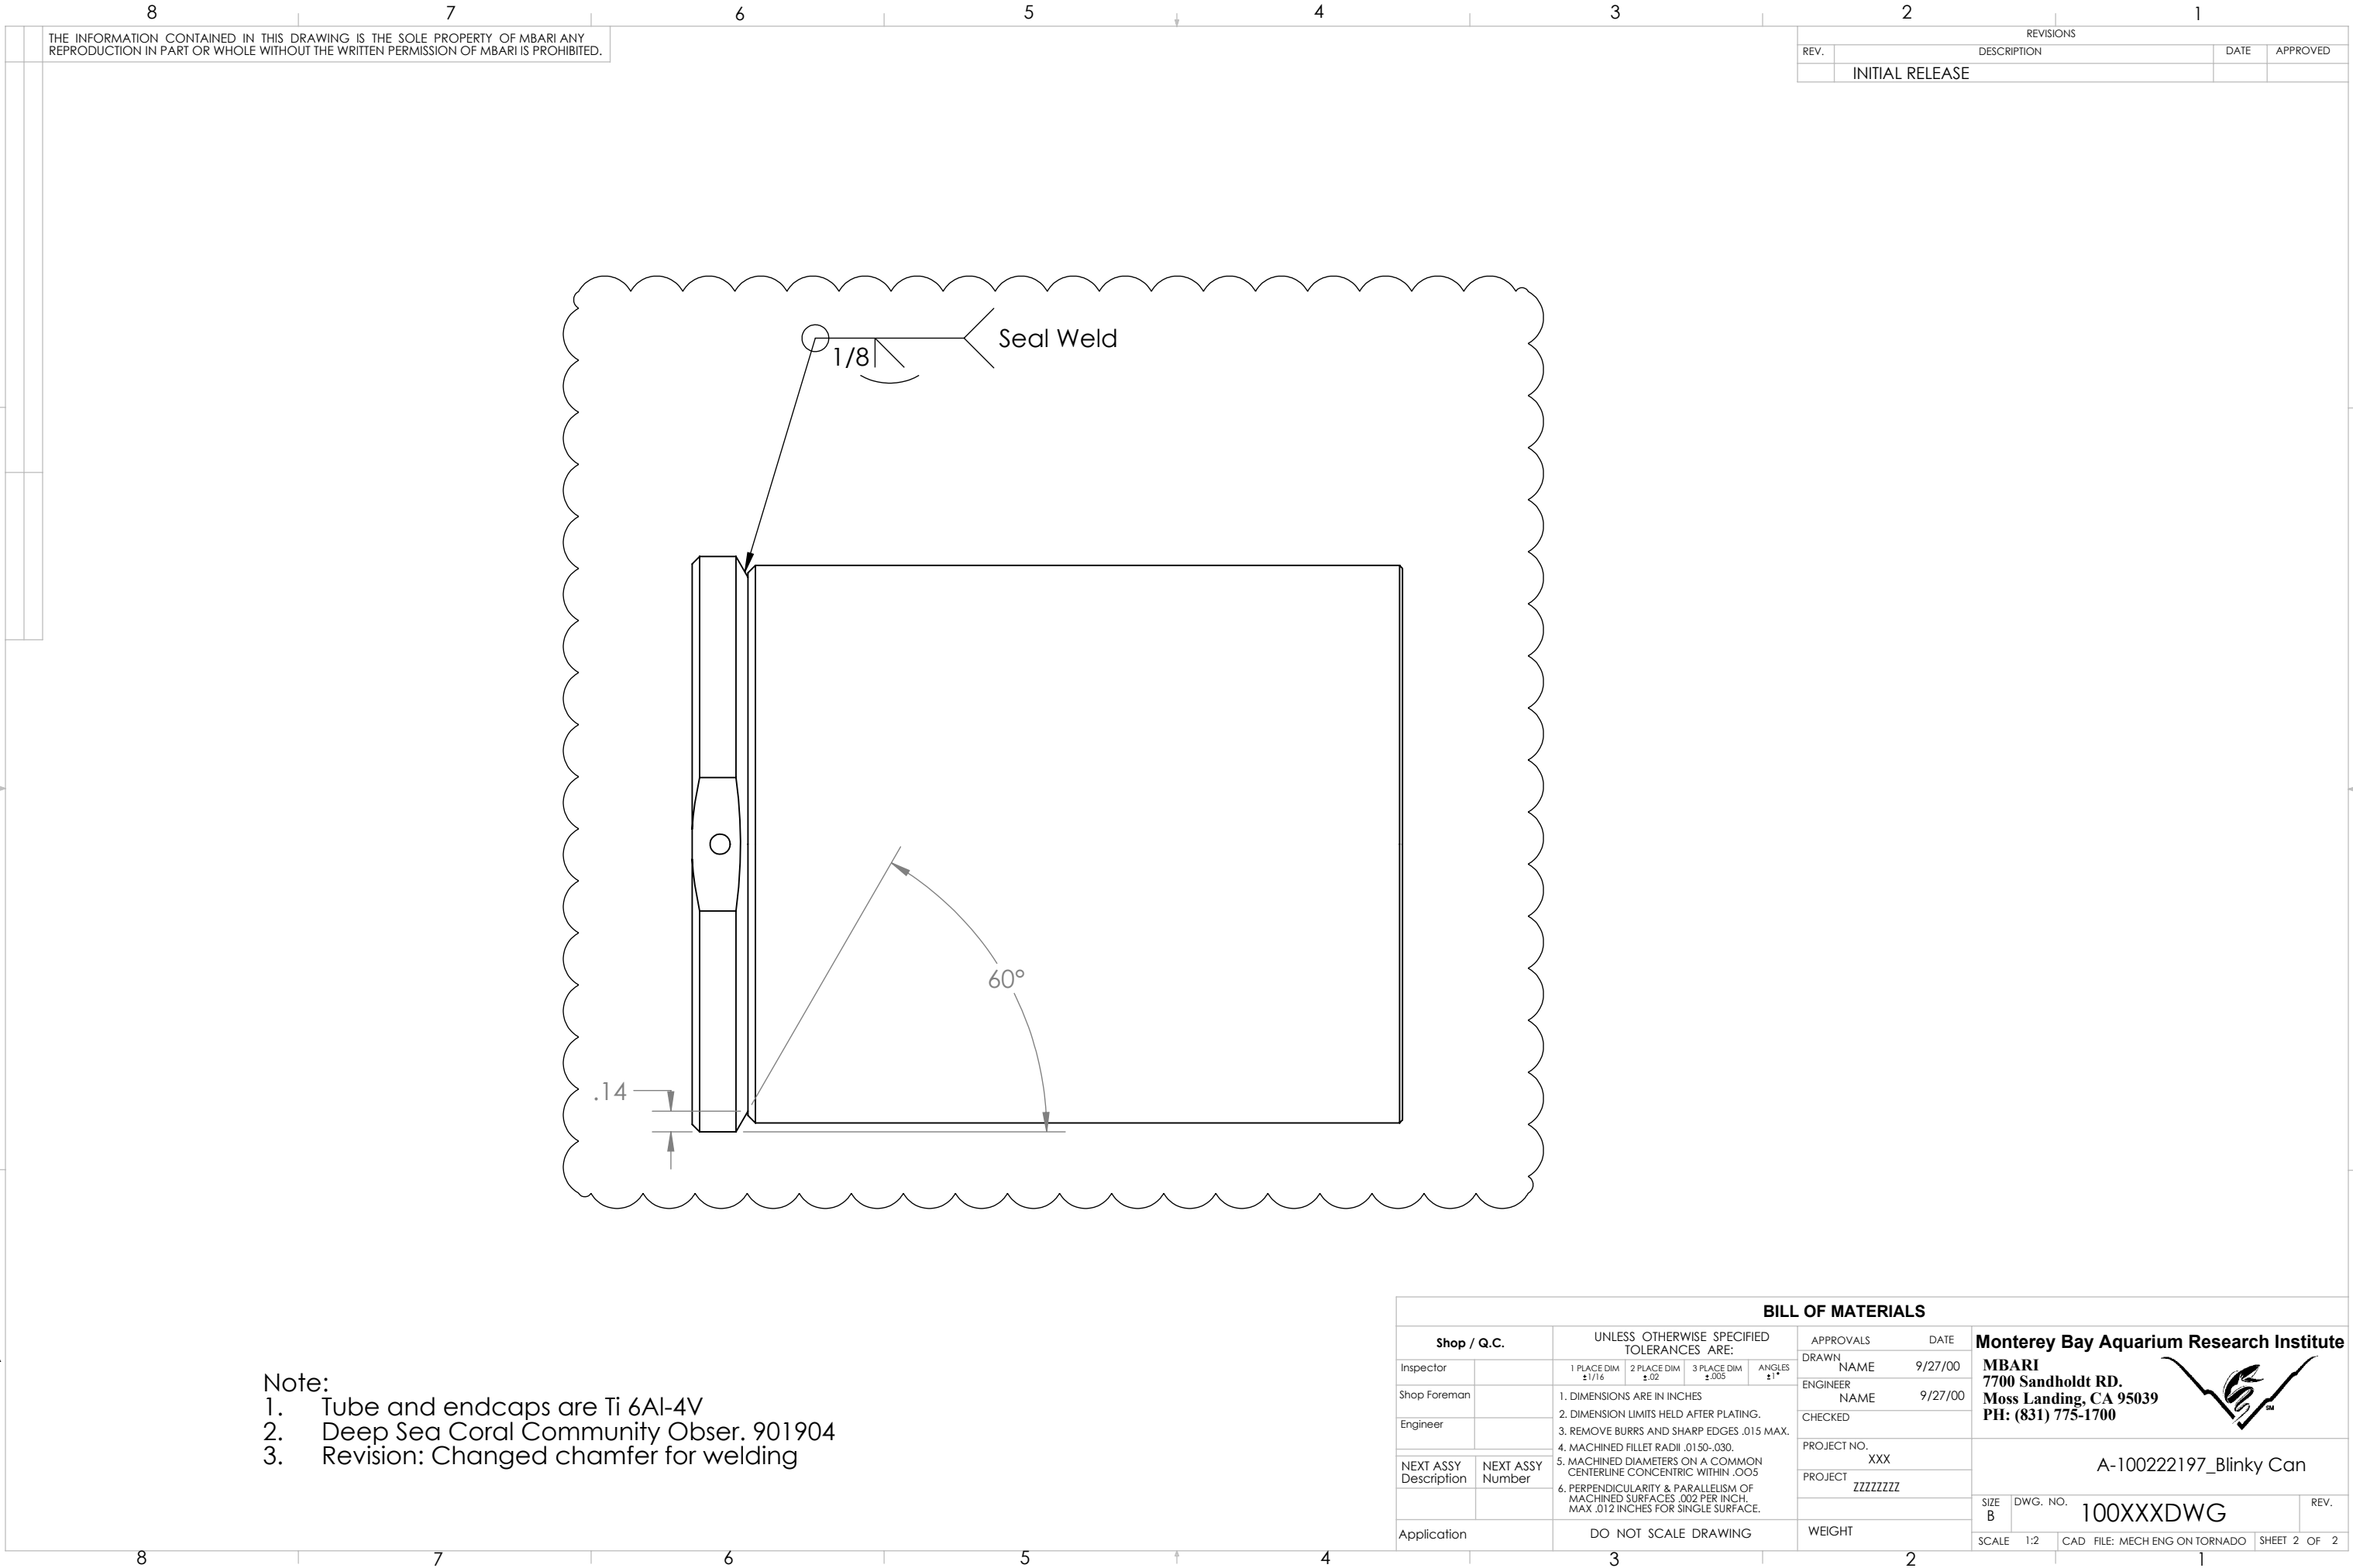

THE INFORMATION CONTAINED IN THIS DRAWING IS THE SOLE PROPERTY OF MBARI ANY REPRODUCTION IN PART OR WHOLE WITHOUT THE WRITTEN PERMISSION OF MBARI IS PROHIBITED.

REVISIONS			
REV.	DESCRIPTION	DATE	APPROVED
	INITIAL RELEASE		

- Note:
- 1. Tube and endcaps are Ti 6Al-4V
 - 2. Deep Sea Coral Community Obser. 901904
 - 3. Revision: Changed chamfer for welding

BILL OF MATERIALS											
Shop / Q.C.		UNLESS OTHERWISE SPECIFIED TOLERANCES ARE:				APPROVALS		DATE		Monterey Bay Aquarium Research Institute MBARI 7700 Sandholdt RD. Moss Landing, CA 95039 PH: (831) 775-1700  A-100222197_Blinky Can	
Inspector		1 PLACE DIM ±1/16	2 PLACE DIM ±.02	3 PLACE DIM ±.005	ANGLES ±1°	DRAWN	NAME	9/27/00			
Shop Foreman		1. DIMENSIONS ARE IN INCHES 2. DIMENSION LIMITS HELD AFTER PLATING. 3. REMOVE BURRS AND SHARP EDGES .015 MAX. 4. MACHINED FILLET RADII .0150-.030. 5. MACHINED DIAMETERS ON A COMMON CENTERLINE CONCENTRIC WITHIN .005 6. PERPENDICULARITY & PARALLELISM OF MACHINED SURFACES .002 PER INCH, MAX .012 INCHES FOR SINGLE SURFACE.				ENGINEER	NAME	9/27/00			
Engineer						CHECKED					
NEXT ASSY Description	NEXT ASSY Number					PROJECT NO.	XXX		SIZE B		
						PROJECT	ZZZZZZZZ				
Application		DO NOT SCALE DRAWING				WEIGHT				SCALE	1:2
										CAD	FILE: MECH ENG ON TORNADO
										SHEET	2 OF 2