


THE INFORMATION CONTAINED IN THIS DRAWING IS THE SOLE PROPERTY OF MBARI ANY REPRODUCTION IN PART OR WHOLE WITHOUT THE WRITTEN PERMISSION OF MBARI IS PROHIBITED.

REVISIONS


ZONE	REV.	DESCRIPTION	DATE	APPROVED
C2	A	Bored 3.030 Hole, 6-40 thread was 6-32	9/27/2010	

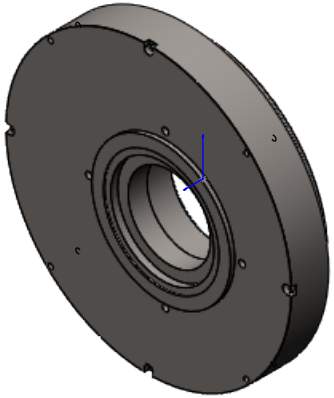


Leave Sharp, 0.000r




DETAIL E
SCALE 1 : 1

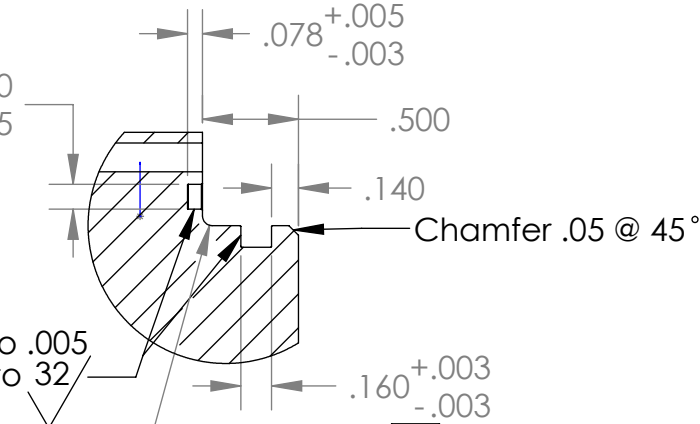



DETAIL B
SCALE 1 : 1

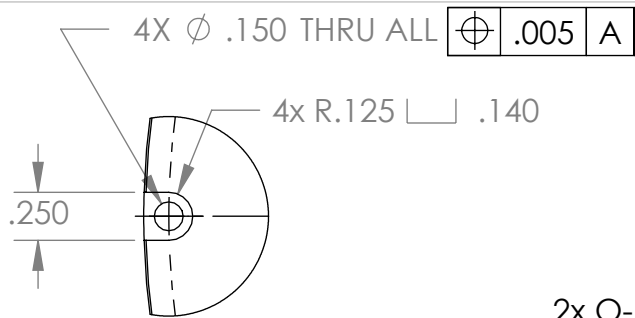

DETAIL F
SCALE 1 : 1

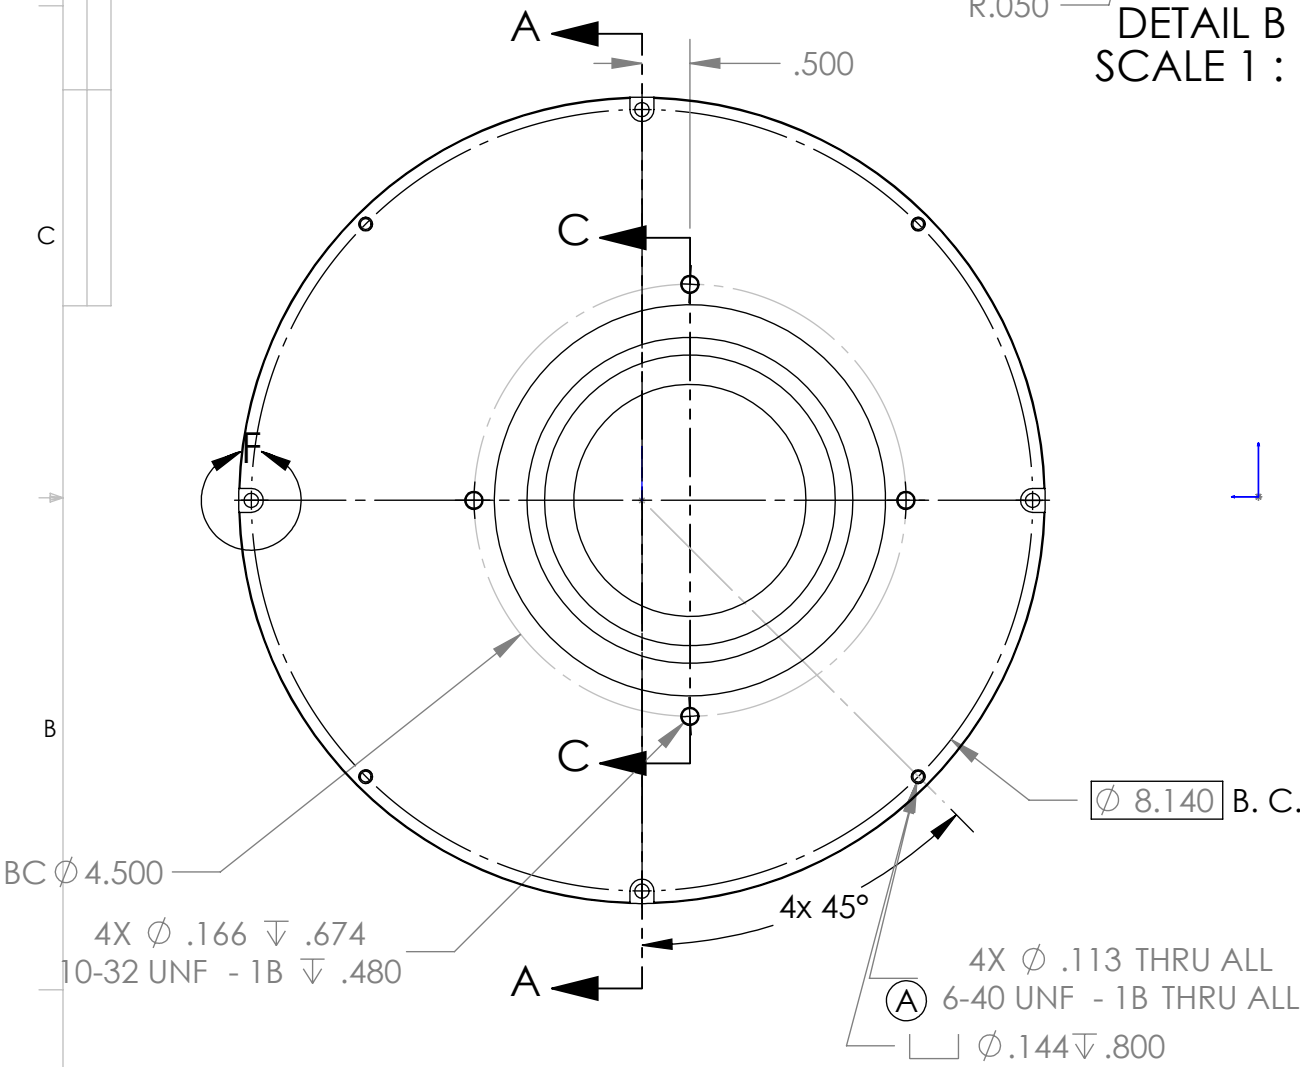

SECTION A-A
SCALE 1 : 2

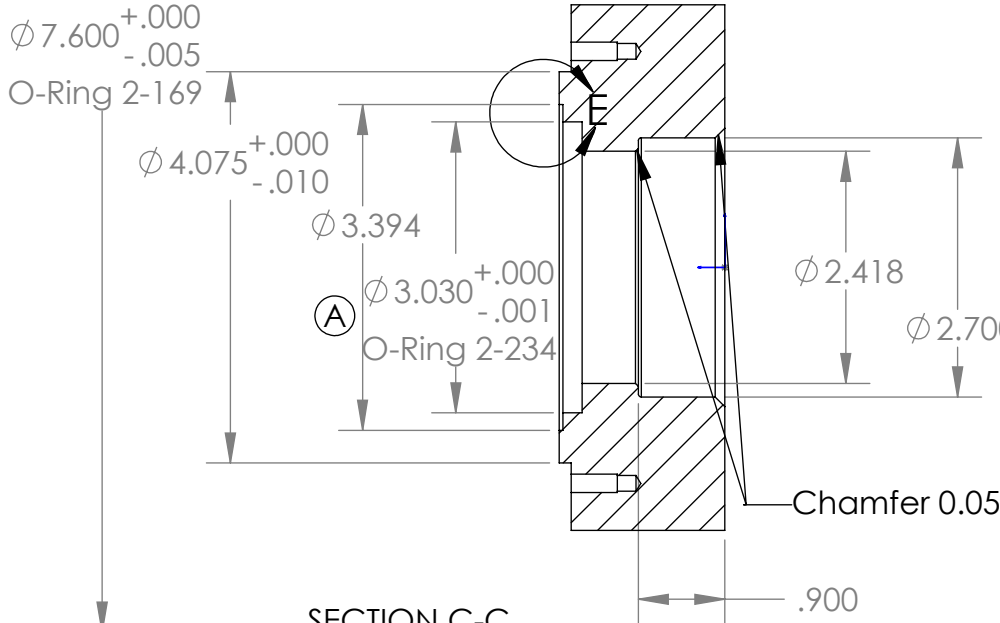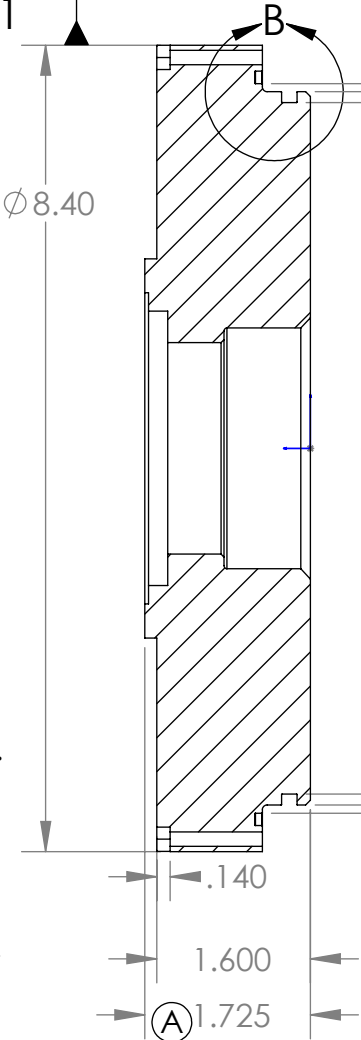

SECTION C-C
SCALE 1 : 2

1	1	P200941-10	MSTF Camera Front Endcap	MBARI	6Al-4V Titanium
ITEM NO.	QTY.	Part_Number	DESCRIPTION	Vendor	MATERIAL

BILL OF MATERIALS

NEXT ASSY Description	NEXT ASSY Number	UNLESS OTHERWISE SPECIFIED TOLERANCES ARE:				APPROVALS	DATE	Monterey Bay Aquarium Research Institute MBARI 7700 Sandholdt RD. Moss Landing, CA 95039 PH: (831) 775-1700 
		1 PLACE DIM ±1/16	2 PLACE DIM ±.02	3 PLACE DIM ±.005	ANGLES ±1°	DRAWN	11/15/2001	
						ENGINEER	B. Hobson	
						CHECKED	J. Erickson	
						PROJECT NO.	900622	
THIRD ANGLE PROJECTION		1. DIMENSIONS ARE IN INCHES 2. DIMENSION LIMITS HELD AFTER PLATING. 3. REMOVE BURRS AND SHARP EDGES .015 MAX. 4. MACHINED FILLET RADII .0150-.030. 5. MACHINED DIAMETERS ON A COMMON CENTERLINE CONCENTRIC WITHIN .005 6. PERPENDICULARITY & PARALLELISM OF MACHINED SURFACES .002 PER INCH, MAX .012 INCHES FOR SINGLE SURFACE.				PROJECT		MSTF Camera Front Endcap
		DO NOT SCALE DRAWING				WEIGHT		
						SIZE B	DWG. NO. 200941	REV. A
						SCALE 1:4	CAD FILE:	SHEET 1 OF 1

Status: