
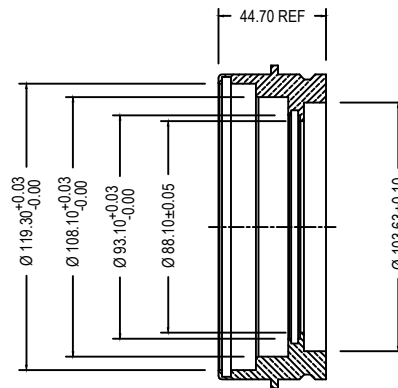
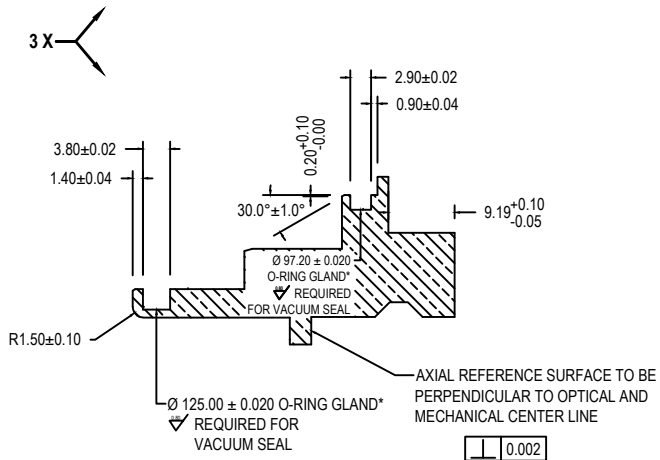
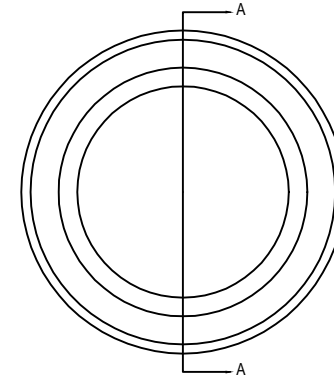
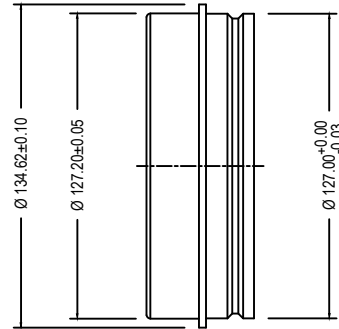


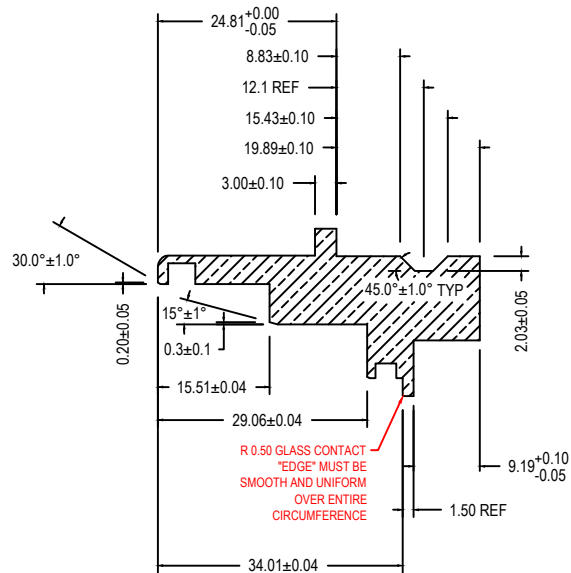

SECTION A - A

MATERIAL: 7075 - T6 ALUMINUM
 BLACK ANODIZE - TYPE II

* Ra 0.8 MICRONS REQUIRED ON O.D.
 SURFACE OF O-RING GLAND TO
 ENSURE VACUUM SEAL. SURFACE
 MUST HAVE UNIFORMLY DIFFUSE
 TEXTURE WITH NO TOOL MARKS.

ALL DIMENSIONS IN MILLIMETERS

TITLE			
CORRECTOR LENS CELL			
DATE	SCALE	DRAWN BY	APPROVED BY
AUGUST 27, 2020	0.5 X	P. REMIJAN	
PROPERTY OF			
FATHOM IMAGING			
PROJECT	DESIGN FILE	REVISIONS	DWG NUMBER
DEEP SEA 4K	89L FINAL - Rev 3		89L - C - 20