



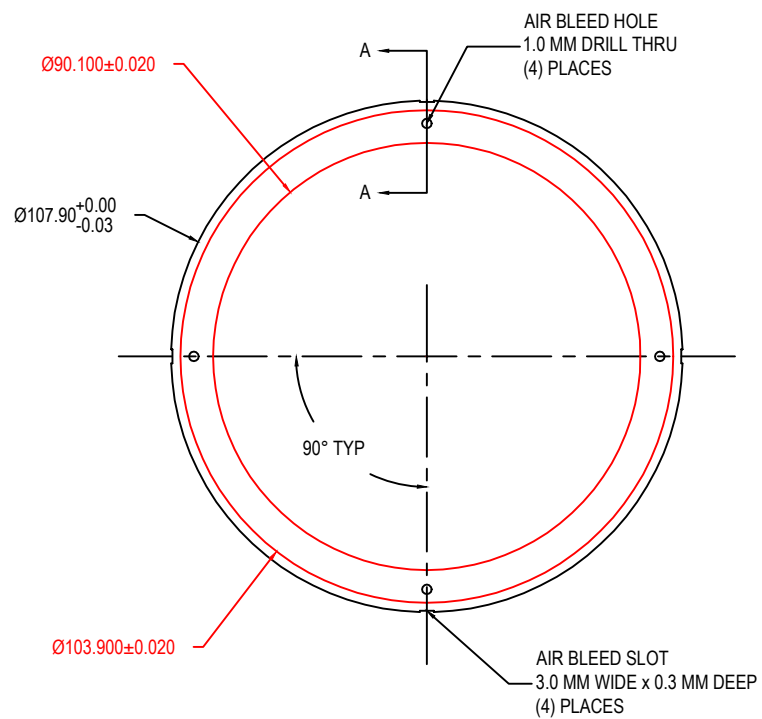

MATERIAL: 7075-T6 ALUMINUM  
BLACK ANODIZE TYPE II

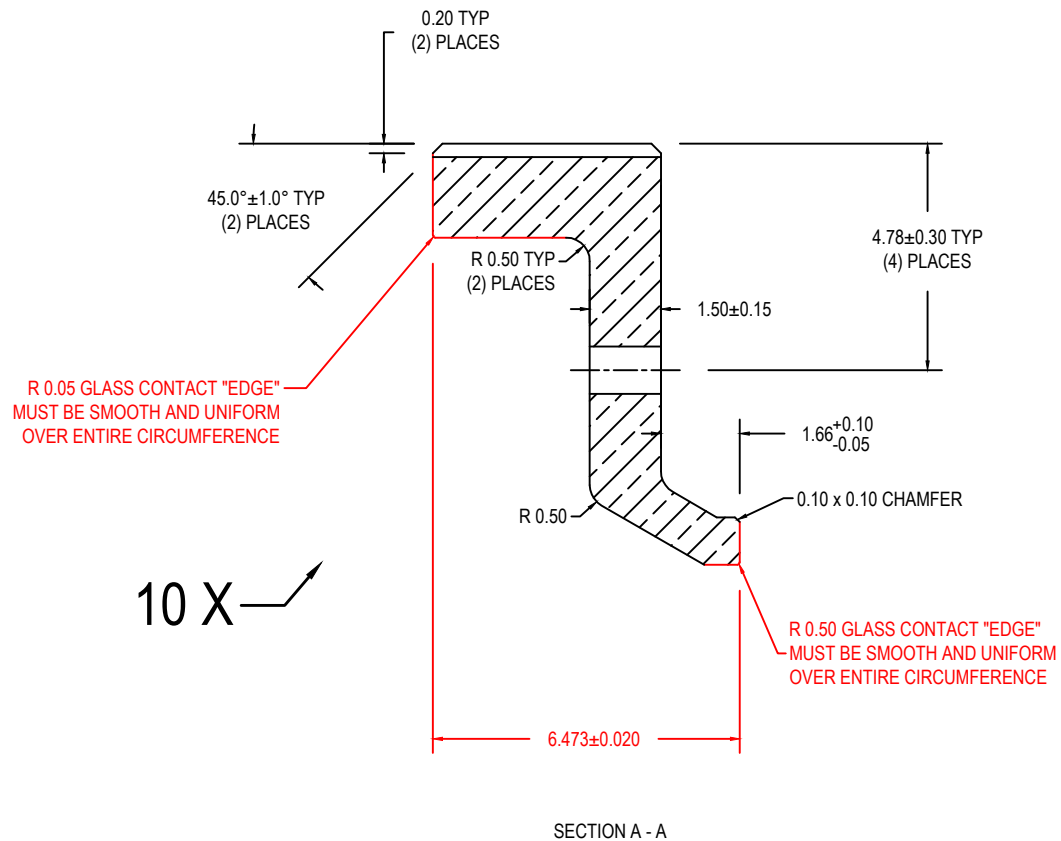

ALL DIMENSIONS IN MILLIMETERS

|                 |                   |            |              |
|-----------------|-------------------|------------|--------------|
| TITLE           |                   |            |              |
| SPACER B        |                   |            |              |
| DATE            | SCALE             | DRAWN BY   | APPROVED BY  |
| AUGUST 27, 2020 | 1 X               | P. REMIJAN |              |
| PROPERTY OF     |                   |            |              |
| FATHOM IMAGING  |                   |            |              |
| PROJECT         | DESIGN FILE       | REVISIONS  | DWG NUMBER   |
| DEEP SEA 4K     | 89L FINAL - Rev 3 |            | 89L - C - 22 |