


**Overall (3/3)**

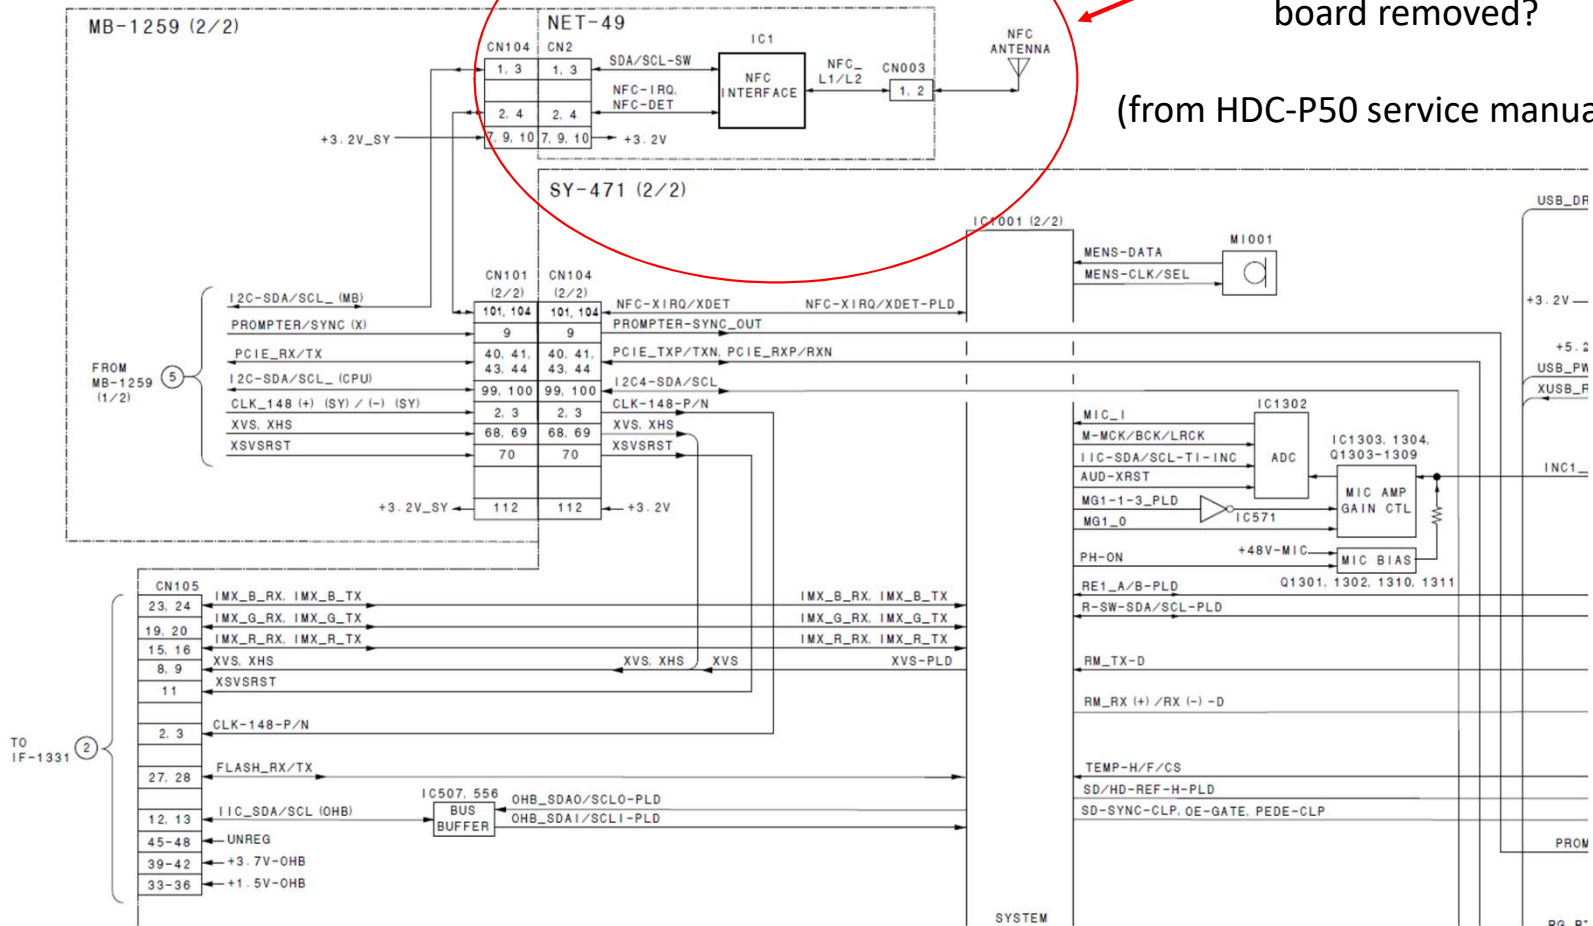

OK to operate HDC-P50  
Camera with NET-49  
board removed?

(from HDC-P50 service manual page 142)