



4K Camera PCB Layout

Ver. 1/4/2021

010421_1100_TopSolderMask.pdf

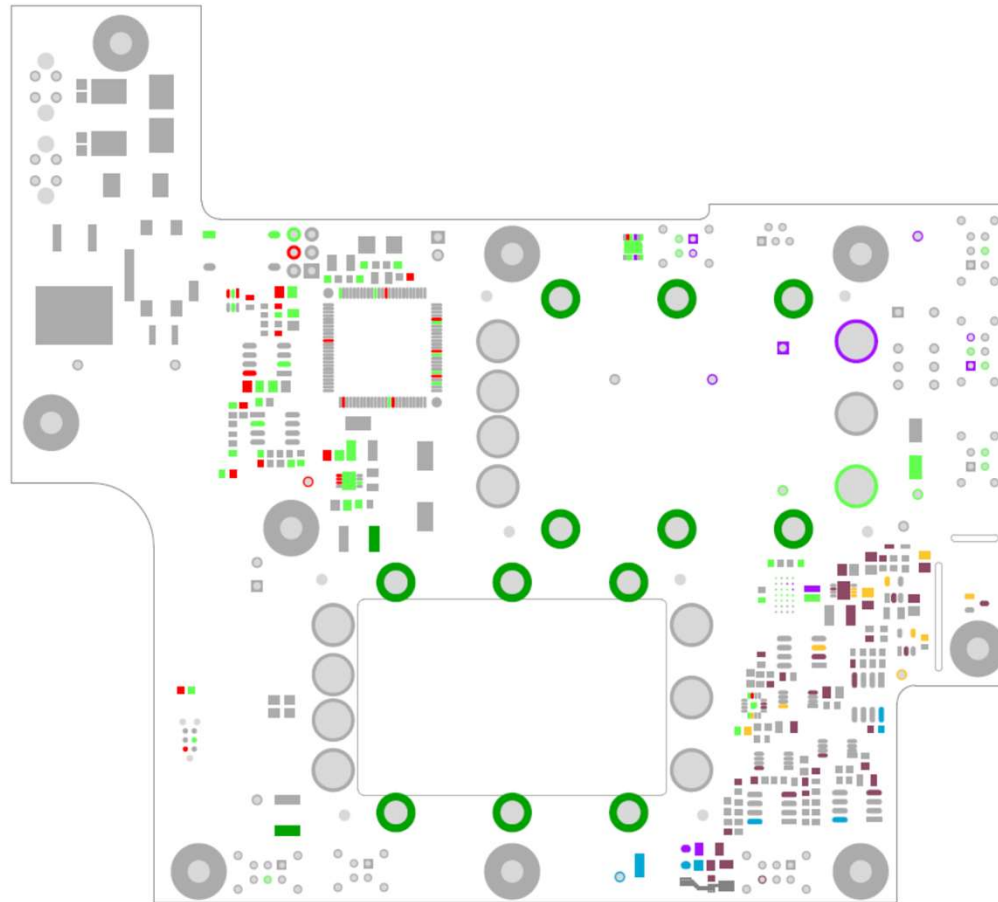


010421_1100_TopPlacement.pdf

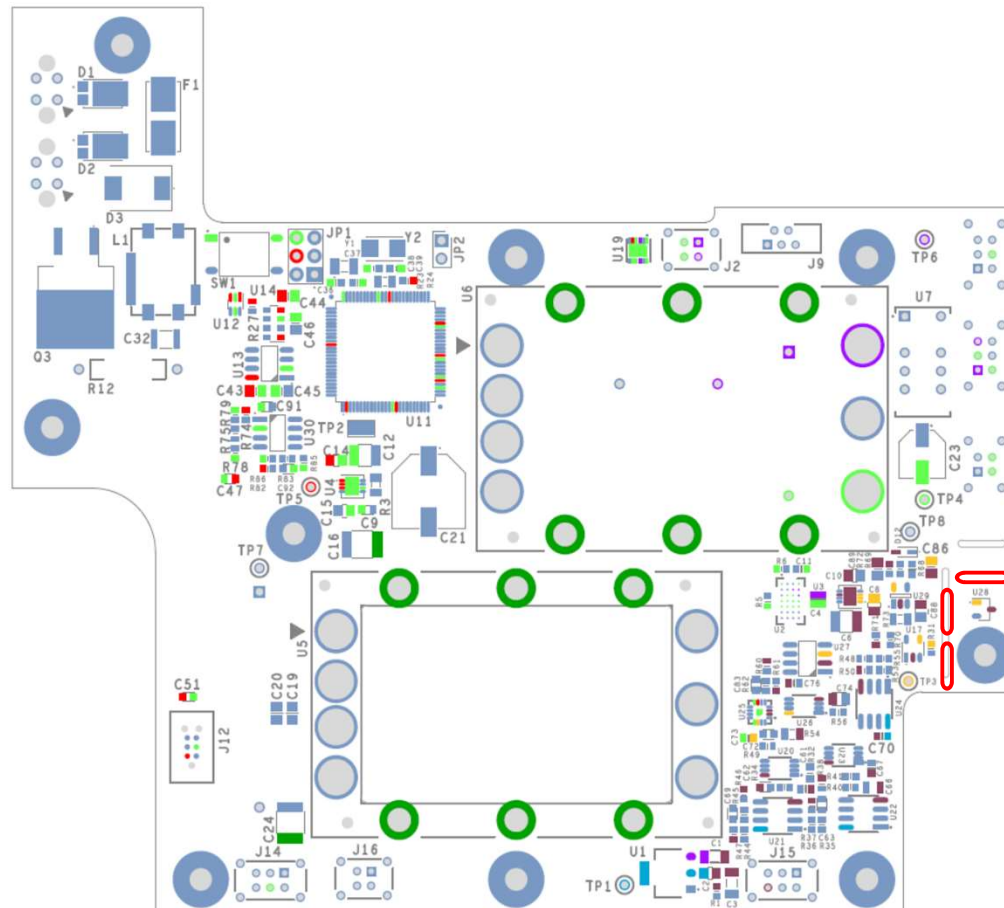


Modify cutouts!
Make closer to
stand-off & U28.


010421_1100_TopCopper.pdf

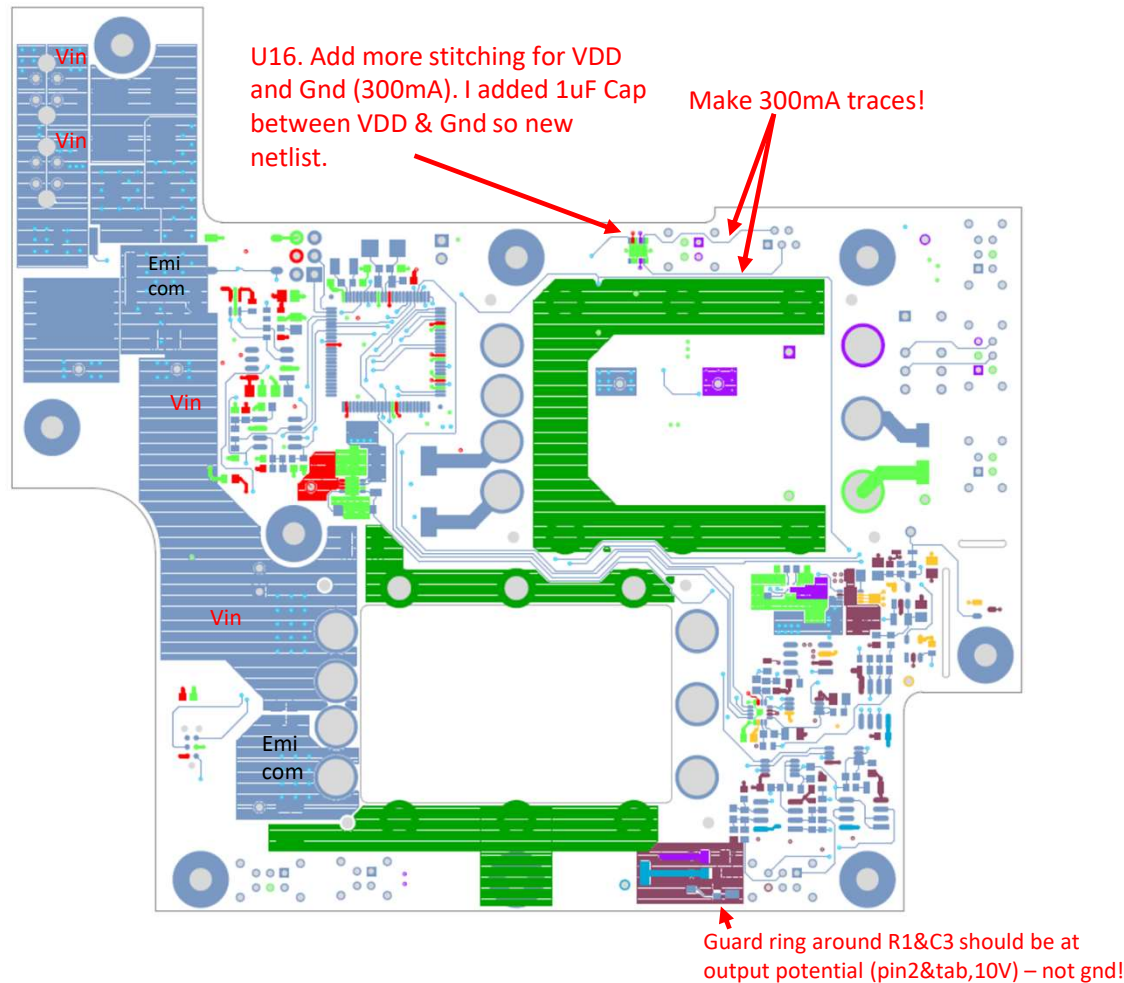


010421_1100_In4Copper.pdf

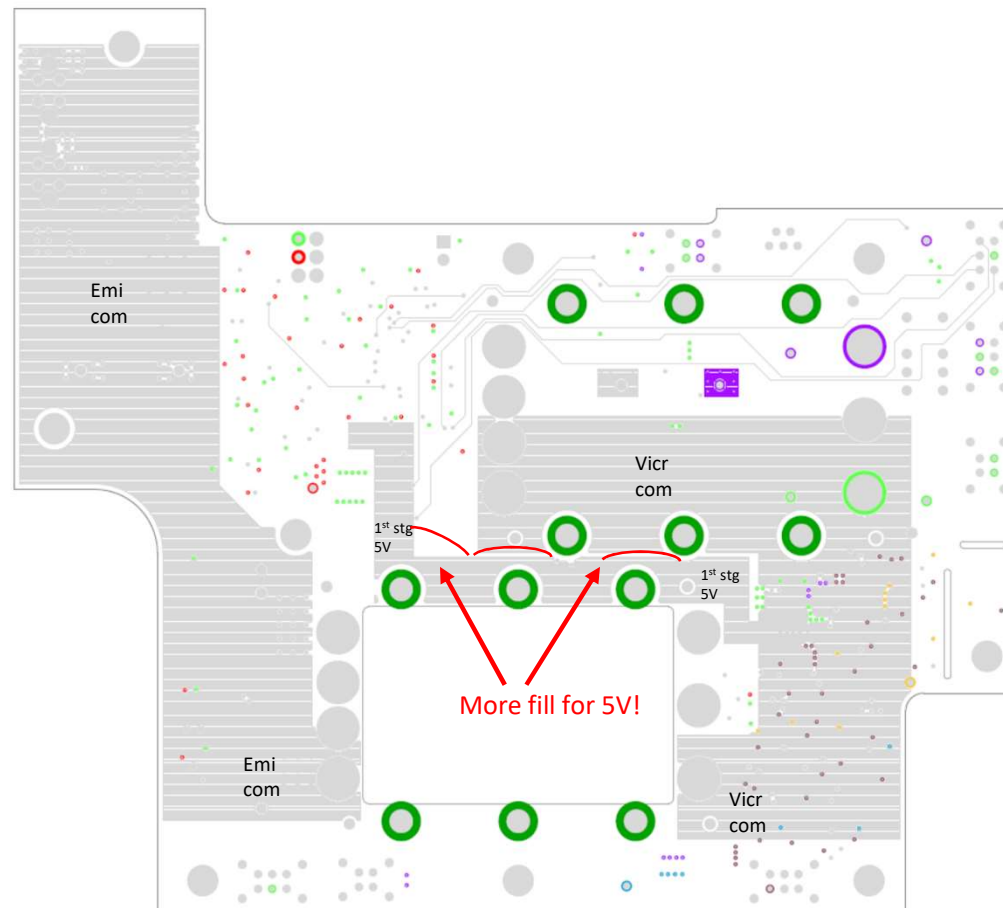


010421_1100_In3Copper.pdf

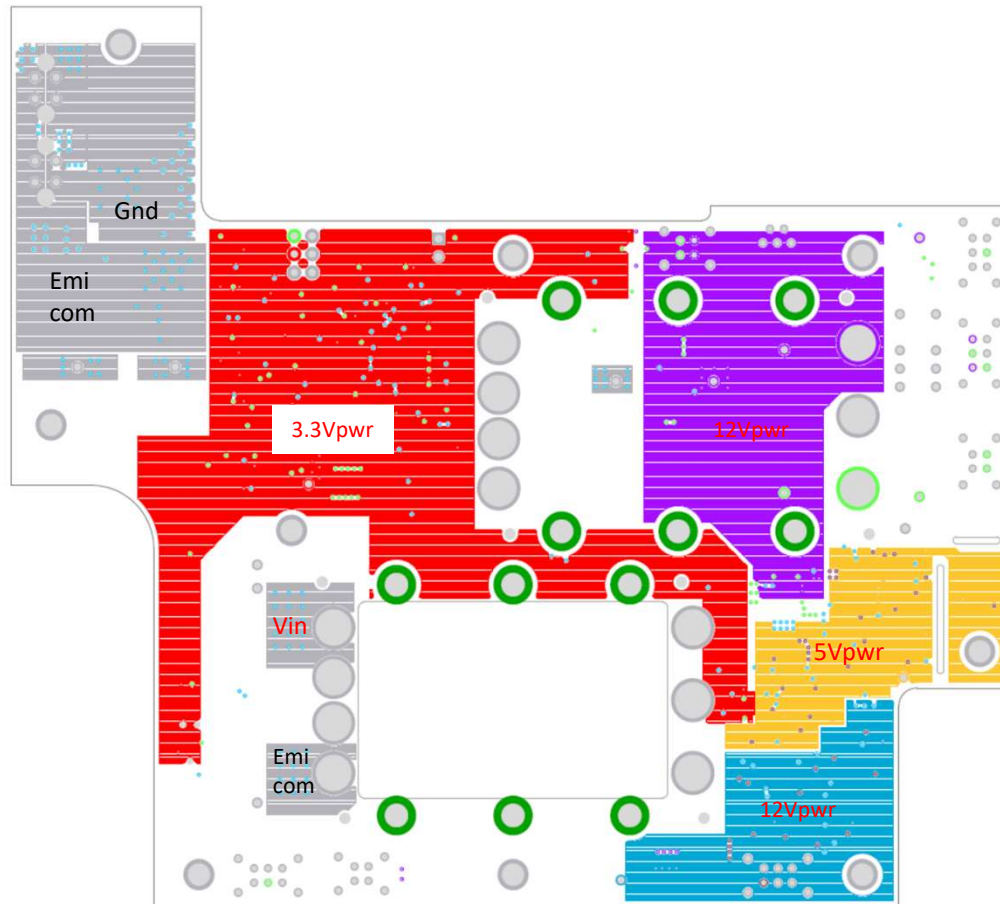


010421_1100_In2Copper.pdf

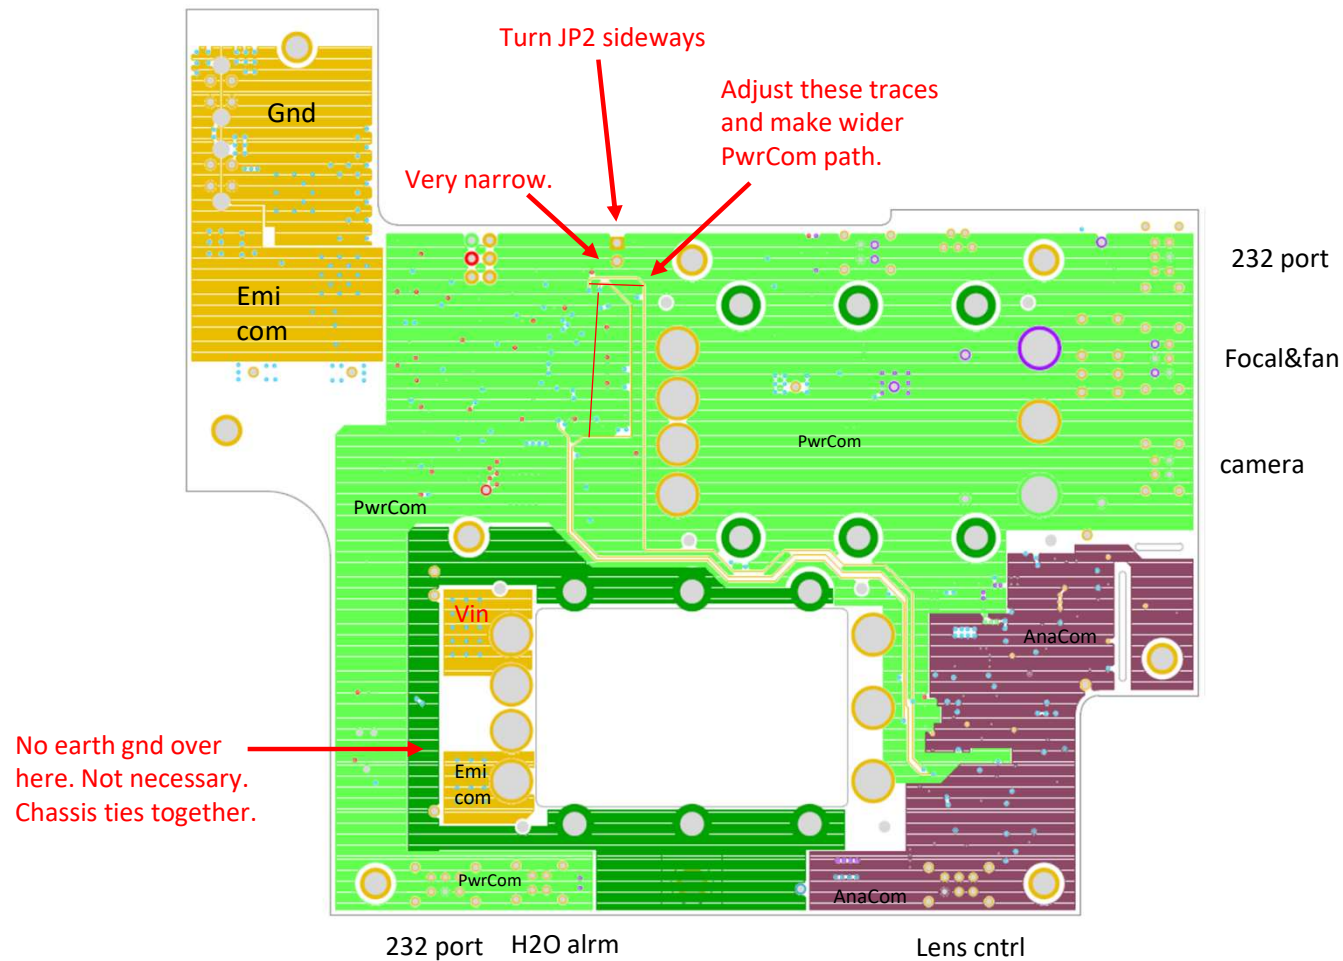


010421_1100_In1Copper.pdf

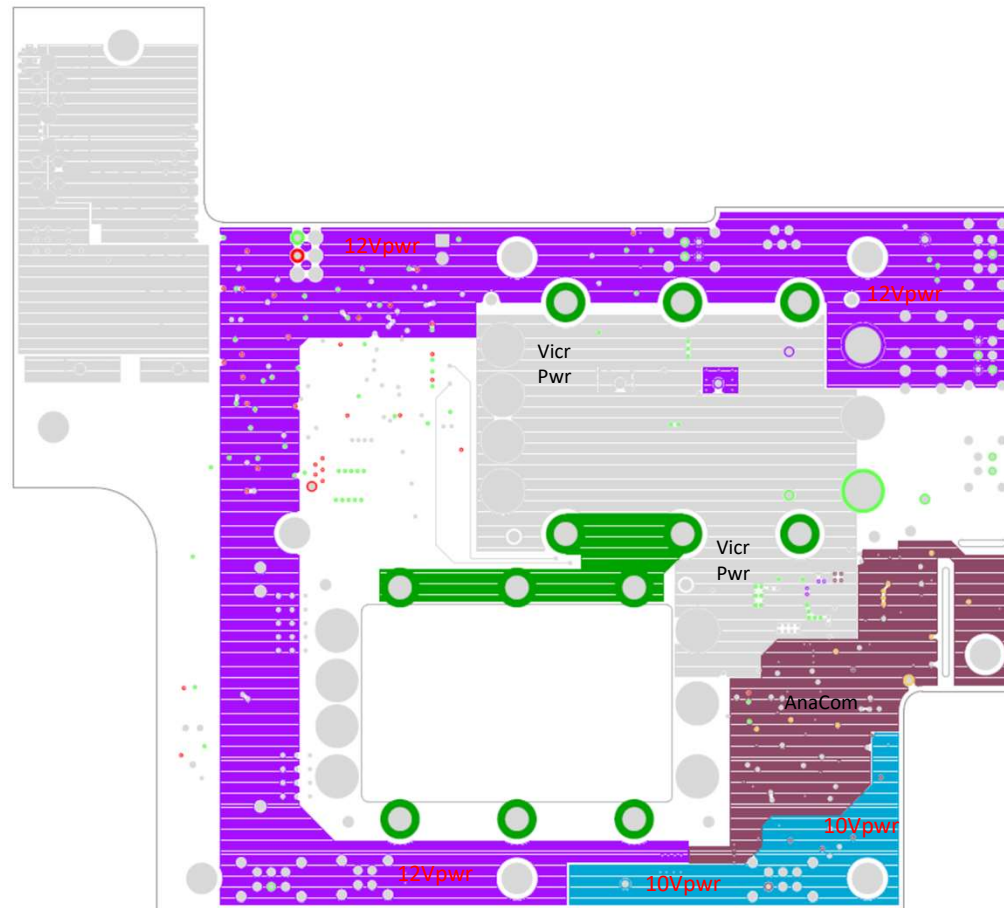

010421_1100_BottomSolderMask.pdf

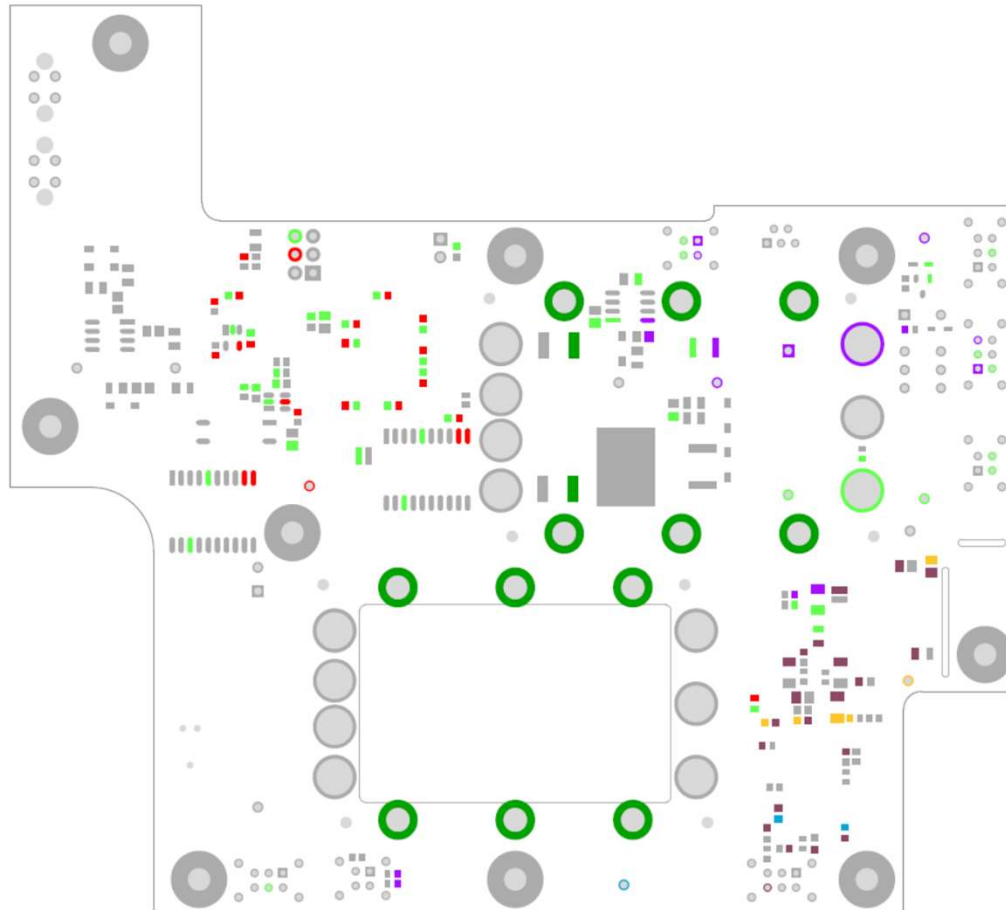

010421_1100_BottomPlacement.pdf

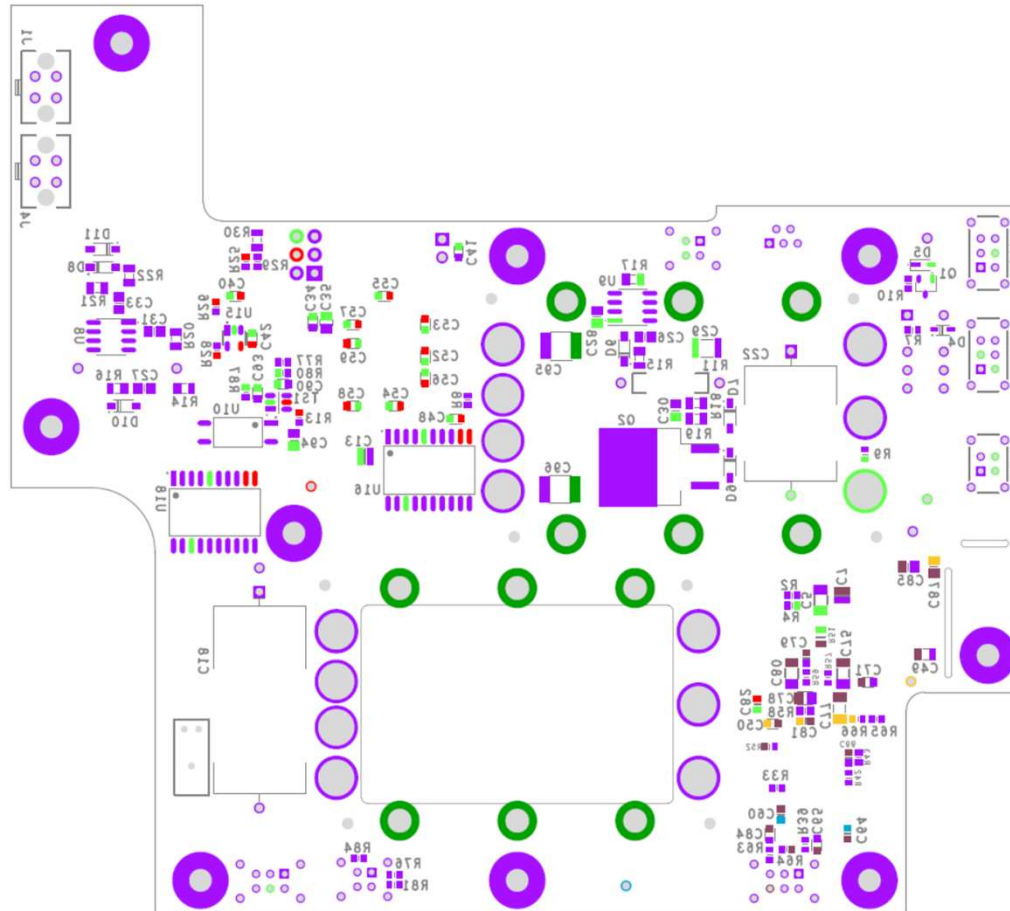

010421_1100_BottomCopper.pdf

