



4K Camera PCB ver.
12/17/20

FEEDBACK ON LAYOUT

TOP PLACEMENT

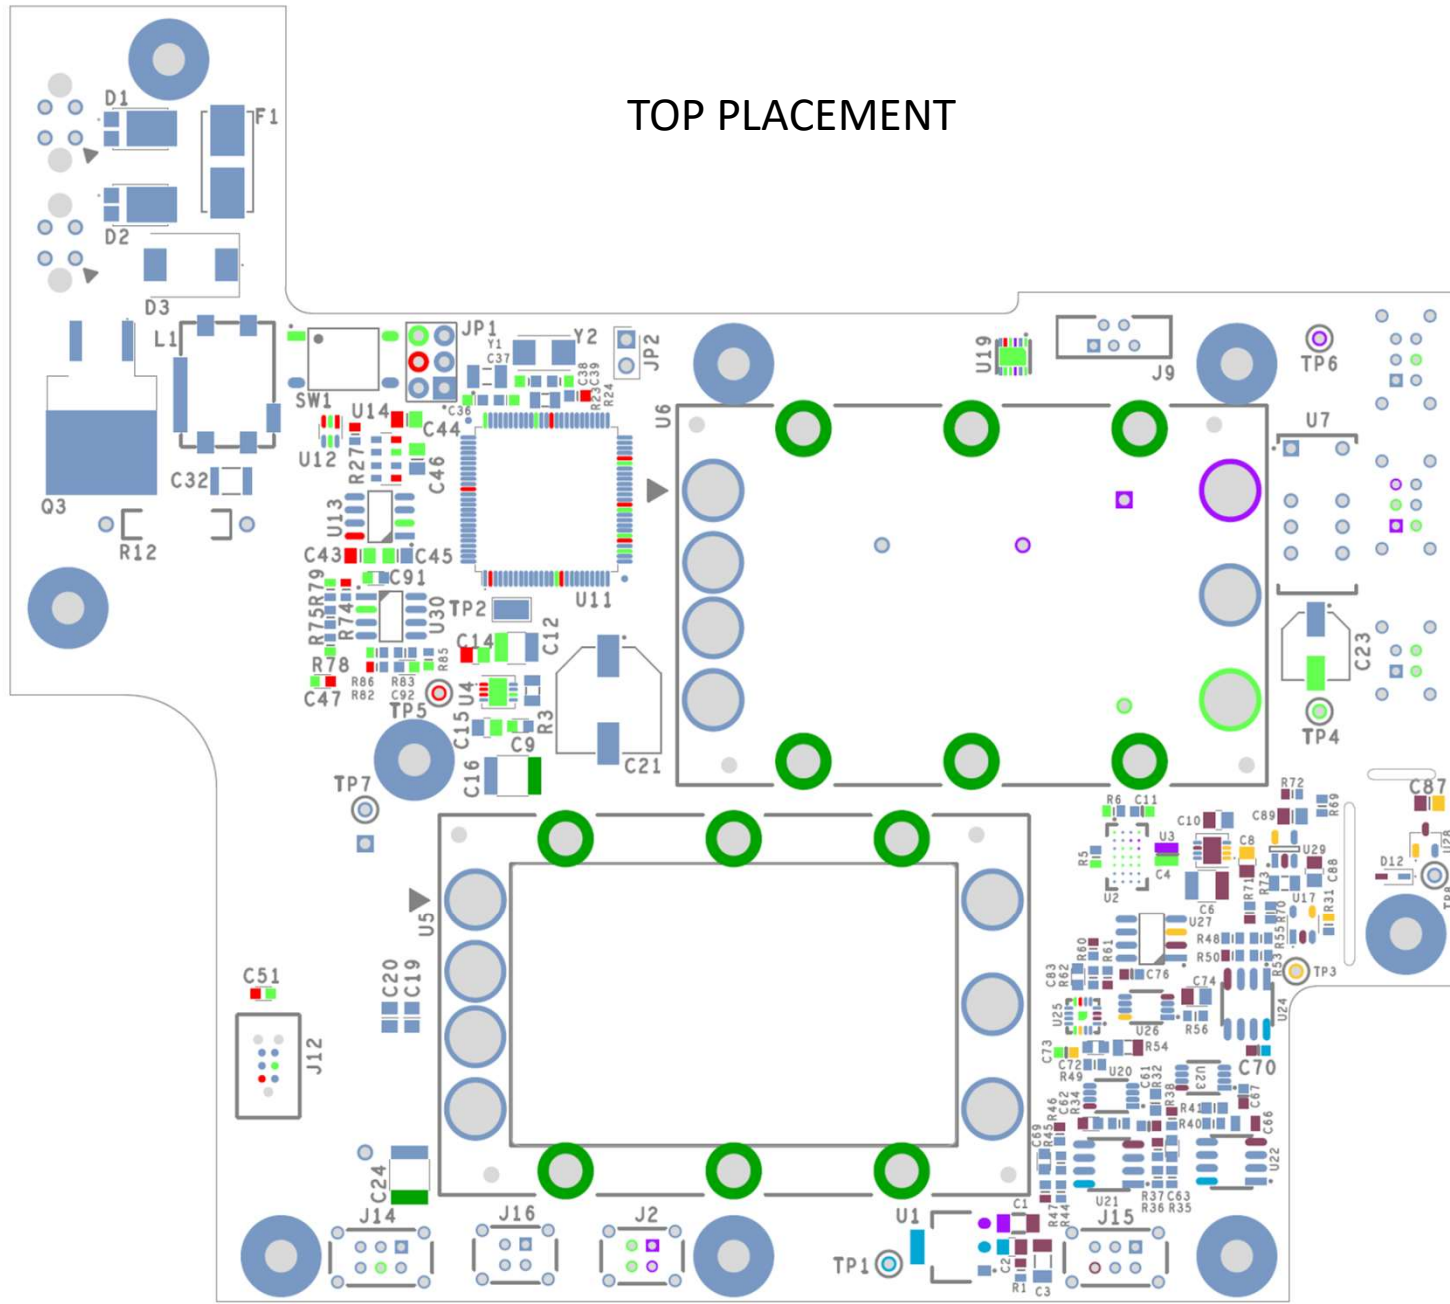

TOP COPPER

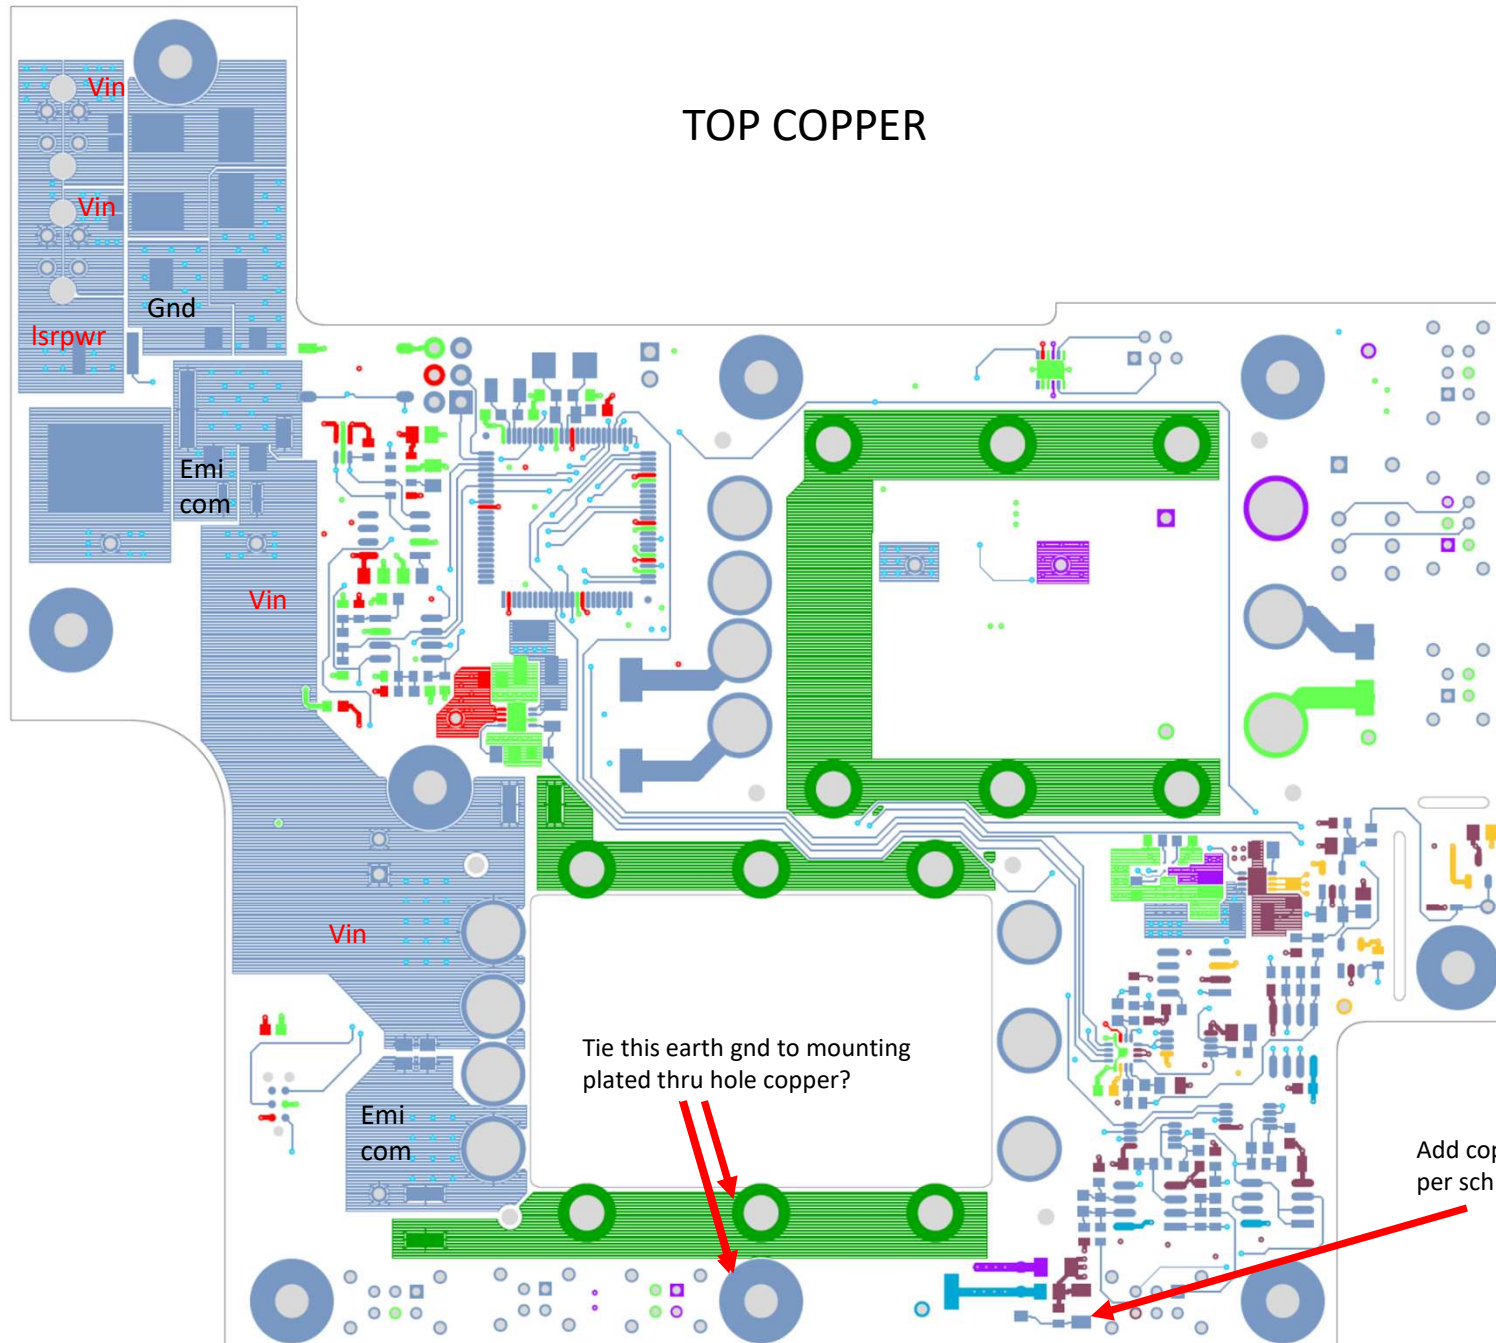

Move components outside thermal cutout area and move U28 as close as possible to mounting hole?


Tie this earth gnd to mounting plated thru hole copper?

Add copper and guard ring as per sch note 2 & 3.

IN4 COPPER


Bunch of traces missing on this layer??

Missing EMI gnd trace?

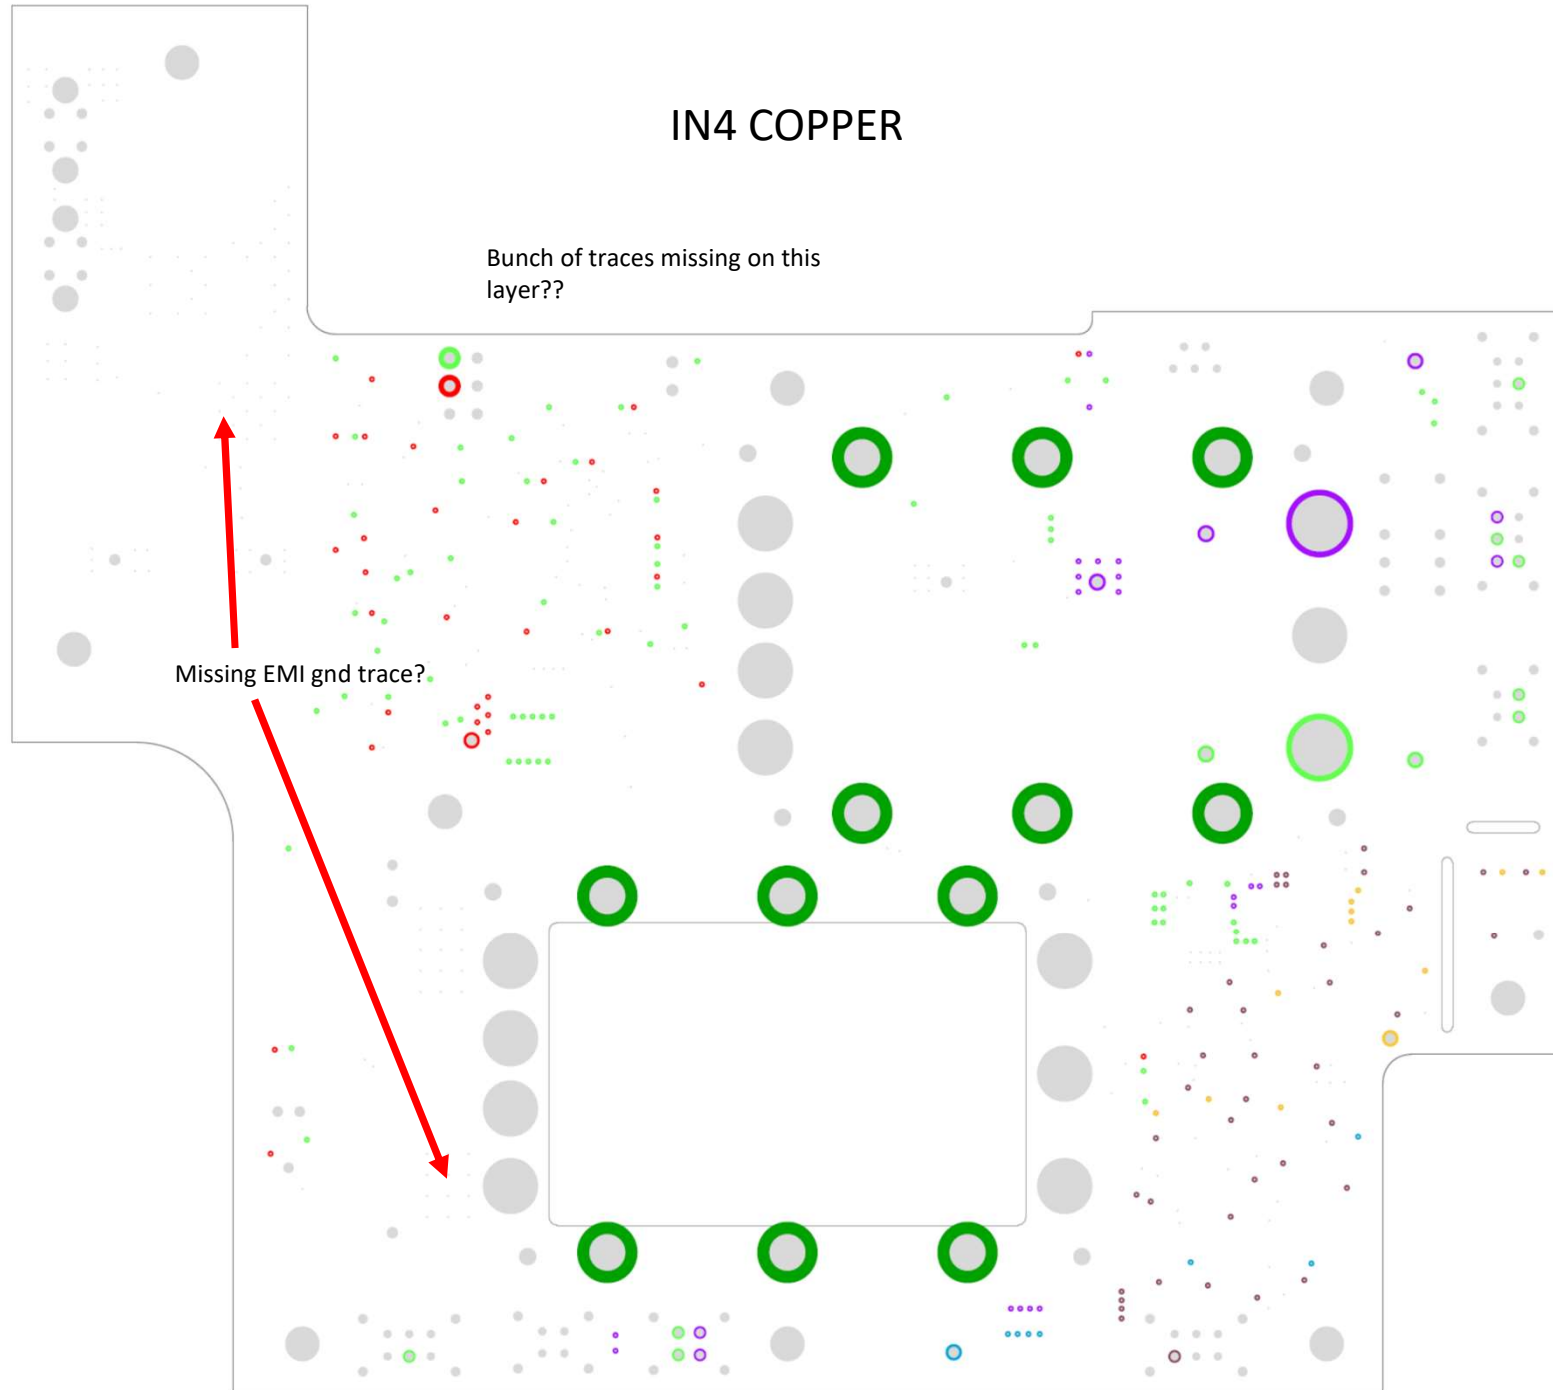


IN3 COPPER

Why not include in 12Vpwr fill?

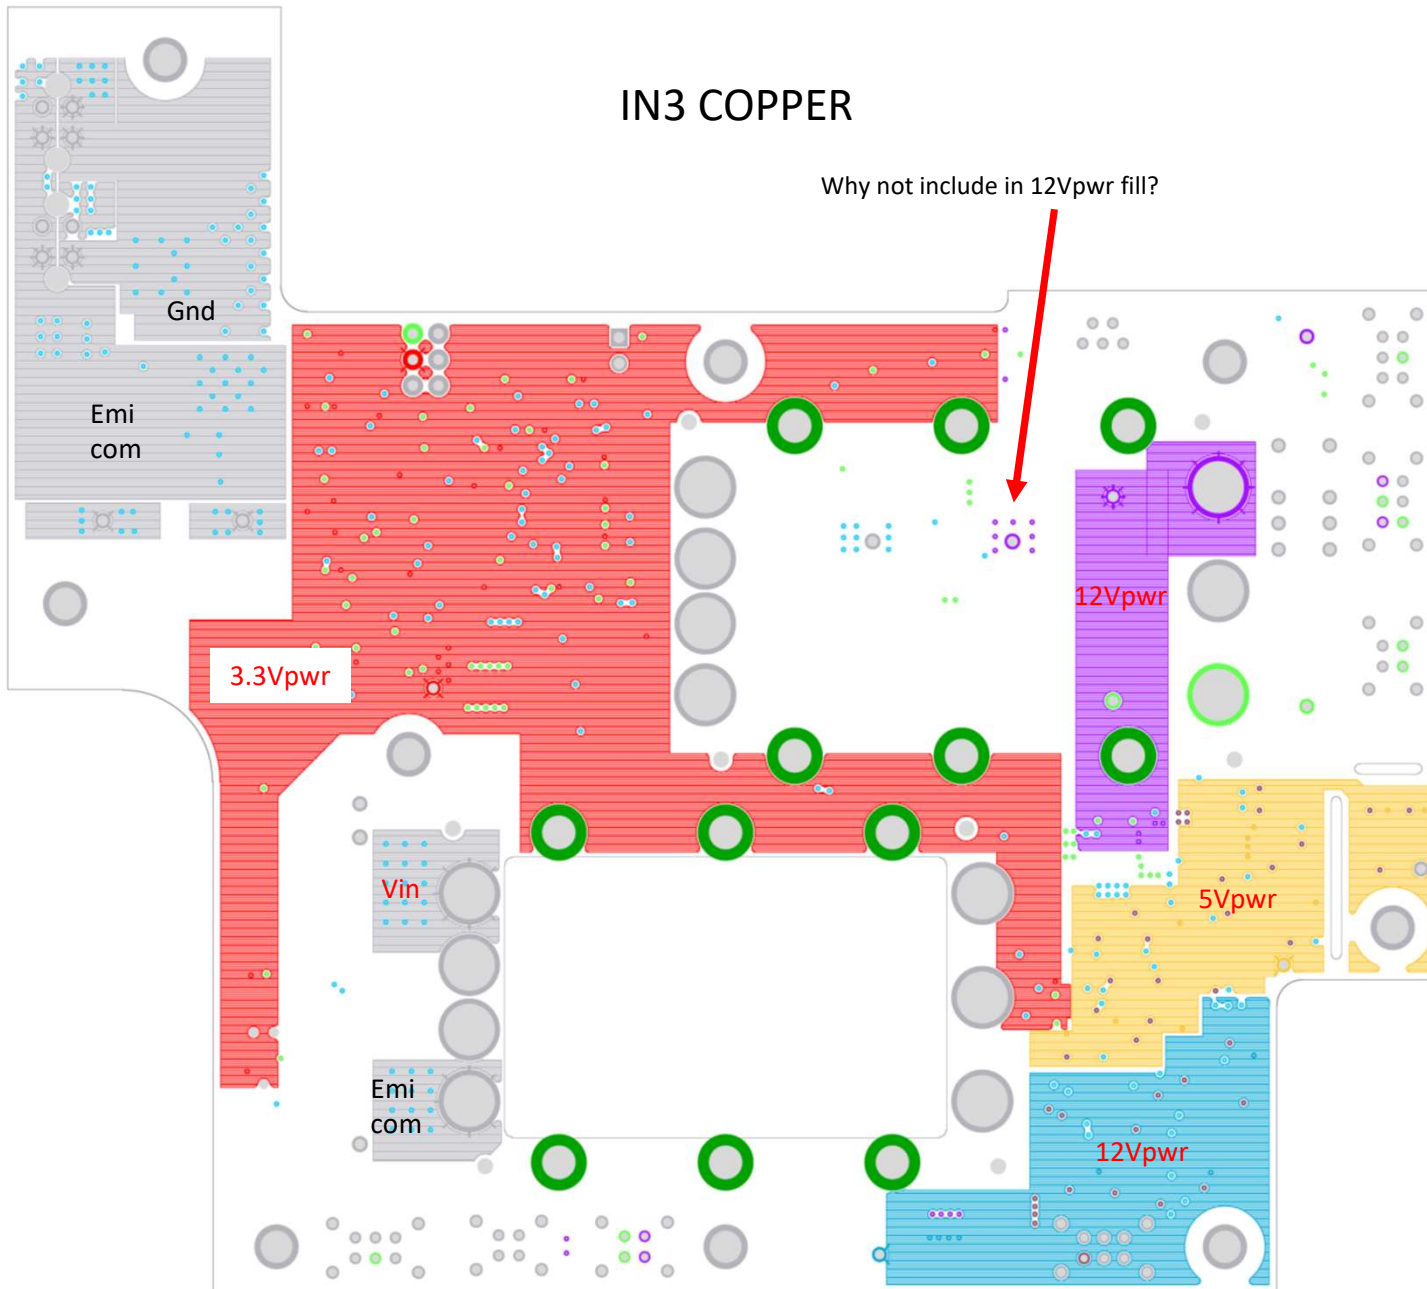

IN2 COPPER

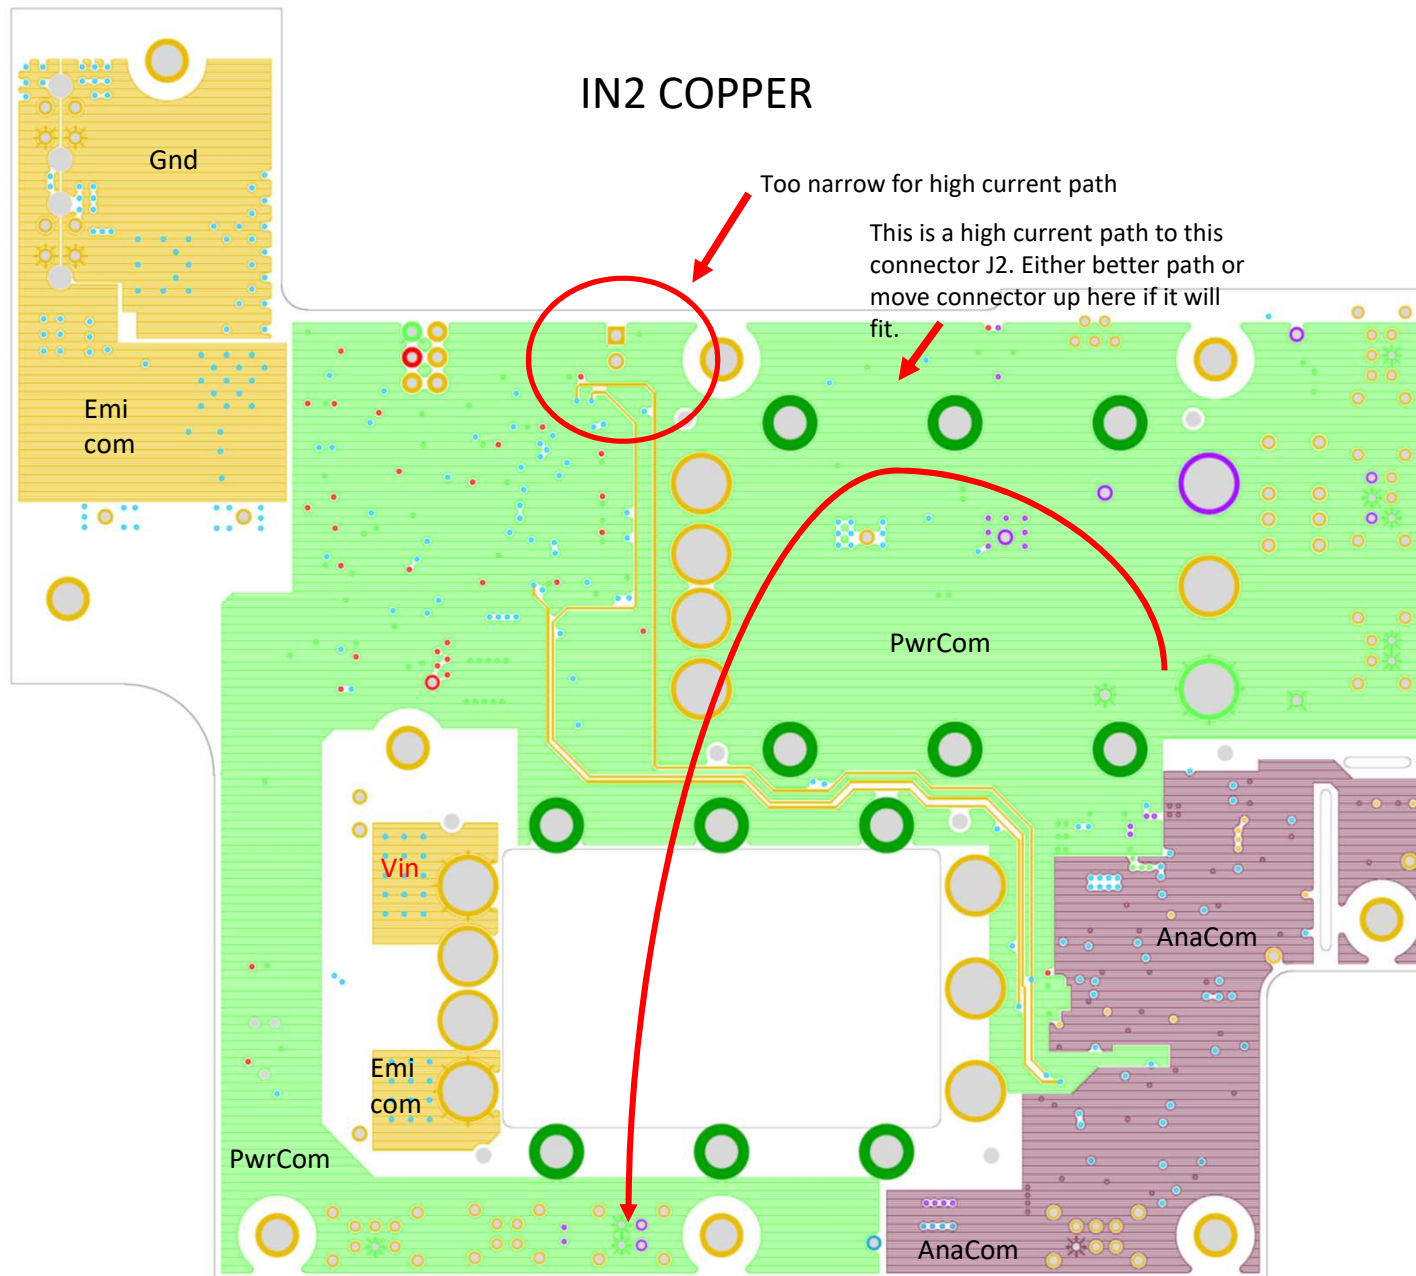


IN1 COPPER

Too narrow for high current path


This is a high current path to this connector J2. Either better path or move connector up here if it will fit.

More fill?

More fill?

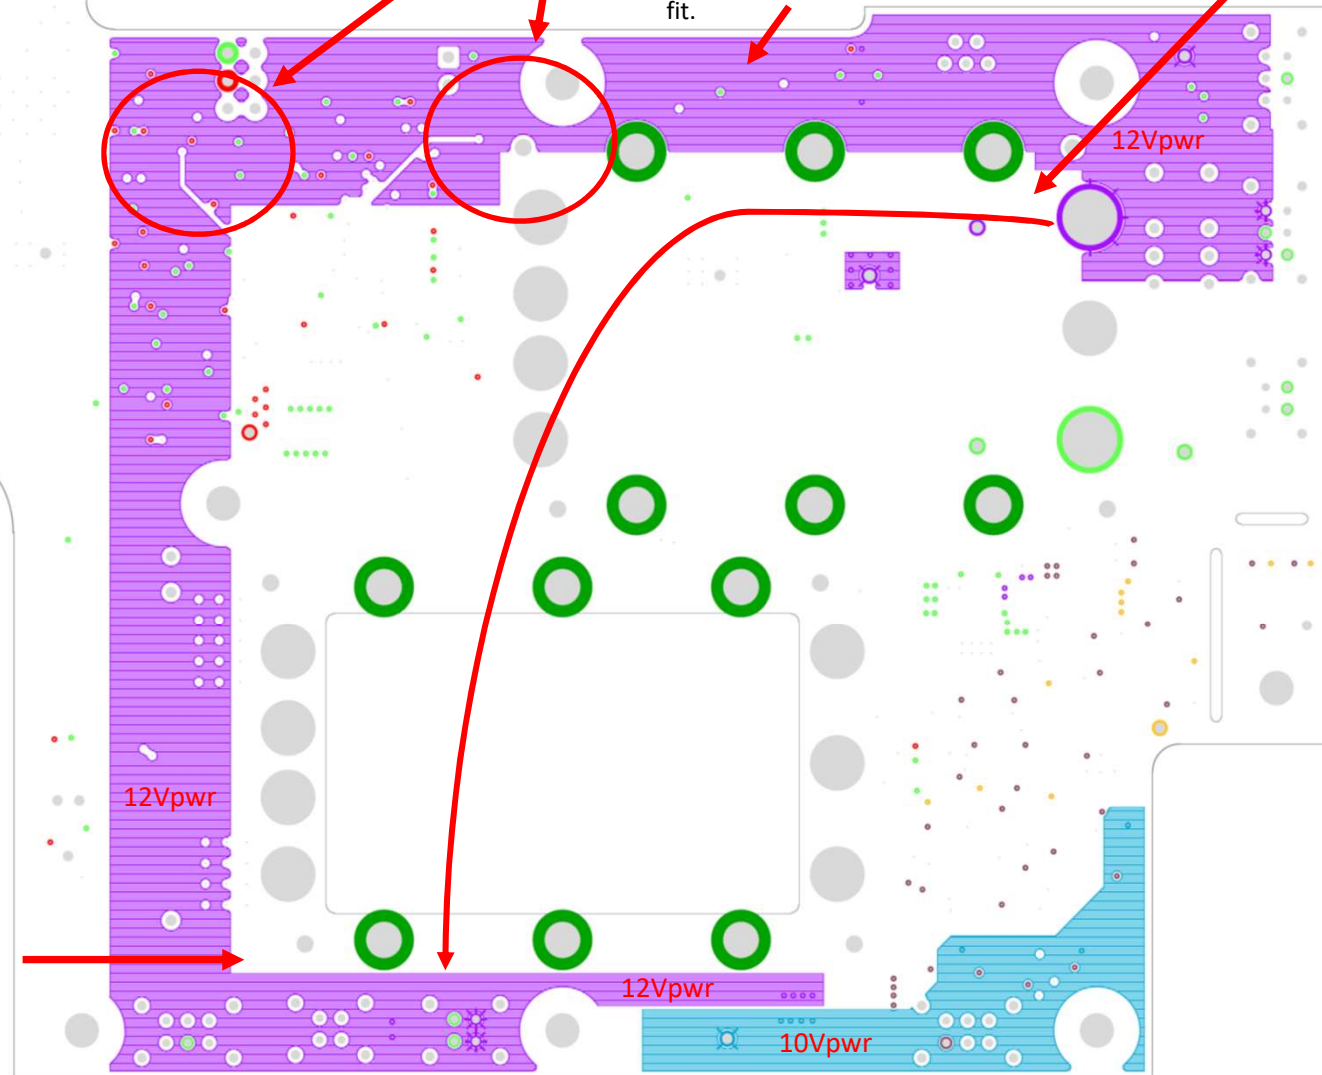

BOTTOM PLACEMENT

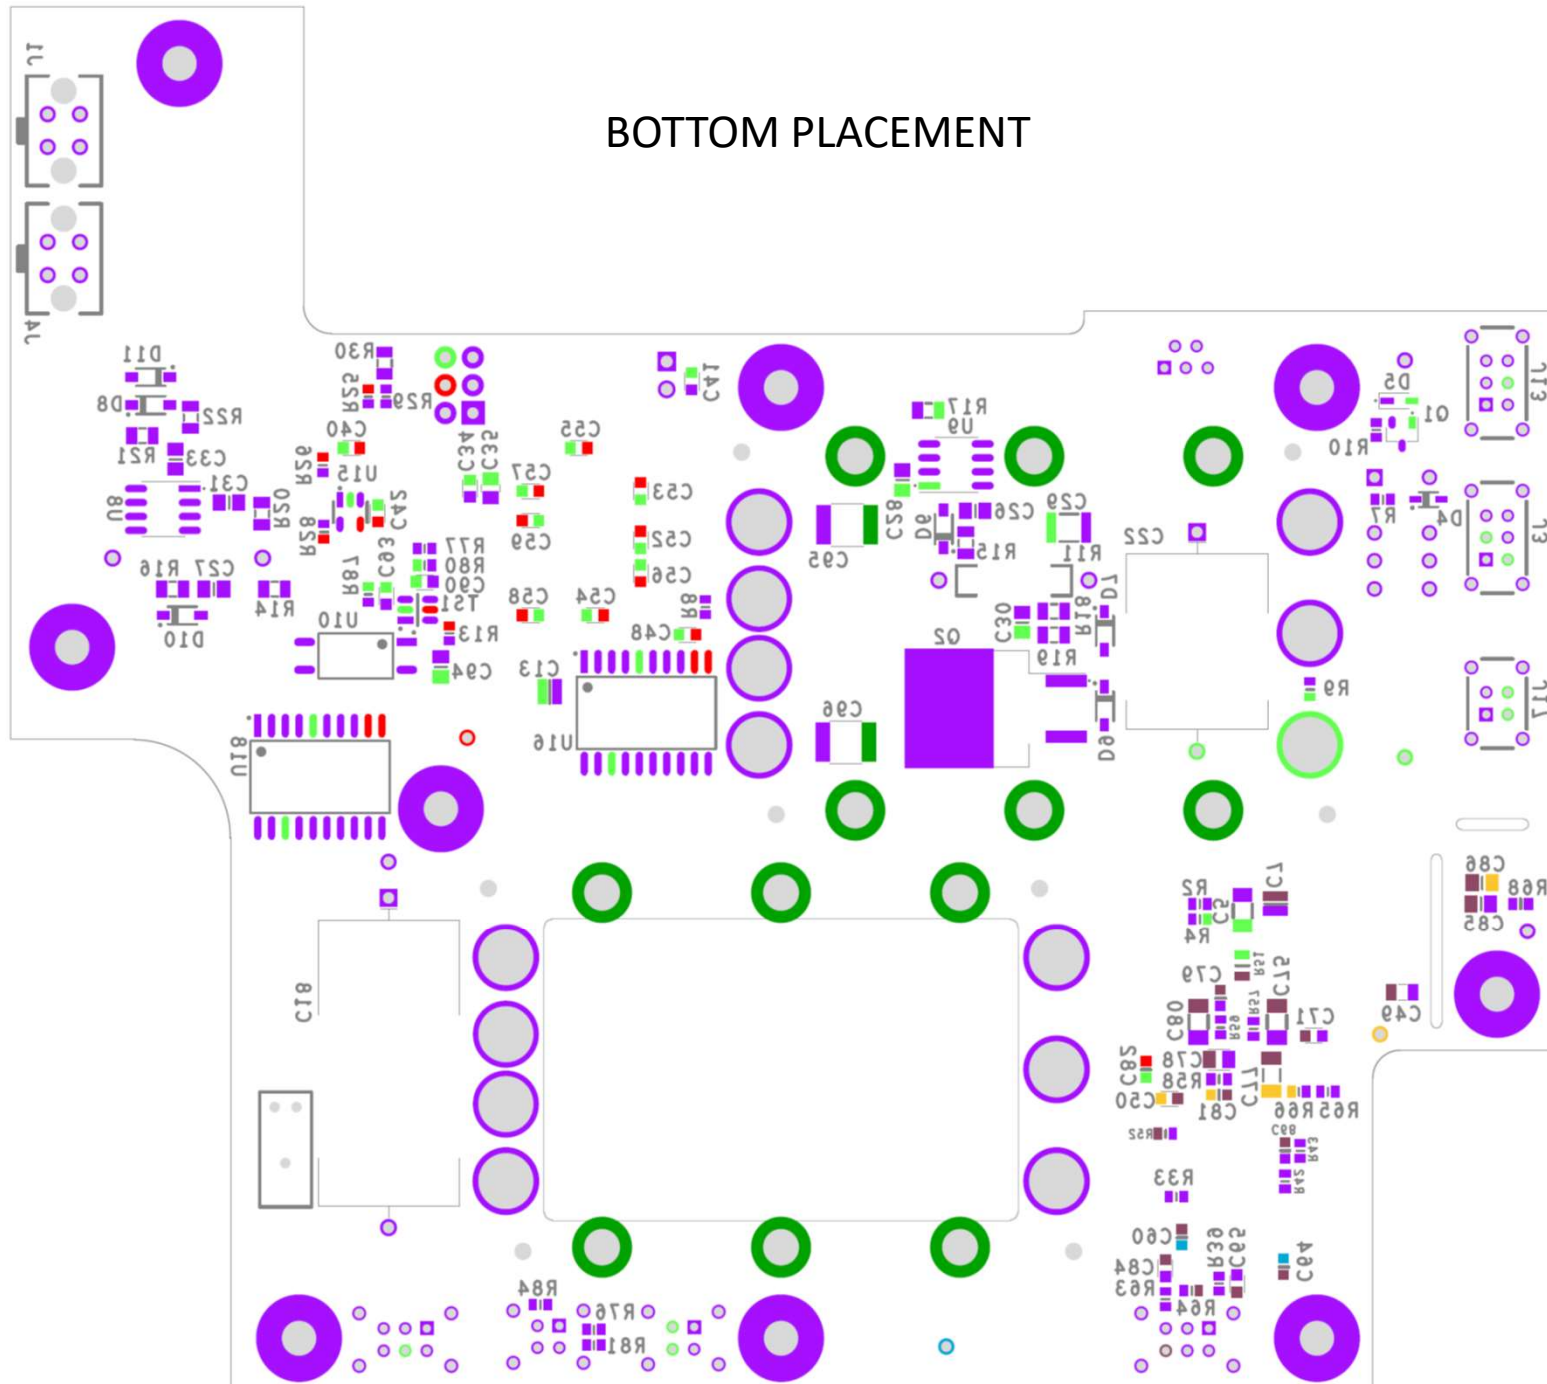

BOTTOM COPPER

