


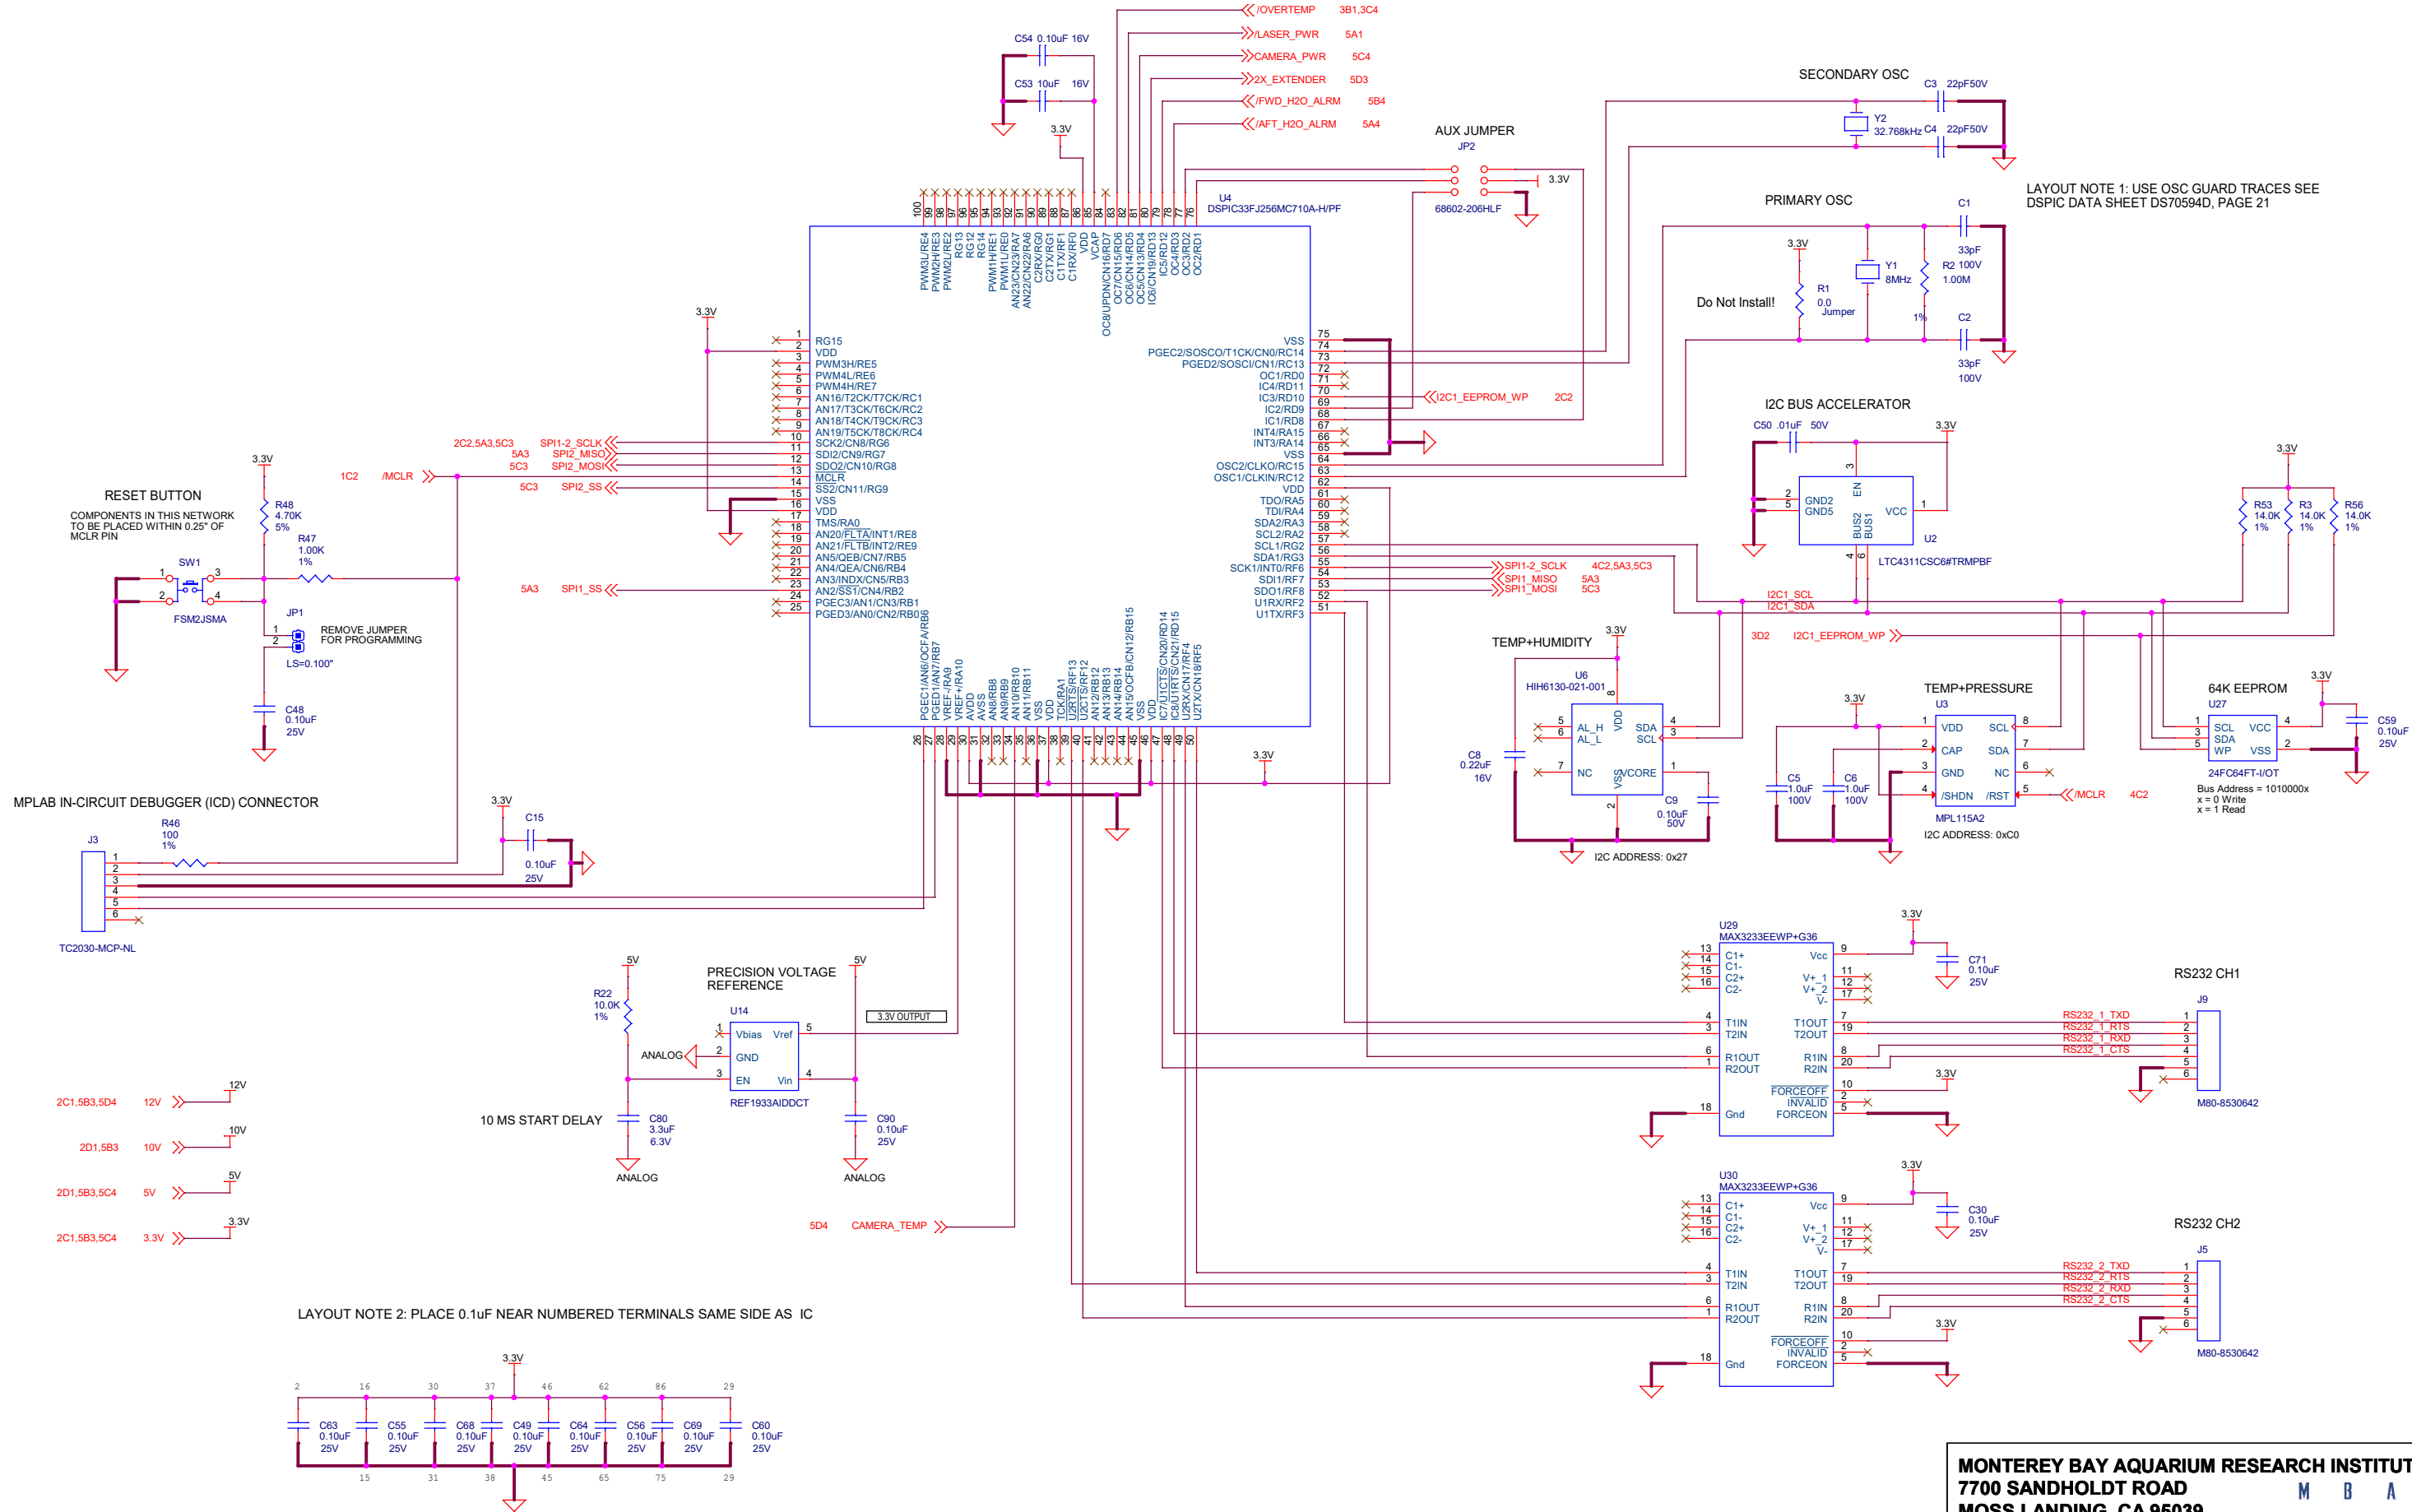

MICROPROCESSOR

MONTEREY BAY AQUARIUM RESEARCH INSTITUTE

7700 SANDHOLDT ROAD

MOSS LANDING, CA 95039

PHONE (831) 775-1700 www.mbari.org

COPYRIGHT © 2020 MBARI



MAY NOT BE COPIED WITHOUT PERMISSION



Title

4K ROV CAMERA CONTROLLER

Size	Engineer: Mark Chaffey EMAIL: chma@mbari.org	Number	100221507-03-A-SCH	Rev	A
Date:	Tuesday, July 27, 2021	Filename	NA	Sheet	2 of 4

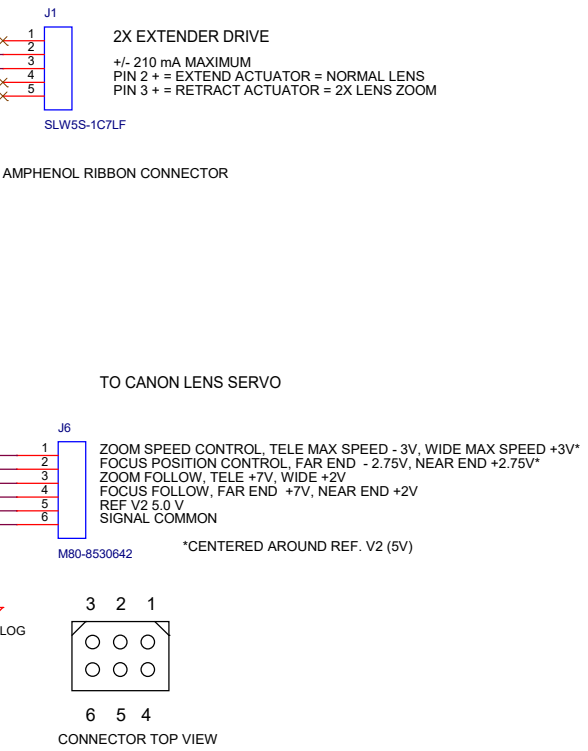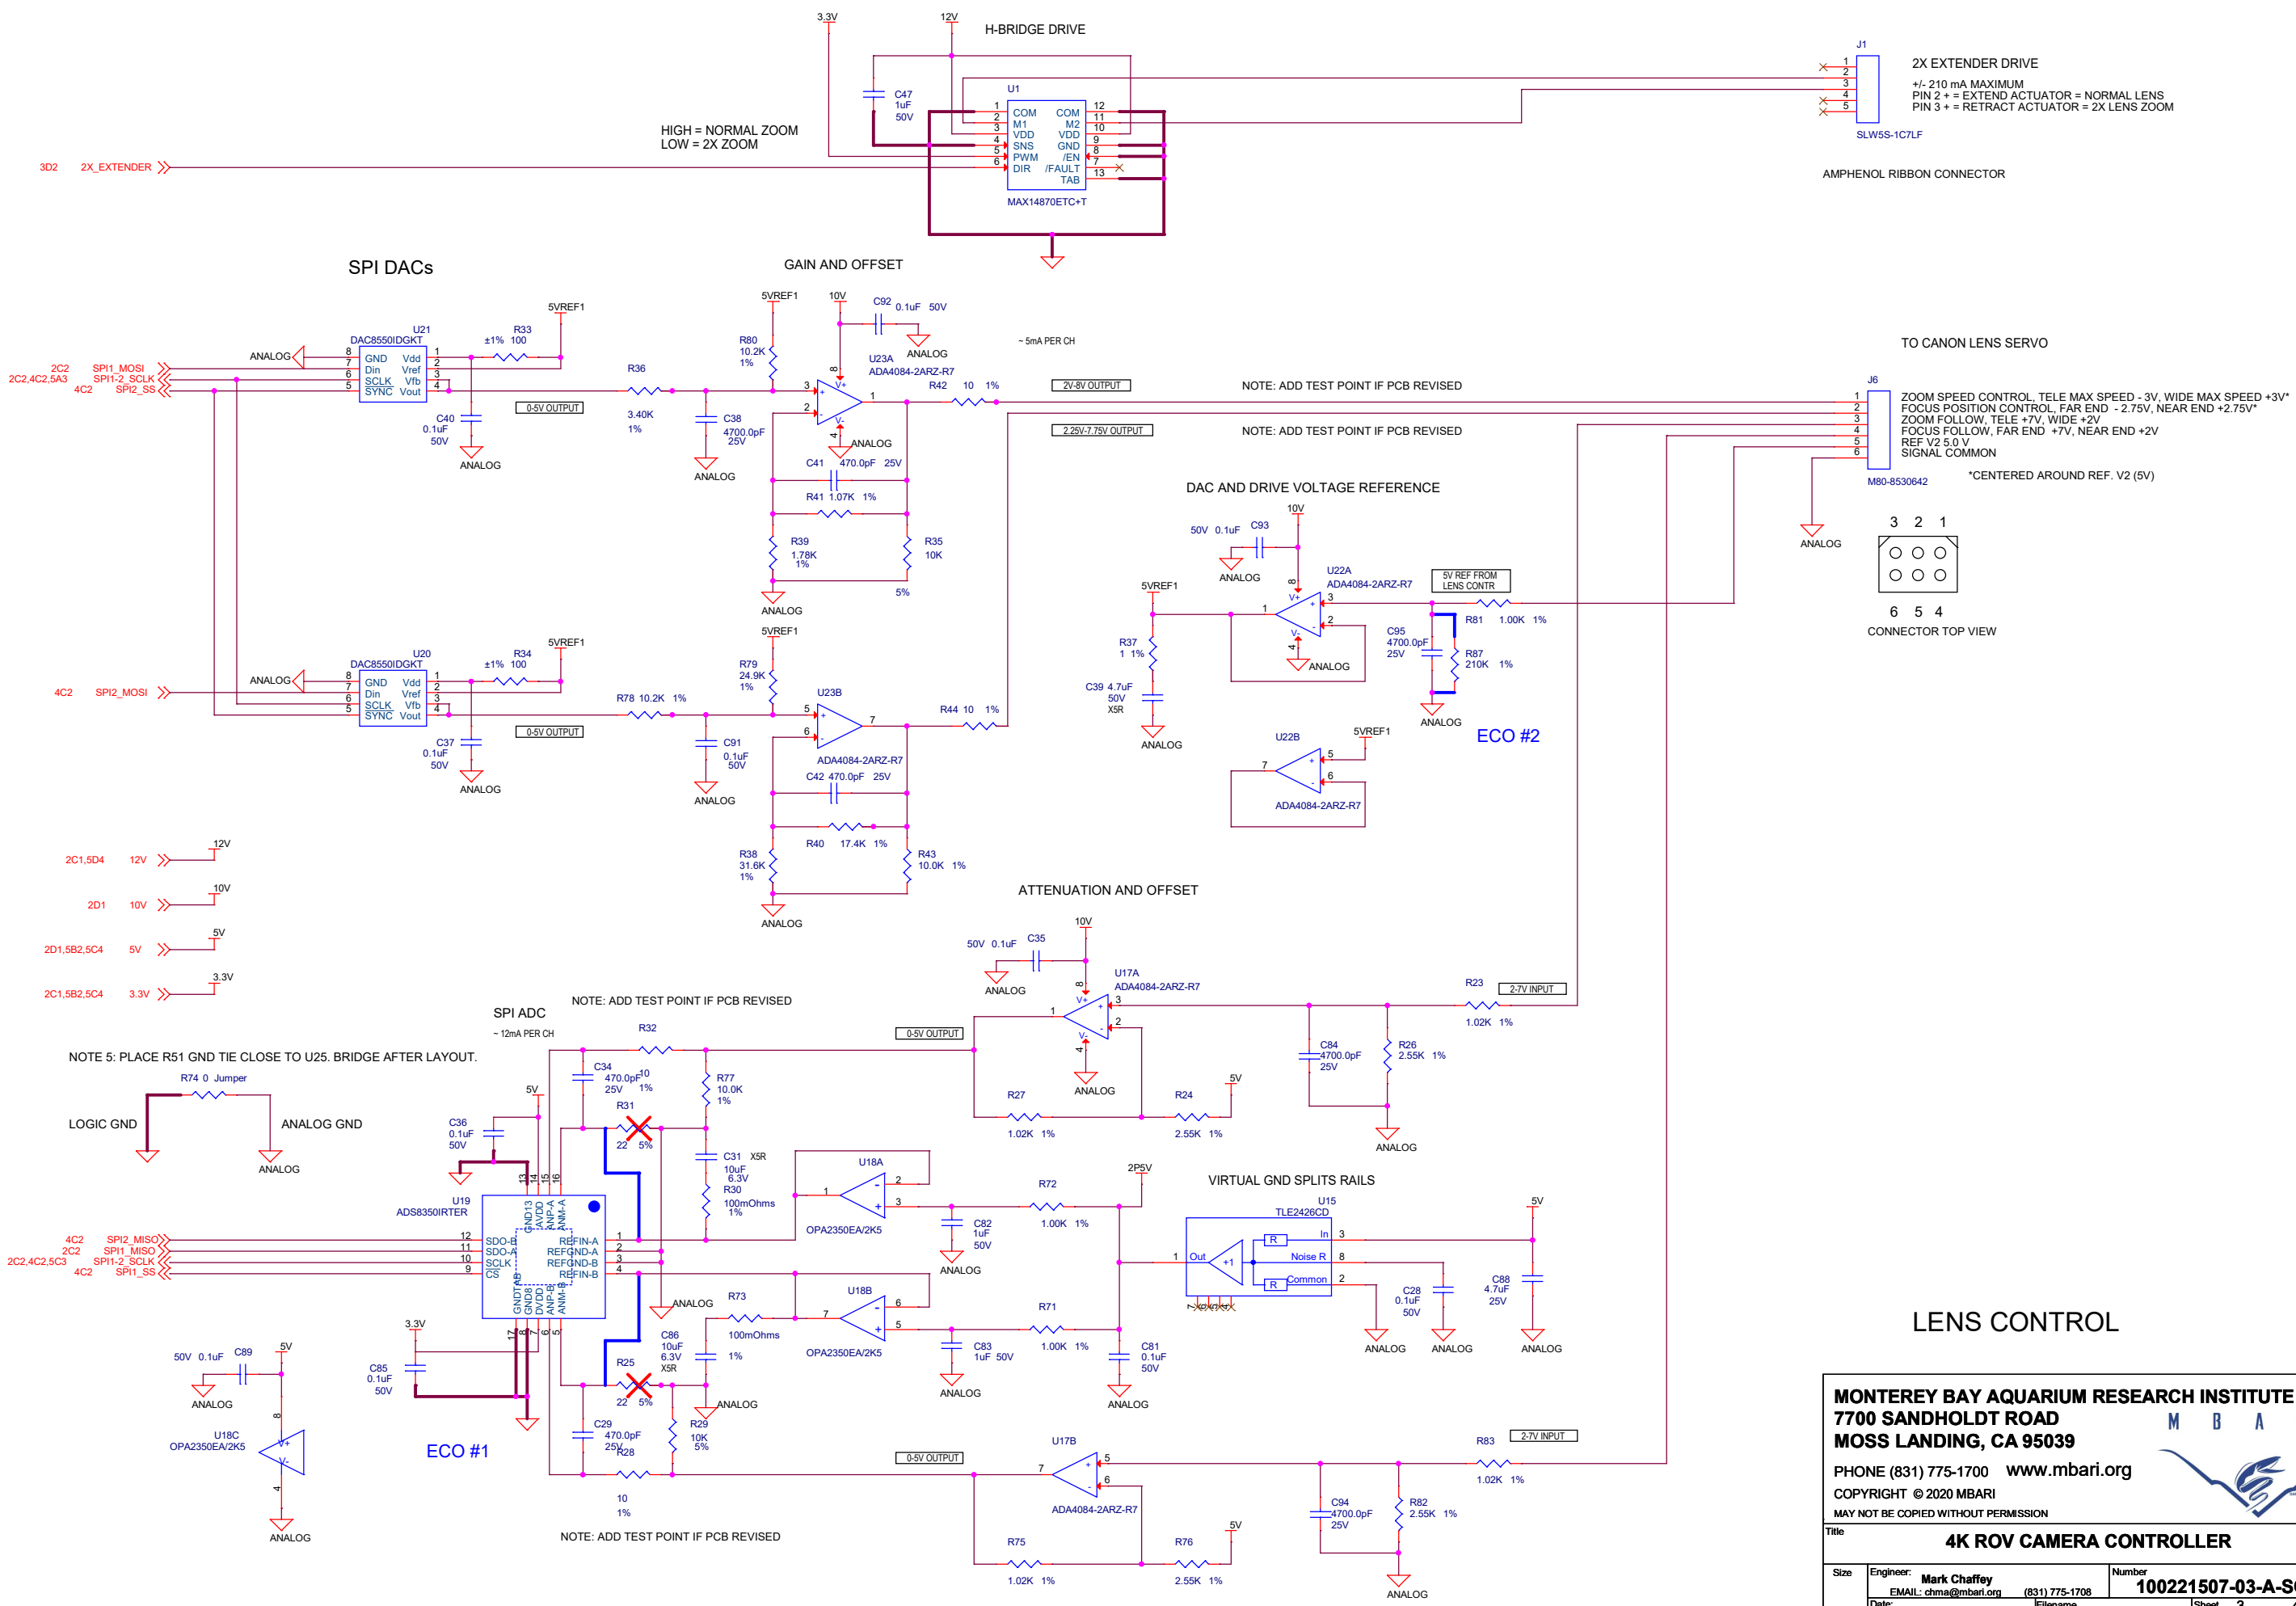

LENS CONTROL

MONTEREY BAY AQUARIUM RESEARCH INSTITUTE

7700 SANDHOLDT ROAD

MOSS LANDING, CA 95039

PHONE (831) 775-1700 www.mbari.org


COPYRIGHT © 2020 MBARI

MAY NOT BE COPIED WITHOUT PERMISSION

Title

4K ROV CAMERA CONTROLLER

Size	Engineer: Mark Chaffey EMAIL: chma@mbari.org	Number	100221507-03-A-SCH	Rev	A
Date:	Tuesday, December 07, 2021	Filename	NA	Sheet	3 of 4

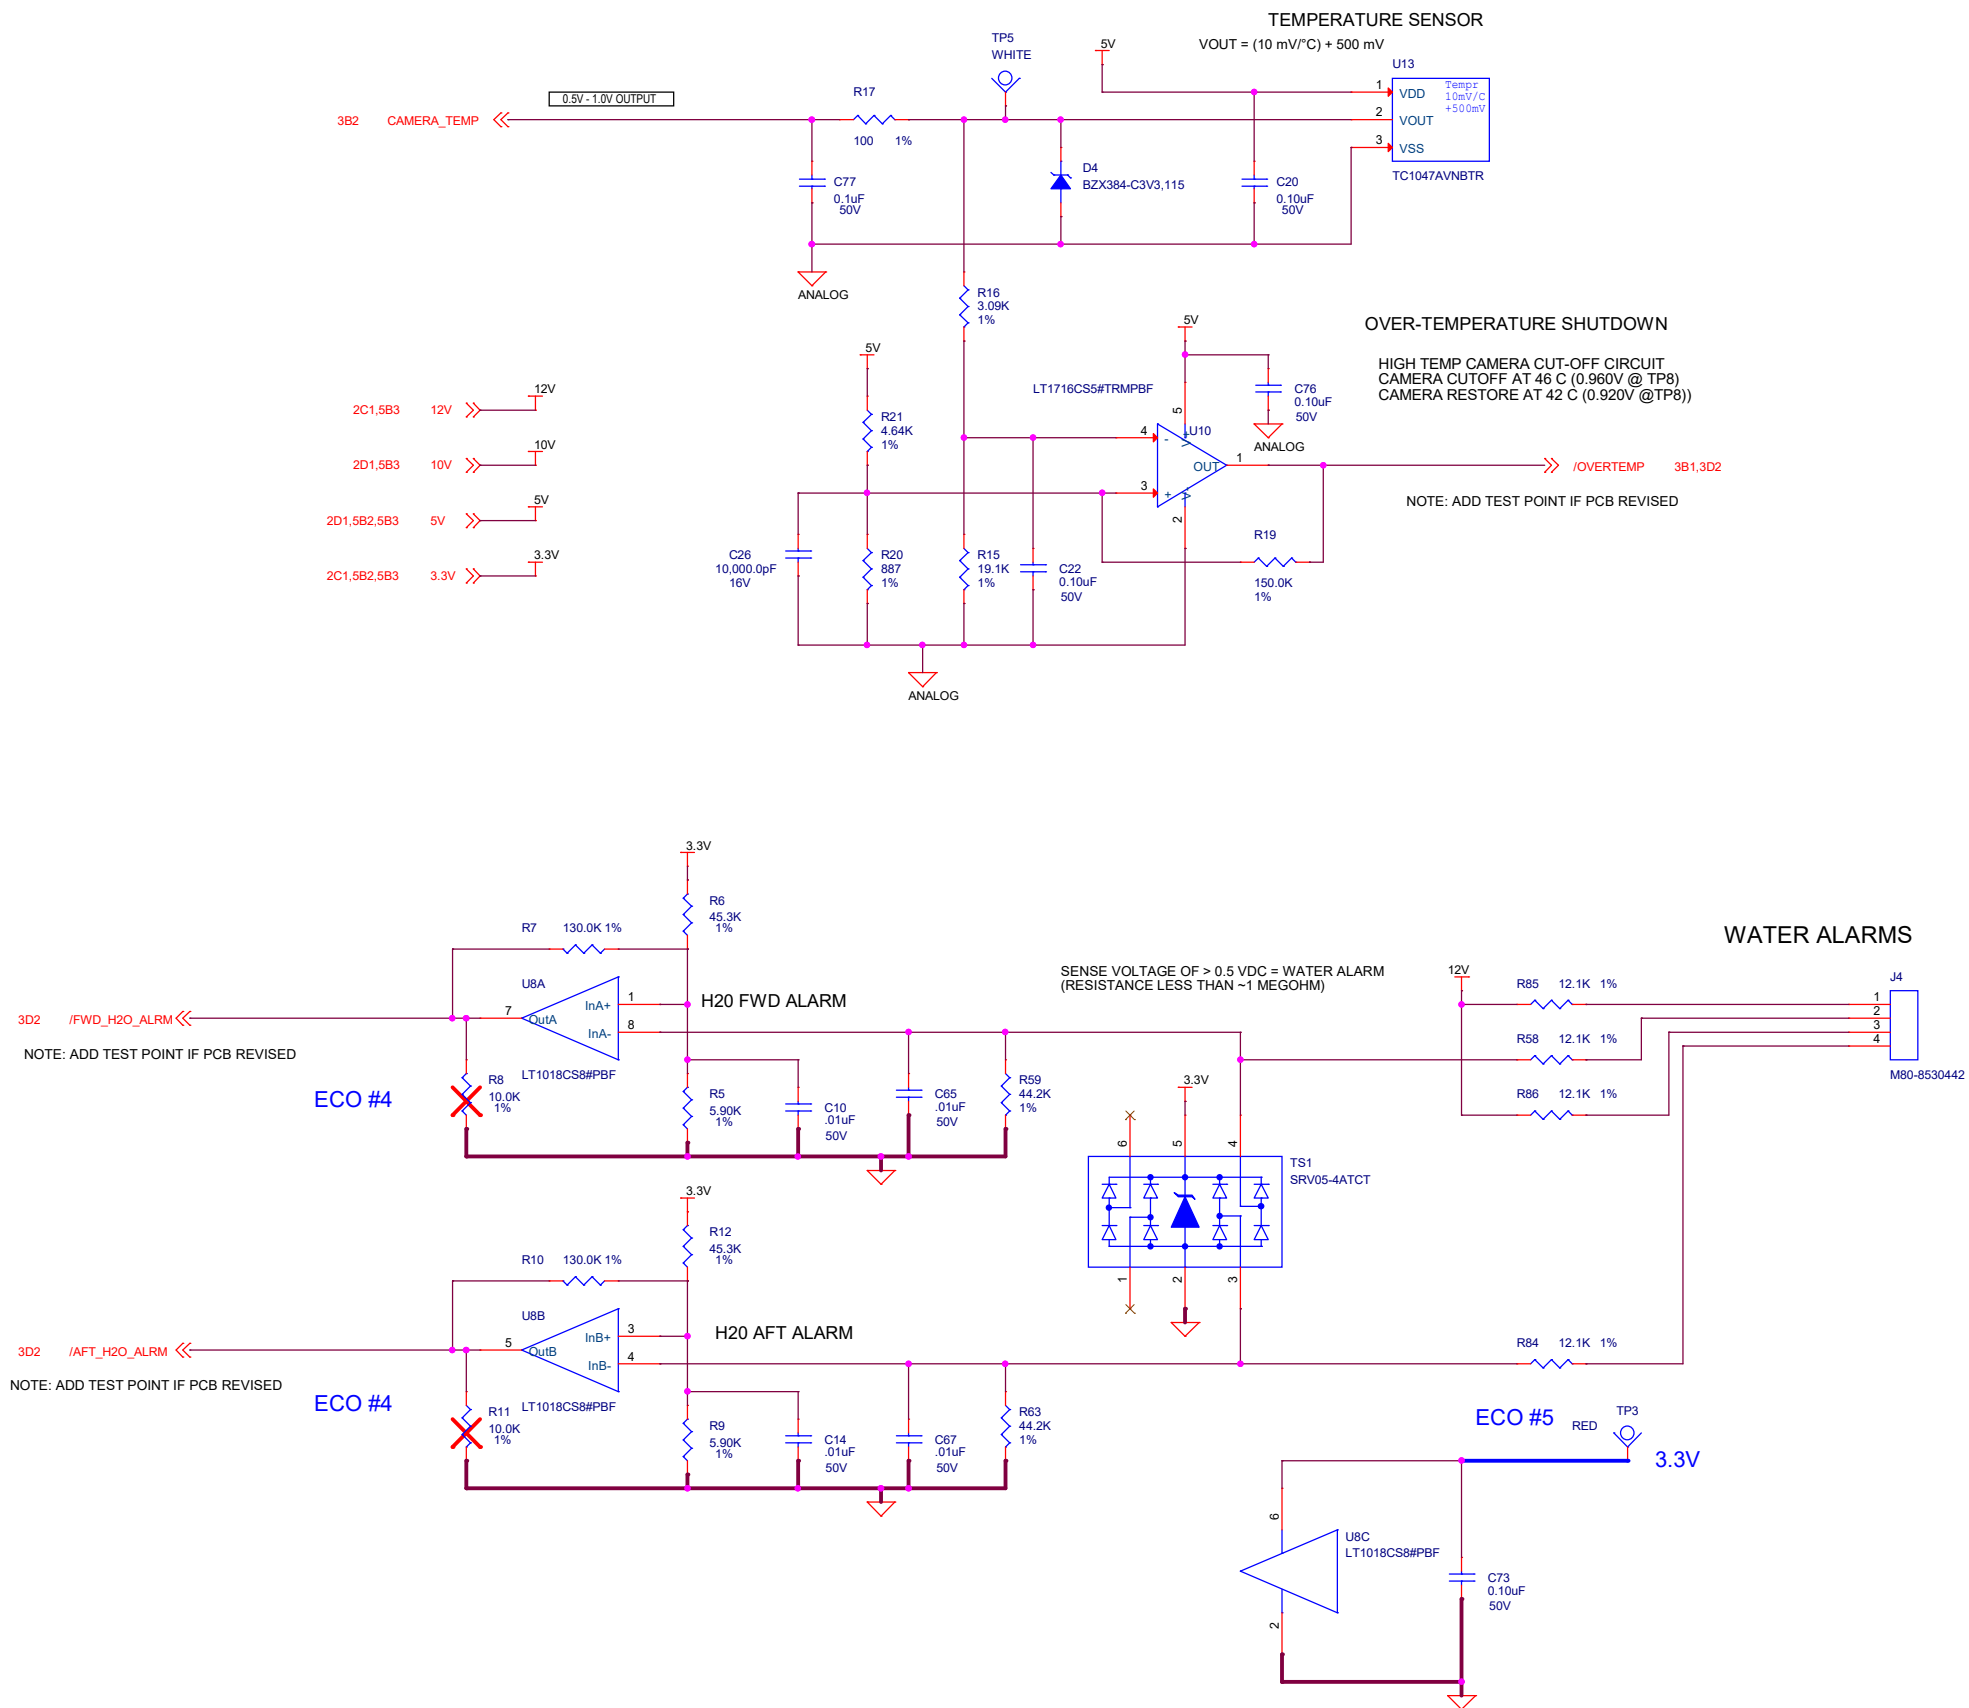

ENVIRONMENTAL SENSORS

MONTEREY BAY AQUARIUM RESEARCH INSTITUTE
7700 SANDHOLDT ROAD
MOSS LANDING, CA 95039

PHONE (831) 775-1700 www.mbari.org

COPYRIGHT © 2020 MBARI

MAY NOT BE COPIED WITHOUT PERMISSION



Title
4K ROV CAMERA CONTROLLER

Size	Engineer: Mark Chaffey EMAIL: chma@mbari.org Date: Tuesday, December 07, 2021	Number (831) 775-1708 Filename: NA	Rev A
		100221507-03-A-SCH	
		Sheet 4 of 4	