


THE INFORMATION CONTAINED IN THIS DRAWING IS THE SOLE PROPERTY OF MBARI ANY REPRODUCTION IN PART OR WHOLE WITHOUT THE WRITTEN PERMISSION OF MBARI IS PROHIBITED.

REVISIONS			
REV.	DESCRIPTION	DATE	APPROVED
B	Reduced thickness for new prescription	08/02/2022	
C	XX	XX/XX/202X	

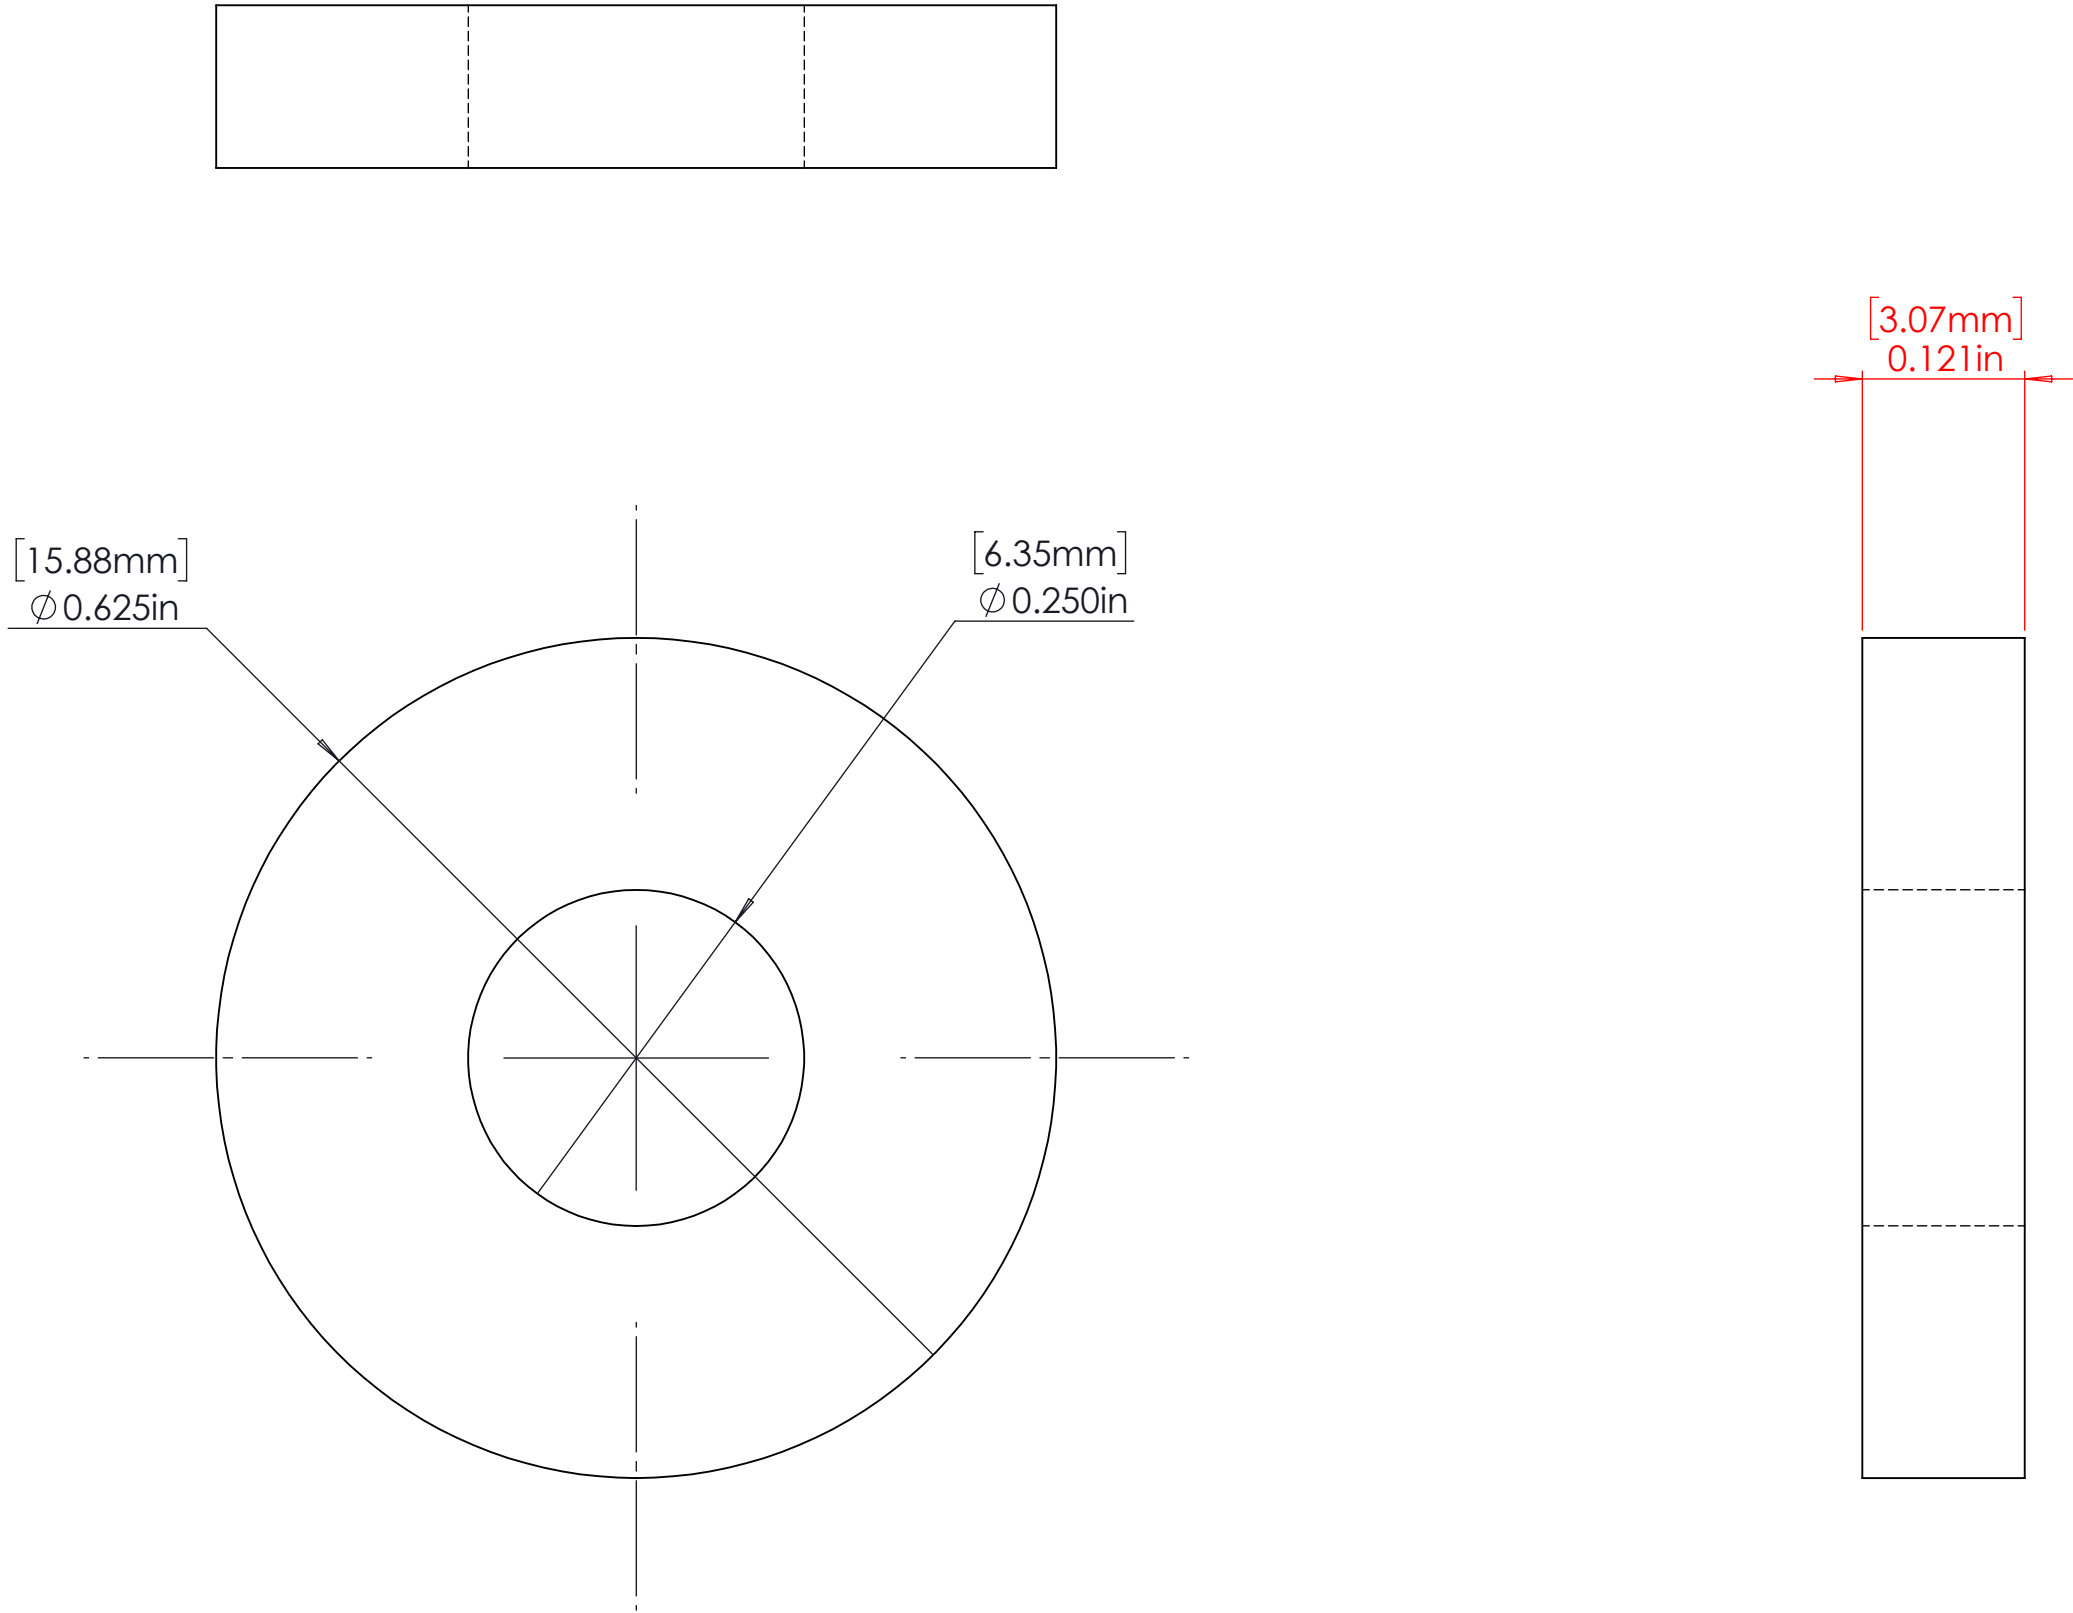

NOTE 1. SOLID MODEL LOCATION:
\\atlas\ProjectLibrary\902001_4K_ROVCameraDevelopment\EngineeringDesignDocuments\MechanicalDesign\4K_CameraChassis\100221414-100-A_0.180_ChassisSpacer.SLDPRT

NOTE 2. MATERIAL: 1045 CARBON STEEL

(c) MBARI 2021 MBARI provides the documentation and materials "as is", with no warranty, express or implied, as to title, non-infringement of third party rights, merchantability, or fitness for any particular purpose, or the performance or results which you may obtain from their use. You assume the entire risk associated with use.

Shop / Q.C.		BILL OF MATERIALS UNLESS OTHERWISE SPECIFIED TOLERANCES ARE:				APPROVALS		DATE	
Inspector		1 PLACE DIM ±1/16	2 PLACE DIM ±.001	3 PLACE DIM ±.000	ANGLE ±1°	DRAWN MRC		01/05/2021	
Shop Foreman		1. DIMENSIONS ARE IN INCHES. 2. DIMENSION LIMITS HELD AFTER PLATING. 3. REMOVE BURRS AND SHARP EDGES .015 MAX. 4. MACHINED FILET RADI .015-.020. 5. MACHINED DIAMETERS ON A COMMON CENTERLINE CONCENTRIC WITHIN .005 6. PERPENDICULARITY & PARALLELISM OF MACHINED SURFACES .002 PER INCH. MAX .012 INCHES FOR SINGLE SURFACE.				ENGINEER			
Engineer						MARK R. CHAFFEY			
NEXT ASSY Description	NEXT ASSY Number					(831) 775-1708 chmra@mbari.org			
APPLICATION		DO NOT SCALE DRAWING		WEIGHT		PROJECT No.	902001	4K CAMERA 0.121 CHASSIS SPACER	
						PROJECT Name	4K ROV CAMERA	SIZE C	DWG. NO. 100221414-100-B-DWG
						SCALE	CAD FILE:	REV. B	
						SHEET 1 OF 1			



MBARI
7700 Sandholdt Rd.
Moss Landing, CA 95039
PH: (831) 775-1700