
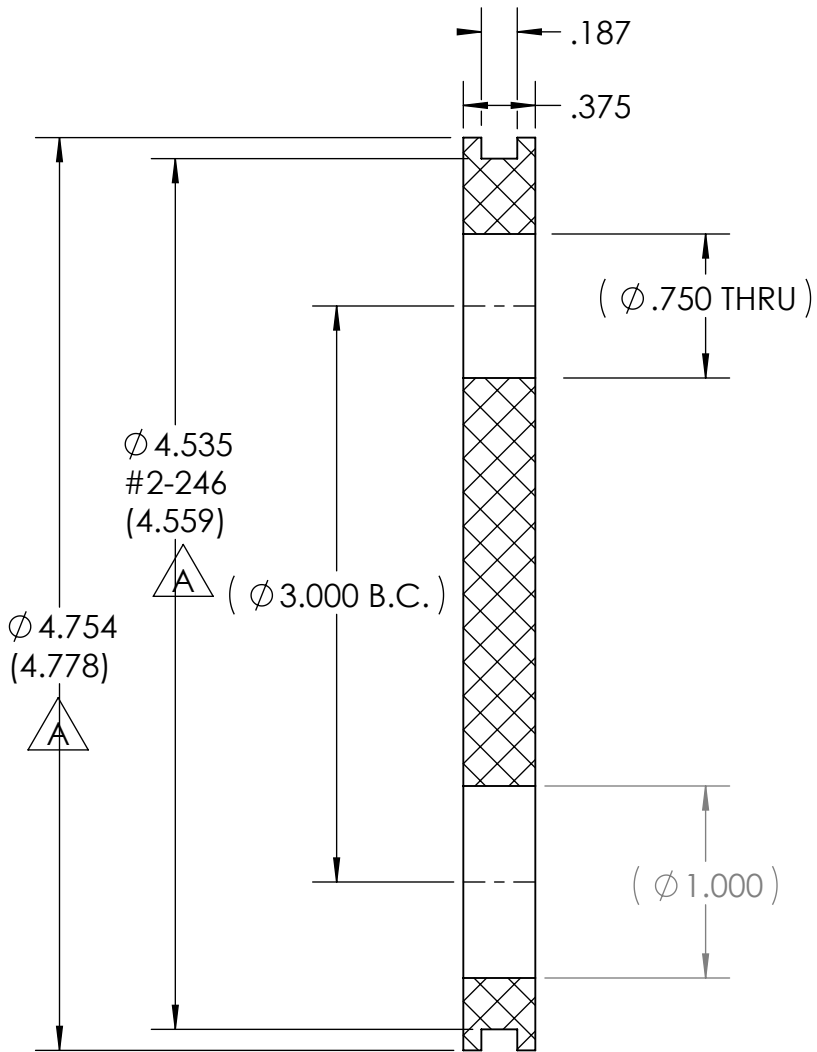
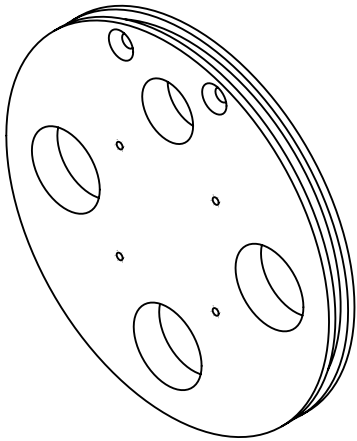


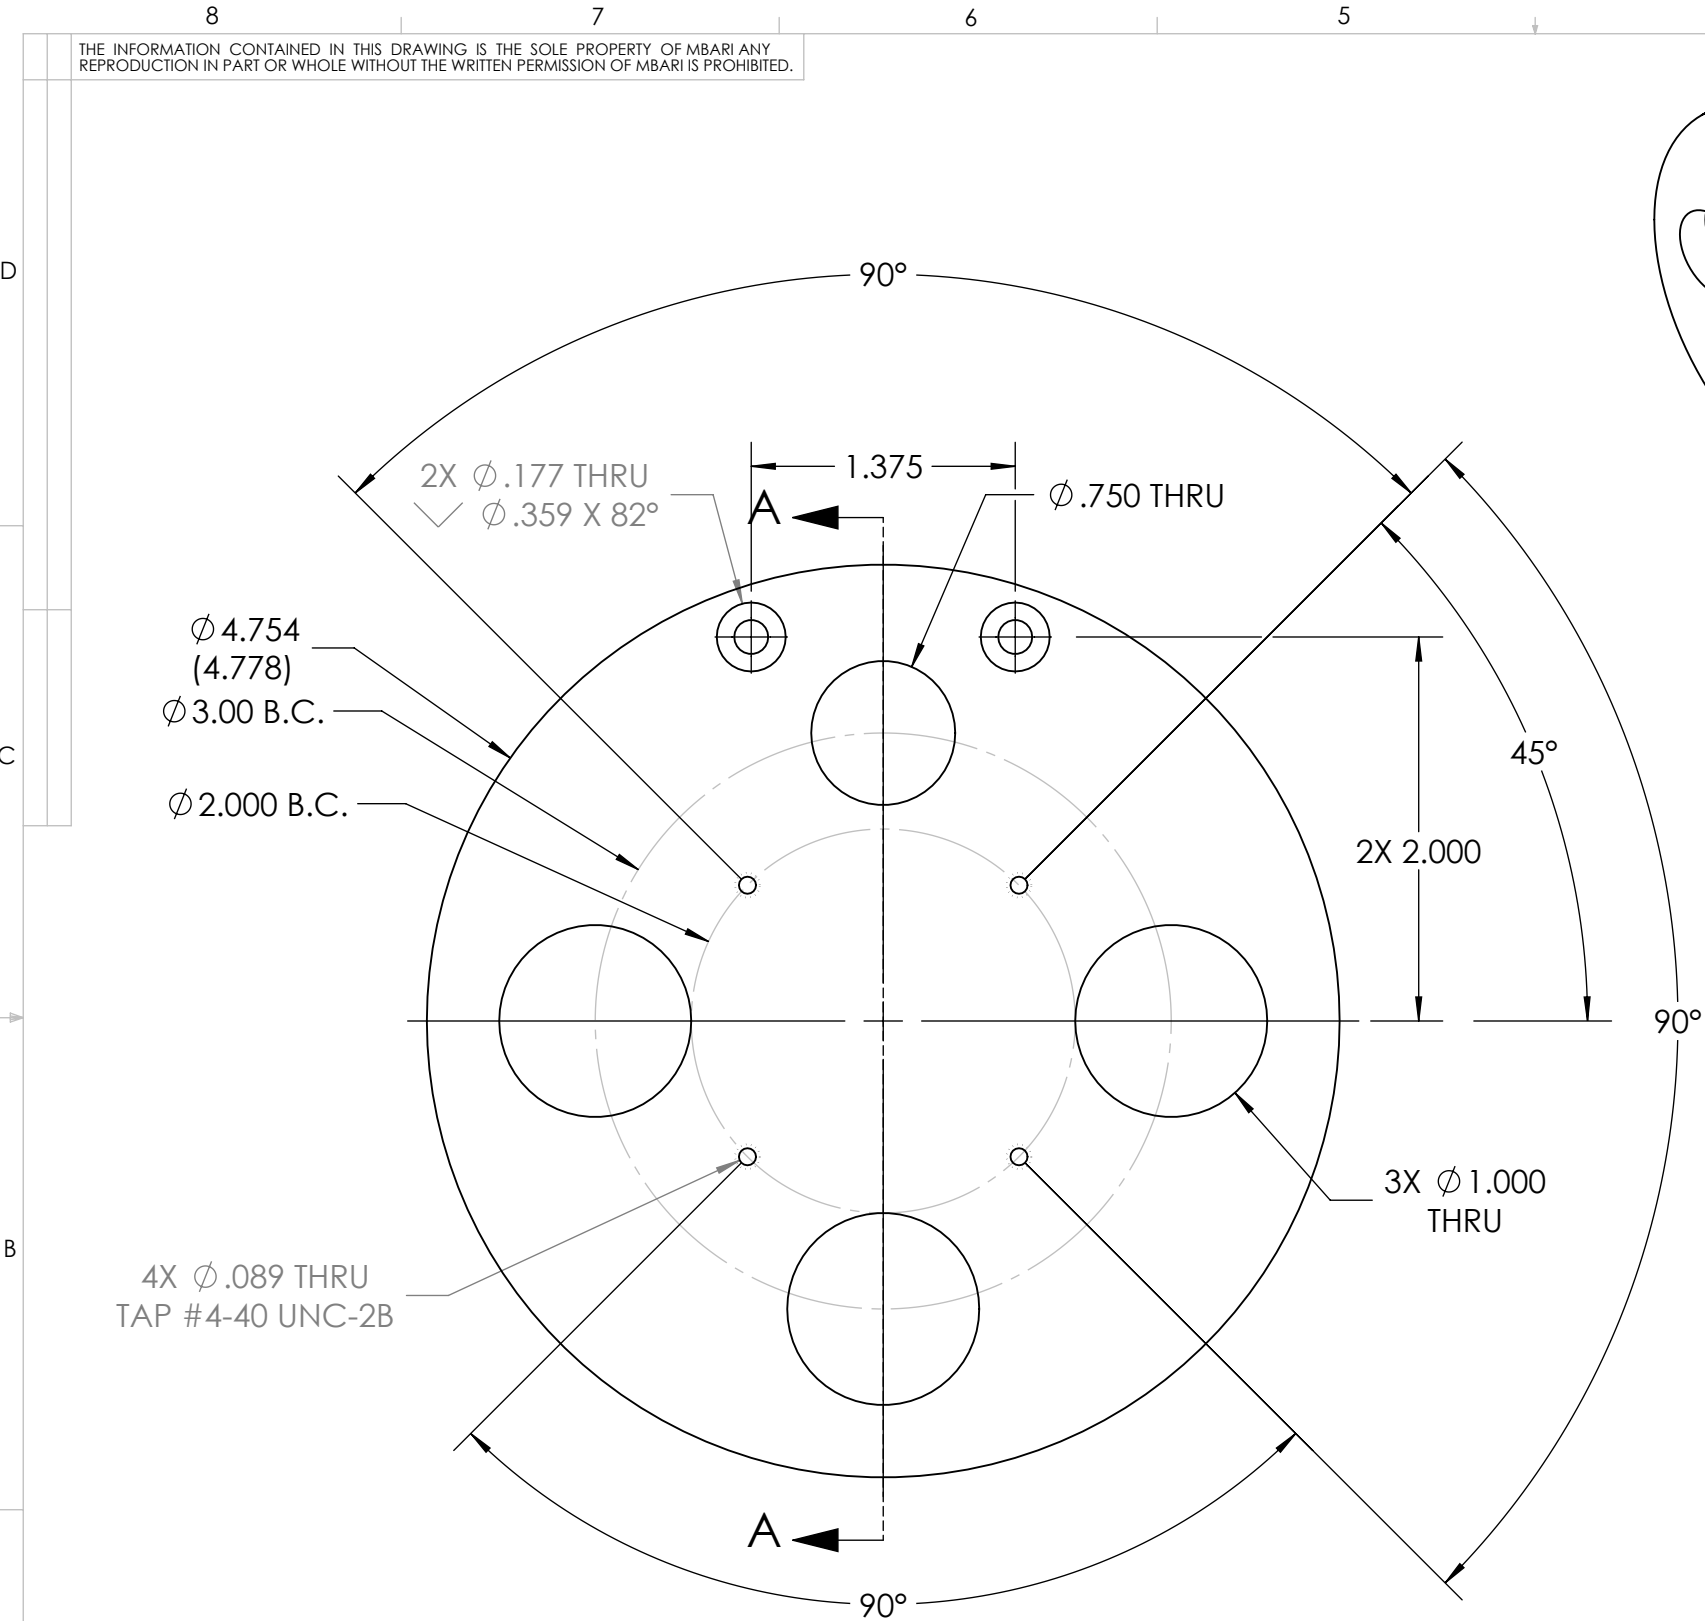

SECTION A-A

1	1	P-221666-21	Chassis Rear Bumper	MBARI	ABS
ITEM NO.	QTY.	Part_Number	DESCRIPTION	Vendor	MATERIAL
BILL OF MATERIALS					
Shop / Q.C.		UNLESS OTHERWISE SPECIFIED TOLERANCES ARE:		APPROVALS DATE	
Inspector		1 PLACE DIM ±1/16	2 PLACE DIM ±.02	3 PLACE DIM ±.005	ANGLES ±1°
Shop Foreman		1. DIMENSIONS ARE IN INCHES		DRAWN J. ERICKSON 12/22/21	
Engineer		2. DIMENSION LIMITS HELD AFTER PLATING.		ENGINEER J. ERICKSON 12/22/21	
		3. REMOVE BURRS AND SHARP EDGES .015 MAX.		CHECKED	
		4. MACHINED FILLET RADII .0150-.030.		PROJECT NO. 902004	
NEXT ASSY Description	NEXT ASSY Number	5. MACHINED DIAMETERS ON A COMMON CENTERLINE CONCENTRIC WITHIN .005		PROJECT PLANKTIVORE	
		6. PERPENDICULARITY & PARALLELISM OF MACHINED SURFACES .002 PER INCH. MAX .012 INCHES FOR SINGLE SURFACE.		WEIGHT 0.194	
Application		DO NOT SCALE DRAWING		SIZE B DWG. NO. P-221666-21.DWG	
				SCALE 1:1 CAD FILE: MECH ENG ON TORNADO SHEET 1 OF 1	

THE INFORMATION CONTAINED IN THIS DRAWING IS THE SOLE PROPERTY OF MBARI ANY REPRODUCTION IN PART OR WHOLE WITHOUT THE WRITTEN PERMISSION OF MBARI IS PROHIBITED.

REVISIONS				
INITIAL RELEASE			X/XX/01	J.E.
REVISIONS				
ZONE	REV.	DESCRIPTION	DATE	APPROVED
A2, B2	A	CHG Groove Dia. frm 4.559 to 4.535 CHG O.D. frm 4.778 to 4.754	2/16/2022	J.E.

7. PROJECT LIBRARYX:\902004_Planktivore\BatteryPack_jon\P-221666-21_Bumper

NOTES: (CONT. FROM TITLE BLOCK)

Monterey Bay Aquarium Research Institute
MBARI
7700 Sandholdt RD.
Moss Landing, CA 95039
PH: (831) 775-1700

REMOTE BATT. PACK
Chassis Rear Bumper

P-221666-21.DWG

REV. A