


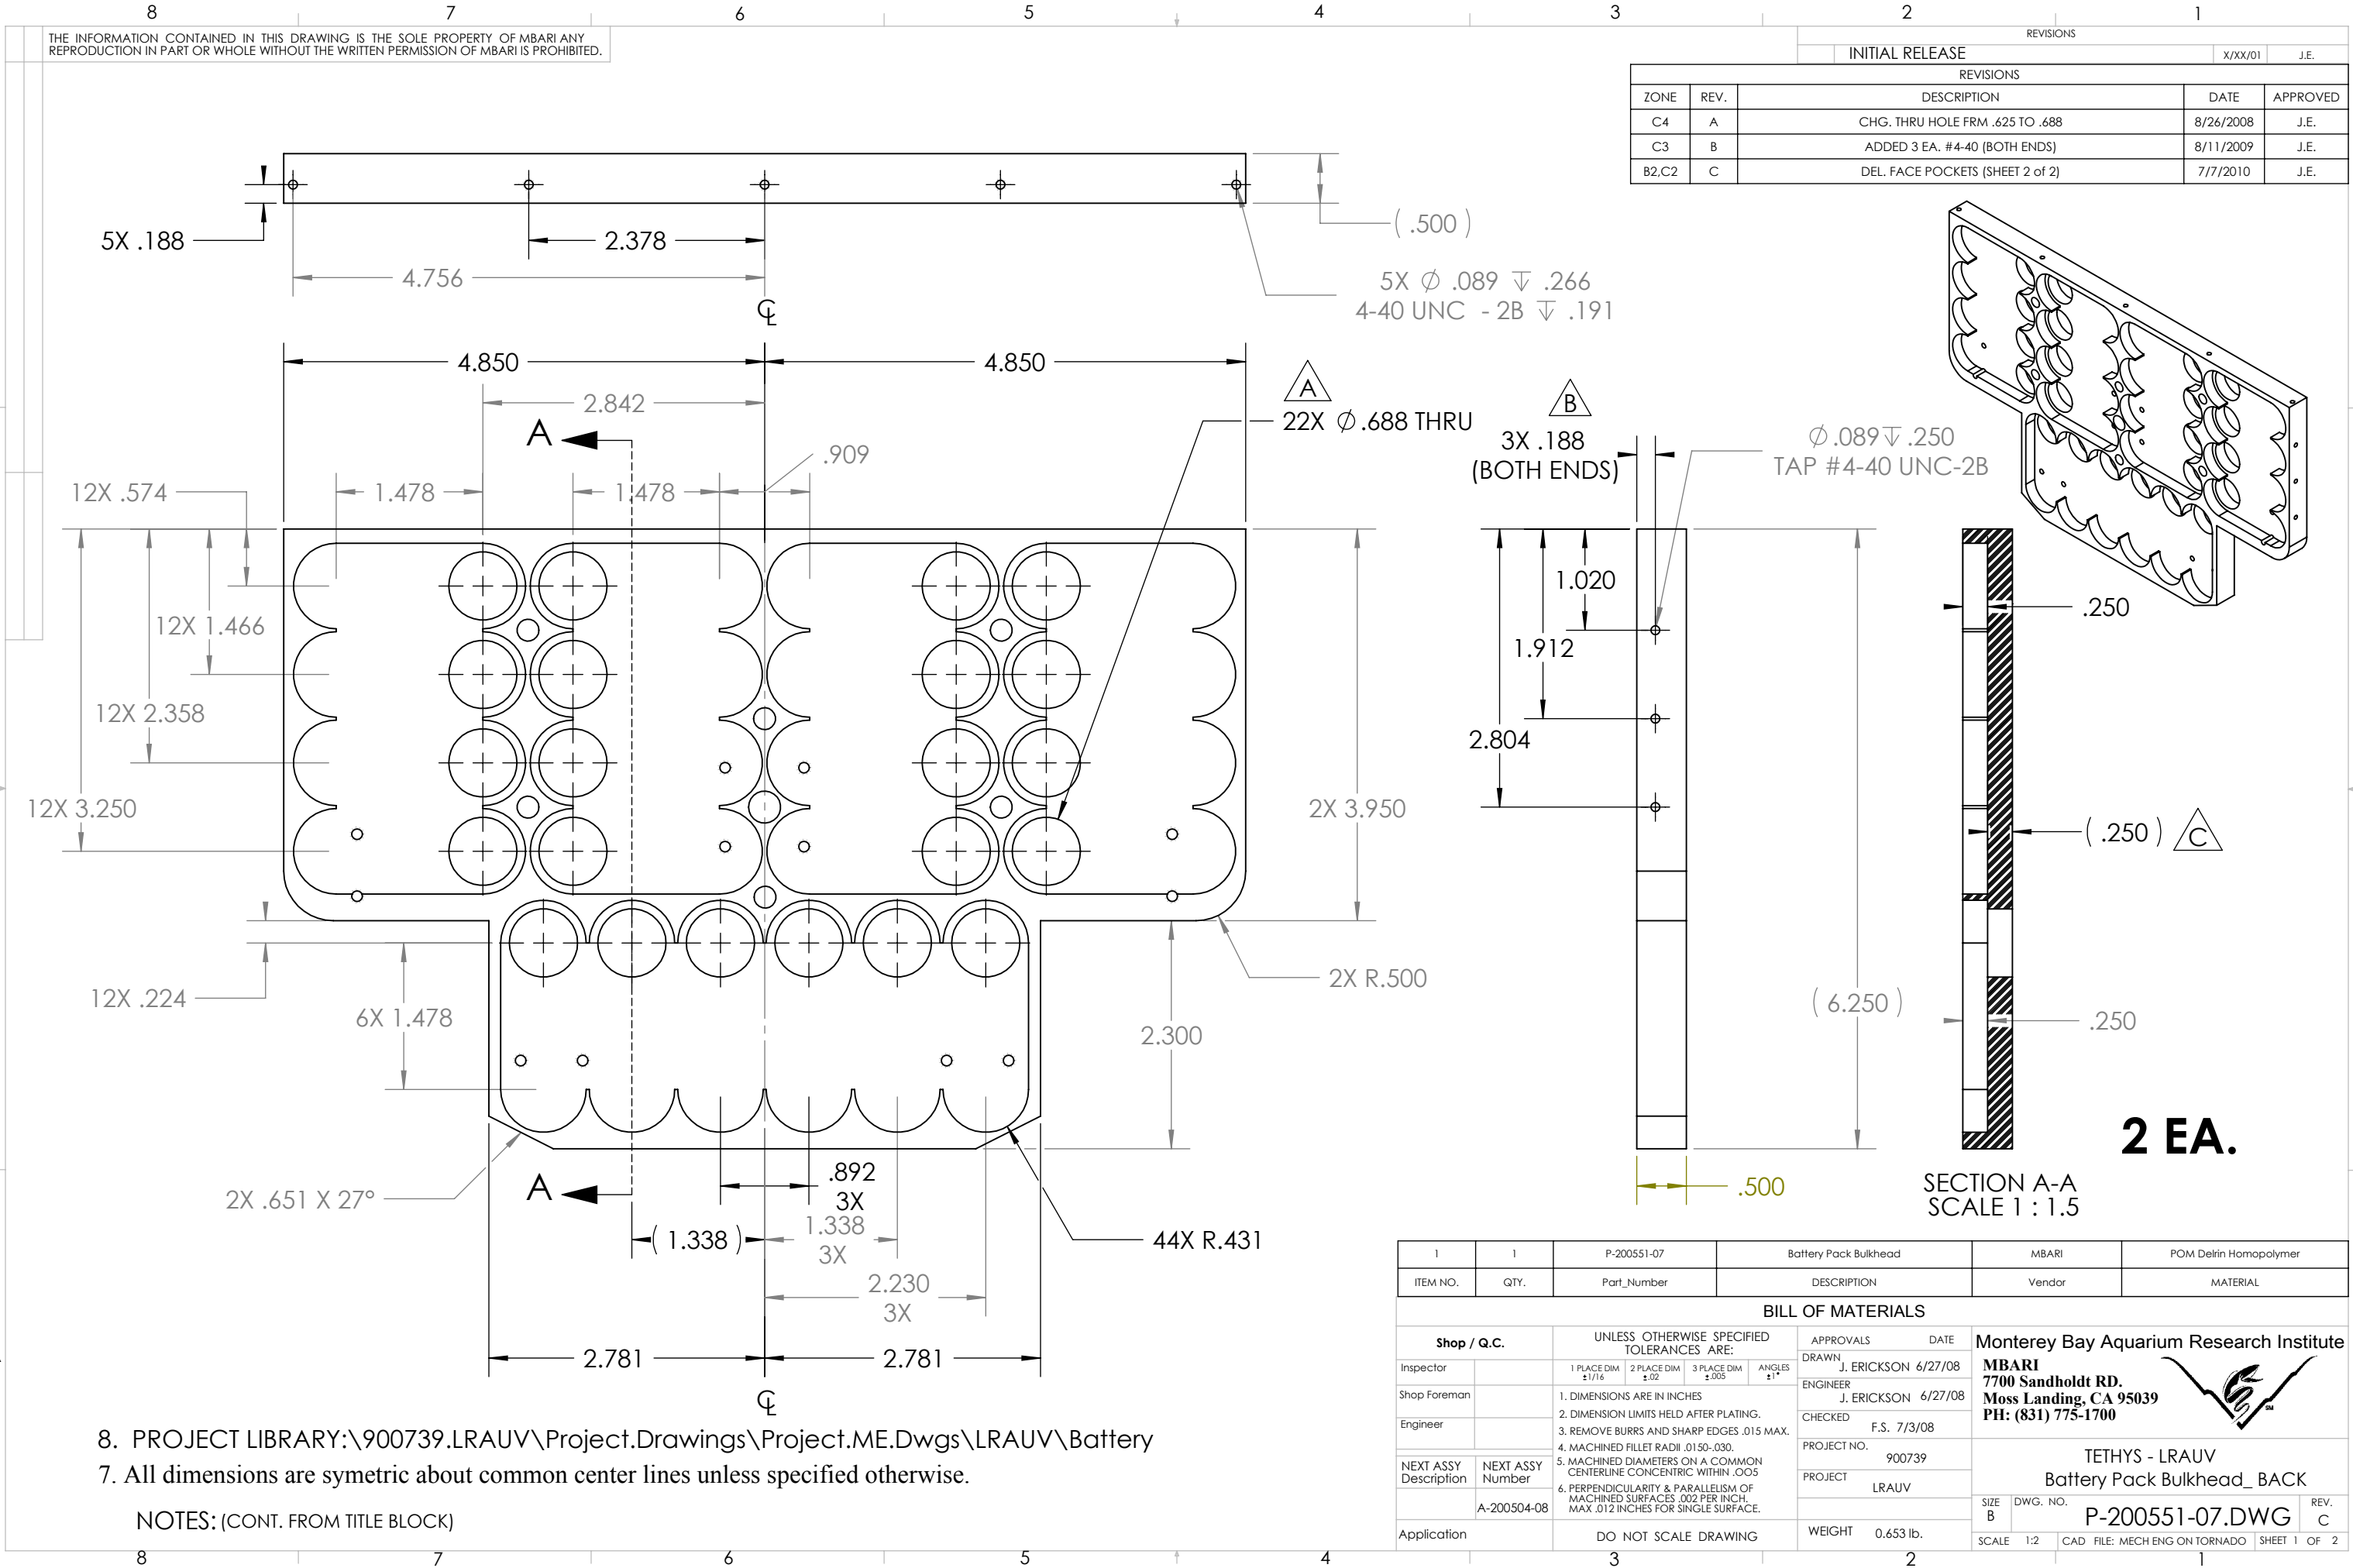


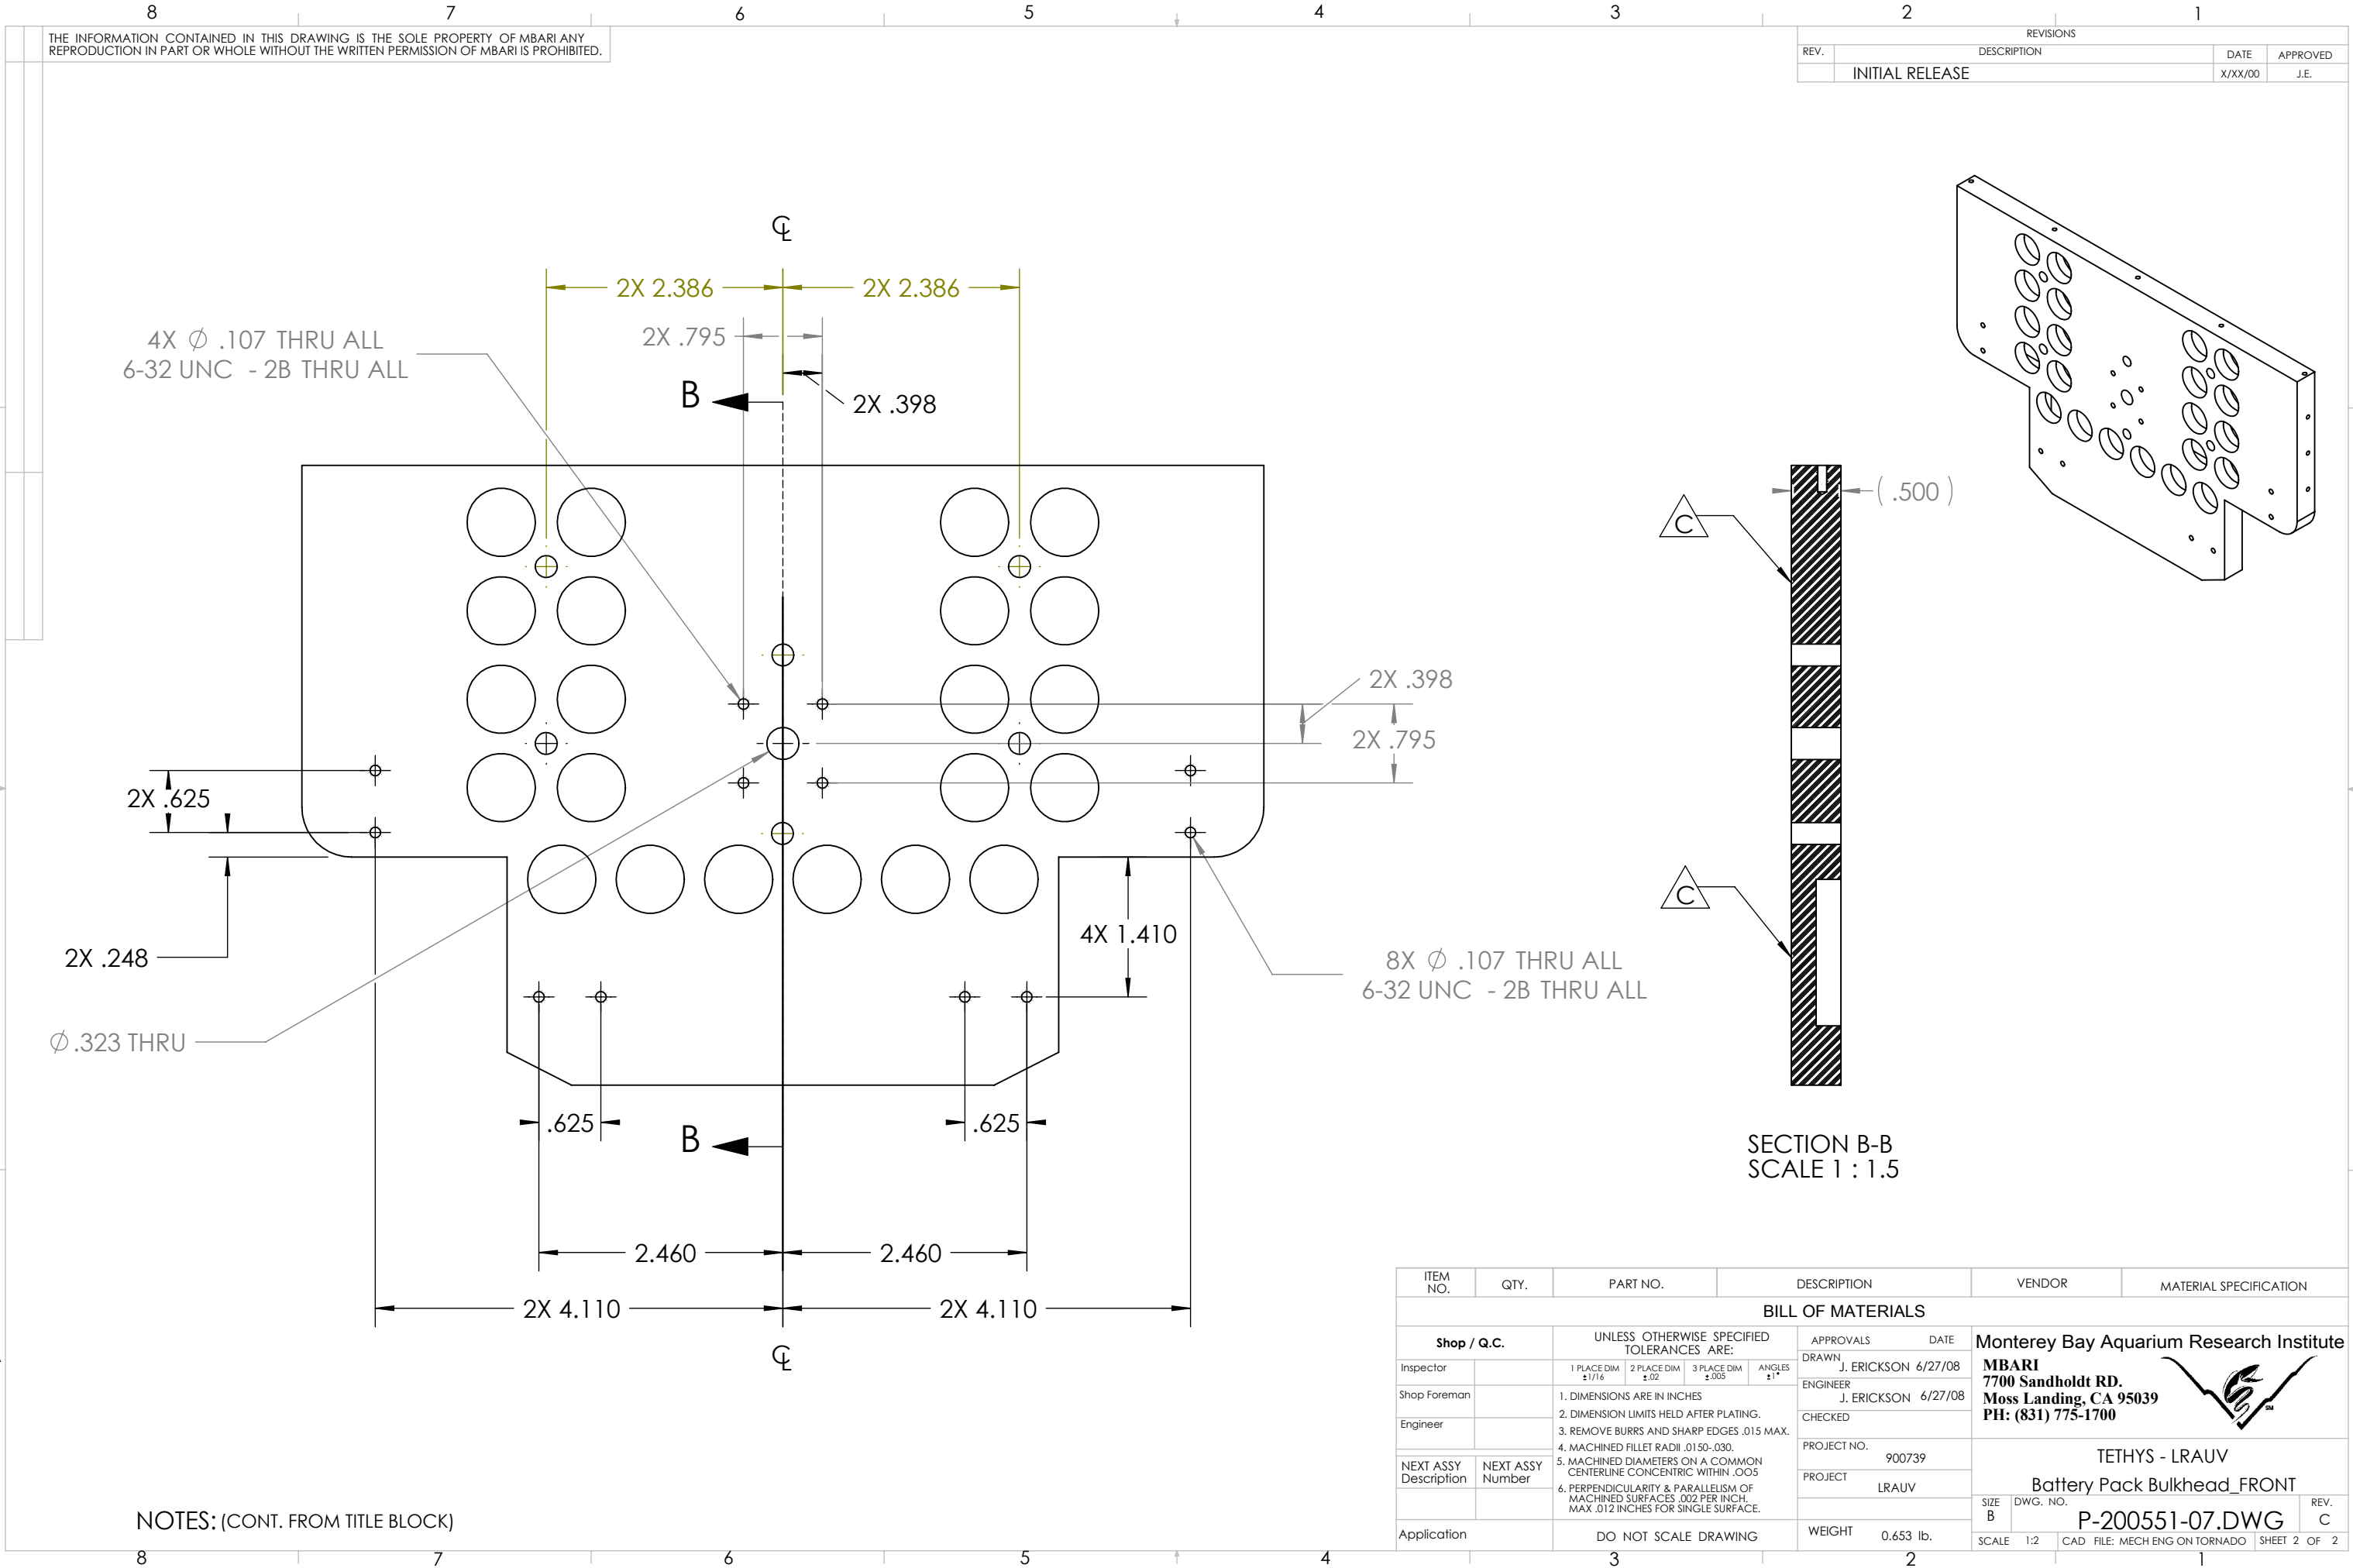

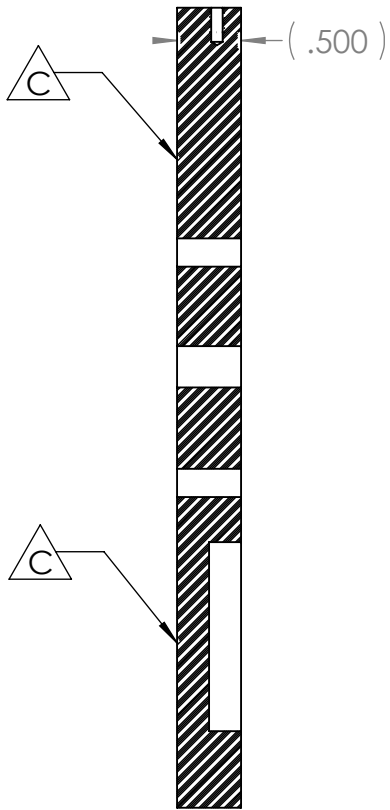

THE INFORMATION CONTAINED IN THIS DRAWING IS THE SOLE PROPERTY OF MBARI ANY REPRODUCTION IN PART OR WHOLE WITHOUT THE WRITTEN PERMISSION OF MBARI IS PROHIBITED.

REVISIONS			
REV.	DESCRIPTION	DATE	APPROVED
	INITIAL RELEASE	X/XX/00	J.E.

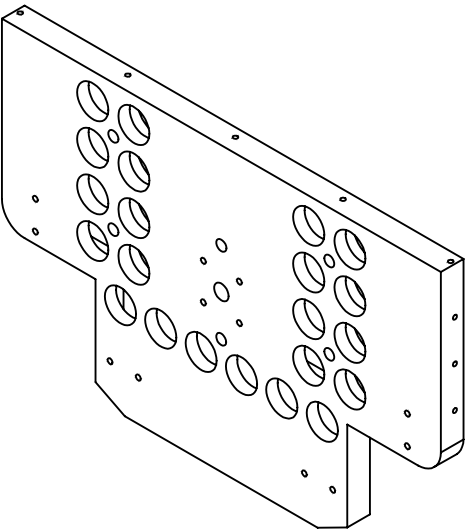

SECTION B-B
SCALE 1 : 1.5

NOTES: (CONT. FROM TITLE BLOCK)

ITEM NO.	QTY.	PART NO.	DESCRIPTION	VENDOR	MATERIAL SPECIFICATION
BILL OF MATERIALS					
Shop / Q.C.		UNLESS OTHERWISE SPECIFIED TOLERANCES ARE:			APPROVALS DATE
Inspector		1 PLACE DIM ±1/16	2 PLACE DIM ±.02	3 PLACE DIM ±.005	ANGLES ±1°
Shop Foreman		1. DIMENSIONS ARE IN INCHES			DRAWN J. ERICKSON 6/27/08
Engineer		2. DIMENSION LIMITS HELD AFTER PLATING.			ENGINEER J. ERICKSON 6/27/08
		3. REMOVE BURRS AND SHARP EDGES .015 MAX.			CHECKED
		4. MACHINED FILLET RADII .0150-.030.			PROJECT NO. 900739
NEXT ASSY Description	NEXT ASSY Number	5. MACHINED DIAMETERS ON A COMMON CENTERLINE CONCENTRIC WITHIN .005			PROJECT LRAUV
		6. PERPENDICULARITY & PARALLELISM OF MACHINED SURFACES .002 PER INCH. MAX .012 INCHES FOR SINGLE SURFACE.			
Application		DO NOT SCALE DRAWING			WEIGHT 0.653 lb.
Monterey Bay Aquarium Research Institute					
MBARI 7700 Sandholdt RD. Moss Landing, CA 95039 PH: (831) 775-1700					
TETHYS - LRAUV Battery Pack Bulkhead_FRONT					
SIZE B		DWG. NO. P-200551-07.DWG			REV. C
SCALE 1:2		CAD FILE: MECH ENG ON TORNADO			SHEET 2 OF 2