

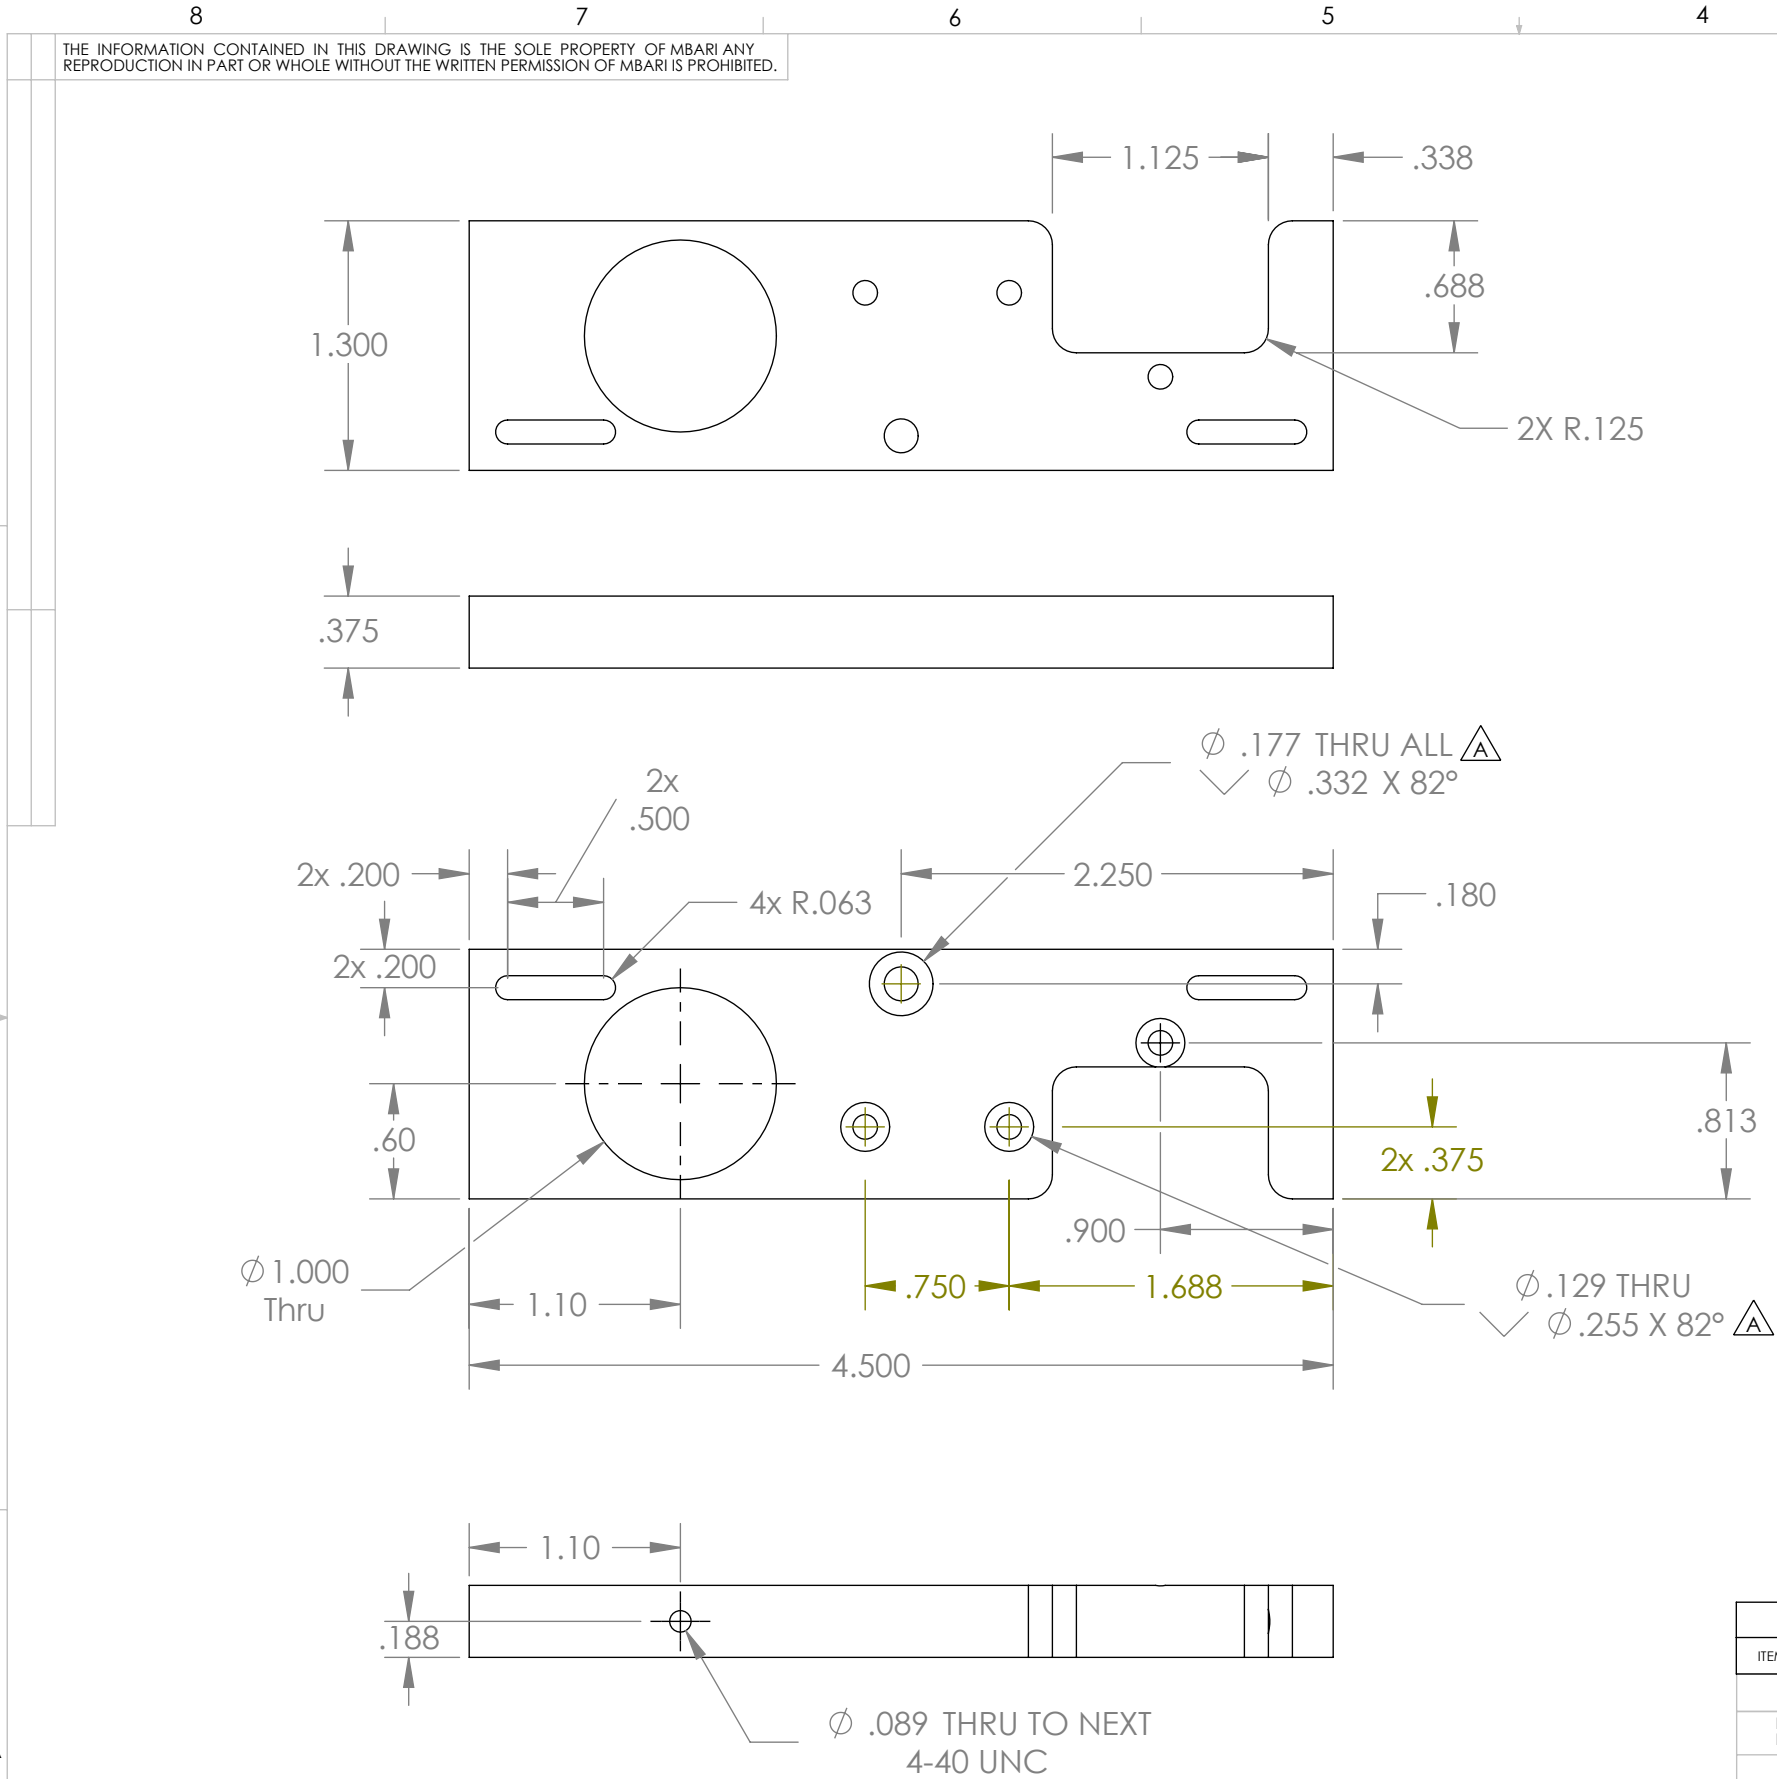


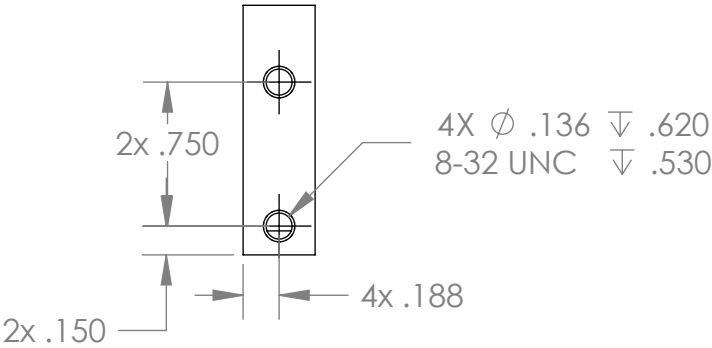

REVISIONS			
REV.	DESCRIPTION	DATE	APPROVED
	INITIAL RELEASE		
A	1. Add Countersinks for add'l baseplate	01Aug2011	F. Shane

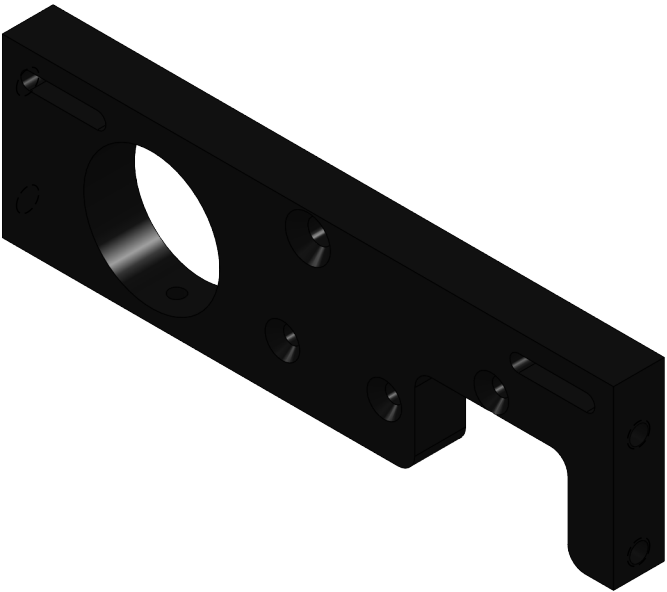

1	1	P-200796-09	DW Crossbar Strb	MBARI	Black Delrin
ITEM NO.	QTY.	Part_Number	DESCRIPTION	Vendor	MATERIAL
BILL OF MATERIALS					
NEXT ASSY Description	NEXT ASSY Number	UNLESS OTHERWISE SPECIFIED TOLERANCES ARE:		APPROVALS	DATE
	A-201500-17	1 PLACE DIM ±1/16	2 PLACE DIM ±.02	DRAWN	10/8/2009
THIRD ANGLE PROJECTION		3 PLACE DIM ±.005	ANGLES ±1°	ENGINEER	B. Hobson
		1. DIMENSIONS ARE IN INCHES 2. DIMENSION LIMITS HELD AFTER PLATING. 3. REMOVE BURRS AND SHARP EDGES .015 MAX. 4. MACHINED FILLET RADII .0150-.030. 5. MACHINED DIAMETERS ON A COMMON CENTERLINE CONCENTRIC WITHIN .005 6. PERPENDICULARITY & PARALLELISM OF MACHINED SURFACES .002 PER INCH, MAX .012 INCHES FOR SINGLE SURFACE.		CHECKED	
				PROJECT NO.	900739
				PROJECT	
				WEIGHT	0.08
		DO NOT SCALE DRAWING		SIZE B	DWG. NO.
				SCALE 1:1	CAD FILE:
				SHEET 1 OF 1	REV. A

8. Q.C. (INSPECTION) REPORT REQUIRED FOR EACH PIECE.

7. PROJECT LIBRARY:\900739.LRAUV\Project.Drawings\Project.ME.Dwgs\LRAUV\Dropweight\

Status: Drop Weight Assembly Rev.3