
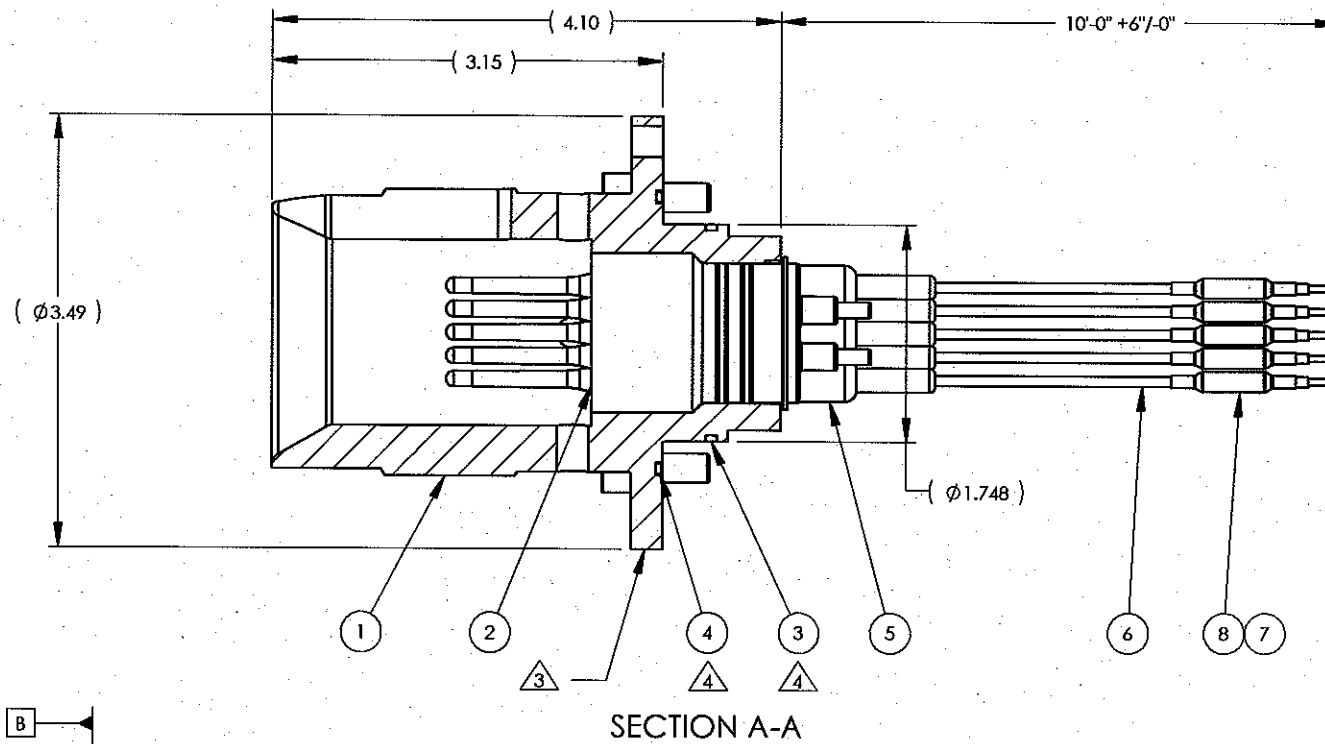


NOTES:
1. DO NOT SCALE FROM DRAWING
2. MATERIAL: SEE PARTS LIST.
3. ENGRAVE THE FOLLOWING APPROX. WHERE SHOWN PER 10632 (SOP-015-39):
"ODI"
S/N _____
CUSTOMER NAME _____
CUSTOMER P/N _____
4. BAG AND TAG MOUNTING HARDWARE,
ATTACH BAG TO CONNECTOR FLANGE.

Connector Compensation
Requires Silicon oil
Part No. xxx

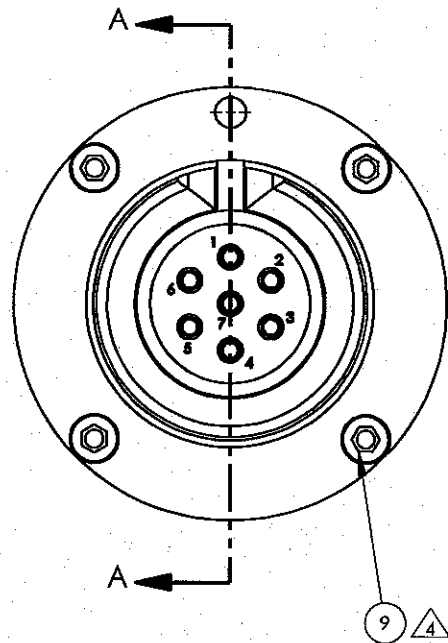

Issued for Approval
☐ A. Approved without comments, Proceed with manufacture.
☒ B. Approved with comments, Incorporate and proceed with manufacture.
☐ C. Revise and resubmit for approval.
Signature _____ Date 1/24/12

- 1 _____
- 2 _____
- 3 _____
- 4 _____
- 5 _____
- 6 _____
- 7 _____



CIRCUIT DIAGRAM

UNCONTROLLED COPY
COPY FOR INFORMATION ONLY
WILL NOT BE KEPT UP TO DATE.

PROPRIETARY TO TELEDYNE ODI, INC.

9	1026371	M6S08H16	M6 X 1 X 16MM, 316 SST	CAP SCR HEX SKT HD	4
8	1013495	RNF100-CL-H00	1/8" CLEAR HEATSHRINK TUBING	TUBING	7 X A/R
7	1000679	44-105	IDENT LABEL	LABEL	7
6	1000727	44A0211-16-9	44A0211-16-9, 16 AWG, 1000V, W	WIRE	7 X A/R
5	1012427	ODN-001-04-13	NAUT BOOT SEAL, ODI037	BOOT SEAL	7
4	1000382	2-034-N674-70	2-034, NITRILE 70	O-RING	1
3	1000371	2-030-N674-70	2-030, NITRILE 70	O-RING	1
2	1011176	NAUT/4-7	7-WAY NAUTILUS PLUG MODULE	MODULE, PLUG	1
1	1040850	ASM-111-04-2	7-WAY STAB FXD PLUG SHELL, 316L SST	SHELL, PLUG	1
ITEM	PART #	REF #	DESCRIPTION	STANDARD NAME	QTY.

PARTS LIST

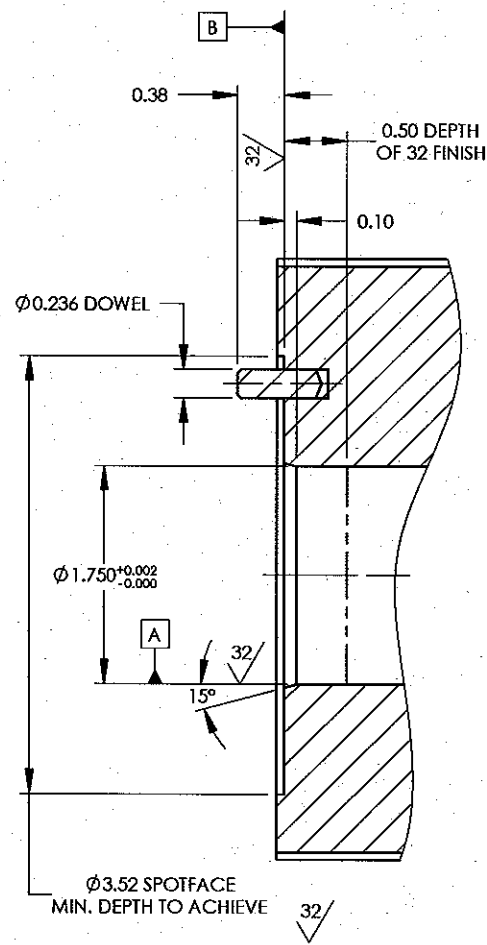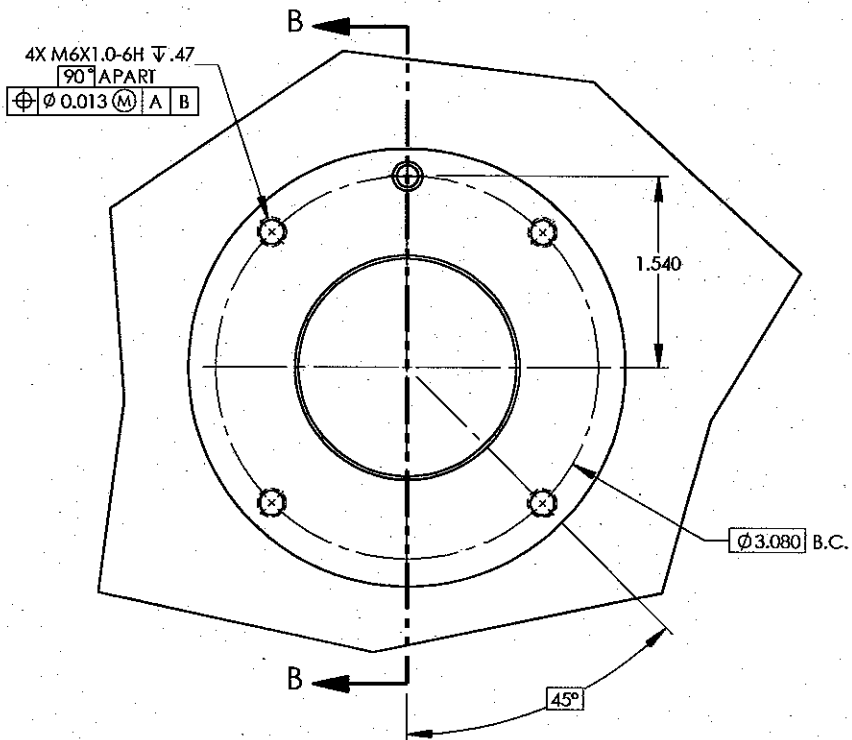

FIXED MOUNTING INTERFACE

SECTION B-B

ALL DATA AND INFORMATION CONTAINED OR DISCLOSED BY THIS DOCUMENT IS PROPRIETARY INFORMATION OF TELEDYNE ODI, INC. AND ALL RIGHTS THEREIN ARE EXPRESSLY RESERVED. BY ACCEPTING THIS MATERIAL THE RECIPIENT AGREES THAT THE MATERIAL AND THE INFORMATION CONTAINED THEREIN IS HELD IN CONFIDENCE AND IN TRUST AND WILL NOT BE USED, COPIED, REPRODUCED IN WHOLE OR IN PART, NOR ITS CONTENTS REVEALED IN ANY MANNER TO OTHERS, EXCEPT TO MEET THE SPECIFIC PURPOSE FOR WHICH IT WAS DELIVERED.



UNLESS OTHERWISE SPECIFIED DIMENSIONS ARE IN INCHES.
ENGINEERING DRAWING PRACTICES IN ACCORDANCE WITH ASME Y14.100-2004

THIRD ANGLE PROJECTION

		TELEDYNE ODI A Teledyne Technologies Company	
APPROVALS	DATE	7W FXD STAB PLUG NO TERM WITH PIGTAILS GA DRAWING W/ PARTS LIST	
DRAWN	PP		
CHECKED			
ENGR			
DESIGN			
SIZE	B	CAGE CODE	0VV88
SCALE	1:1.5	DOC. NO.	355592
		PART NO.	1067664
		REF. NO.	COS-263-01
		REV	A
		SHEET 1 OF 1	SW

NOTES:
1. DO NOT SCALE FROM DRAWING
2. MATERIAL: SEE PARTS LIST.
3. ENGRAVE THE FOLLOWING APPROX. WHERE SHOWN PER 10632 (SOP-015-39):
"ODI"
S/N _____
CUSTOMER NAME _____
CUSTOMER P/N _____
4. BAG AND TAG MOUNTING HARDWARE,
ATTACH BAG TO CONNECTOR FLANGE.

Any Connector Compensation
will be Silicon oil
part No. XXXXX

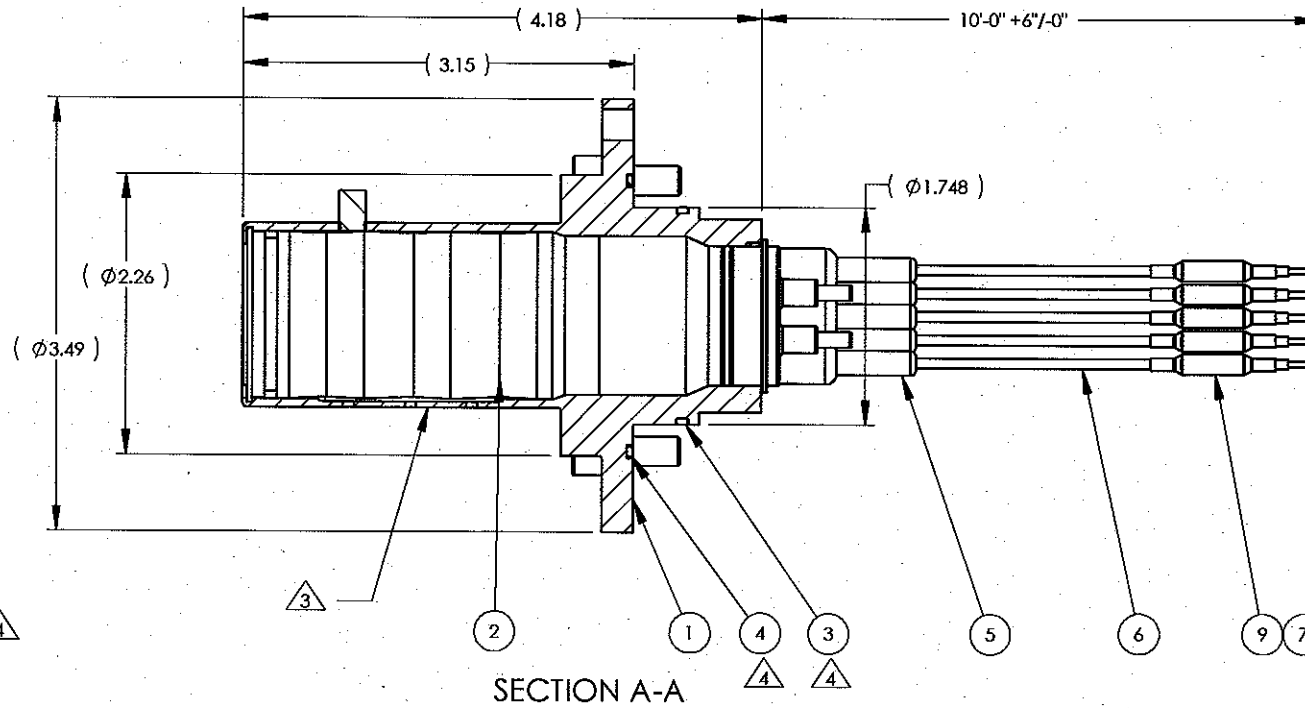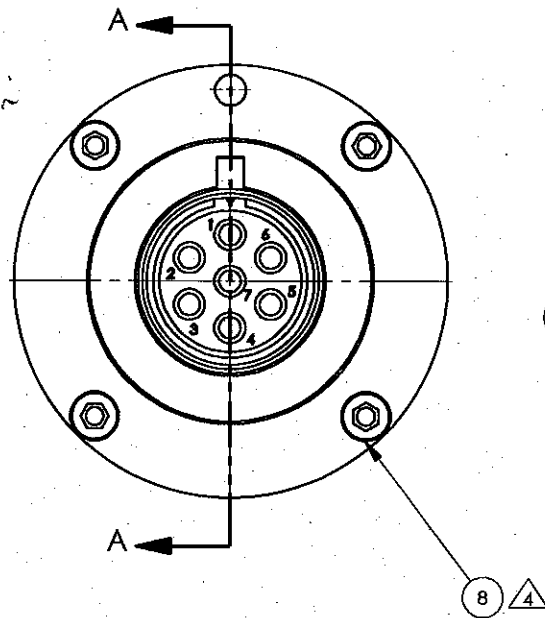

Issued for Approval
☐ A. Approved without comments,
Proceed with manufacture.
☒ B. Approved with comments,
Incorporate and proceed with
manufacture.
☐ C. Revise and resubmit for approval.

Signature *C. E. ...* Date *1/24/12*

- 1) 16 AWG
- 2) 16 AWG
- 3) 16 AWG
- 4) 16 AWG
- 5) 16 AWG
- 6) 16 AWG
- 7) 16 AWG



CIRCUIT DIAGRAM

UNCONTROLLED COPY
COPY FOR INFORMATION ONLY
WILL NOT BE KEPT UP TO DATE.

PROPRIETARY TO TELEDYNE ODI, INC.

9	1013495	RNF100-CL-H00	1/8" CLEAR HEATSHRINK TUBING	TUBING	7 X A/R
8	1010696	M6T08H16	M6 X 1 X 16MM, TI CP GR 2	CAP SCR HEX SKT HD	4
7	1000679	44-105	IDENT LABEL	LABEL	7
6	1000727	44A0211-16-9	44A0211-16-9, 16 AWG, 1000V, W	WIRE	7 X A/R
5	1012427	ODN-001-04-13	NAUT BOOT SEAL, OD1037	BOOT SEAL	7
4	1000382	2-034-N674-70	2-034, NITRILE 70	O-RING	1
3	1000371	2-030-N674-70	2-030, NITRILE 70	O-RING	1
2	1011146	NAUT/3-7-T	7-WAY NAUTILUS RCPT MODULE S/A	MODULE, RECEPTACLE	1
1	1067932	ASM-103-04-2	6-WAY STAB FXD RCPT SHELL, TI GR 2	SHELL, RECEPTACLE	1
ITEM	PART #	REF #	DESCRIPTION	STANDARD NAME	QTY.

PARTS LIST

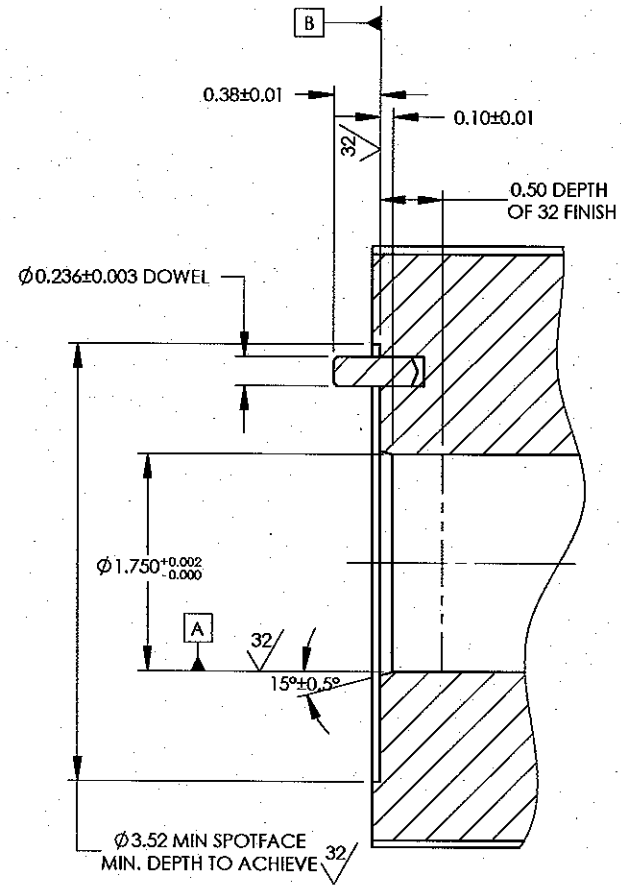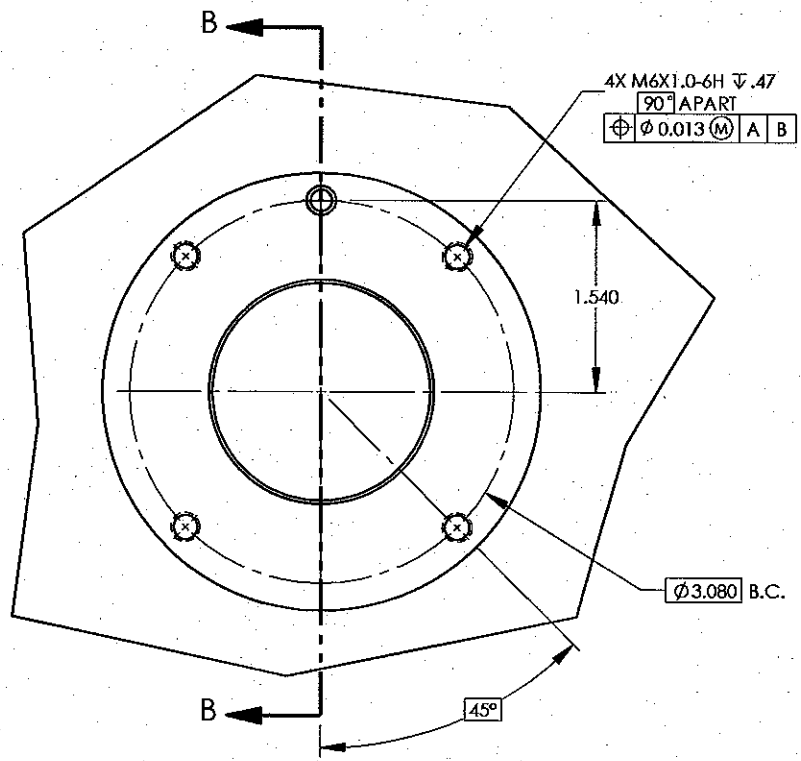

SECTION B-B

ALL DATA AND INFORMATION CONTAINED
OR DISCLOSED BY THIS DOCUMENT IS
PROPRIETARY INFORMATION OF
TELEDYNE ODI, INC. AND ALL RIGHTS
THEREIN ARE EXPRESSLY RESERVED.
BY ACCEPTING THIS MATERIAL THE
RECIPIENT AGREES THAT THE MATERIAL
AND THE INFORMATION CONTAINED
THEREIN IS HELD IN CONFIDENCE
AND IN TRUST AND WILL NOT BE USED,
COPIED, REPRODUCED IN WHOLE
OR IN PART, NOR ITS CONTENTS REVEALED
IN ANY MANNER TO OTHERS,
EXCEPT TO MEET THE SPECIFIC PURPOSE
FOR WHICH IT WAS DELIVERED.

UNLESS OTHERWISE SPECIFIED
DIMENSIONS ARE IN INCHES.

ENGINEERING DRAWING
PRACTICES IN ACCORDANCE WITH
ASME Y14.100-2004



THIRD ANGLE PROJECTION




TELEDYNE ODI
A Teledyne Technologies Company

APPROVALS	DATE	7W FXD STAB RCPT NO TERM WITH PIGTAILS GA DRAWING W/ PARTS LIST		
DRAWN	PP	SIZE	CAGE CODE	DOC. NO.
CHECKED		B	0VV88	355590
ENGR		SCALE	PART NO.	REV
DESIGN		1:1.5	1067662	A
			COS-262-01	SHEET 1 OF 1

NOTES:
1. DO NOT SCALE FROM DRAWING
2. MATERIAL: SEE PARTS LIST.
3. FOR MOUNTING DETAILS SEE D/N 156170 (KSC-501-03)
4. ENGRAVE THE FOLLOWING APPROX. WHERE SHOWN PER 10632 (SOP-015-39):
"ODI"
S/N
CUSTOMER NAME
CUSTOMER P/N
BAG AND TAG MOUNTING HARDWARE, ATTACH BAG TO CONNECTOR FLANGE.

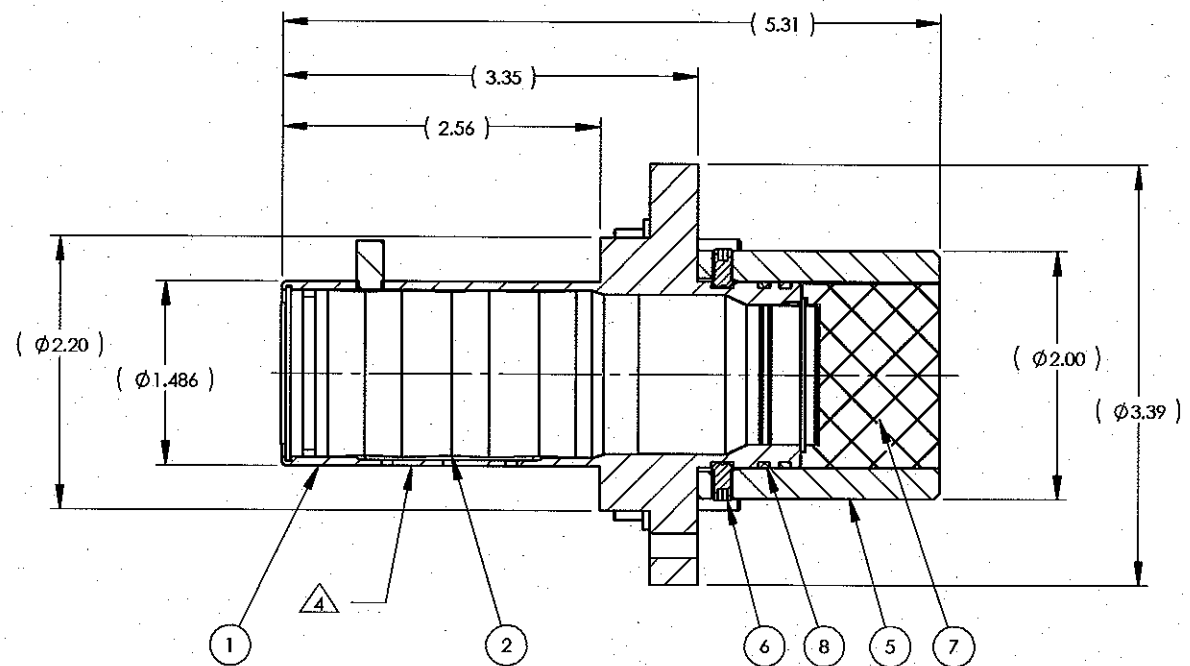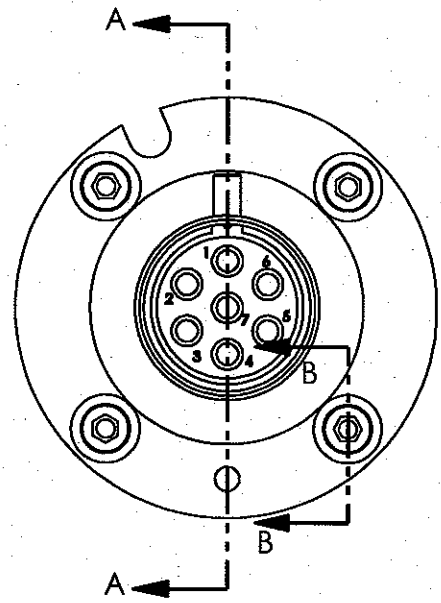


SECTION A-A

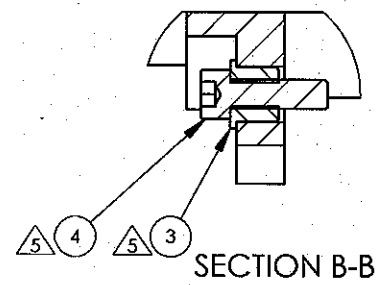


SECTION B-B

UNCONTROLLED COPY
COPY FOR INFORMATION ONLY
WILL NOT BE KEPT UP TO DATE.
PROPRIETARY TO TELEDYNE ODI, INC.

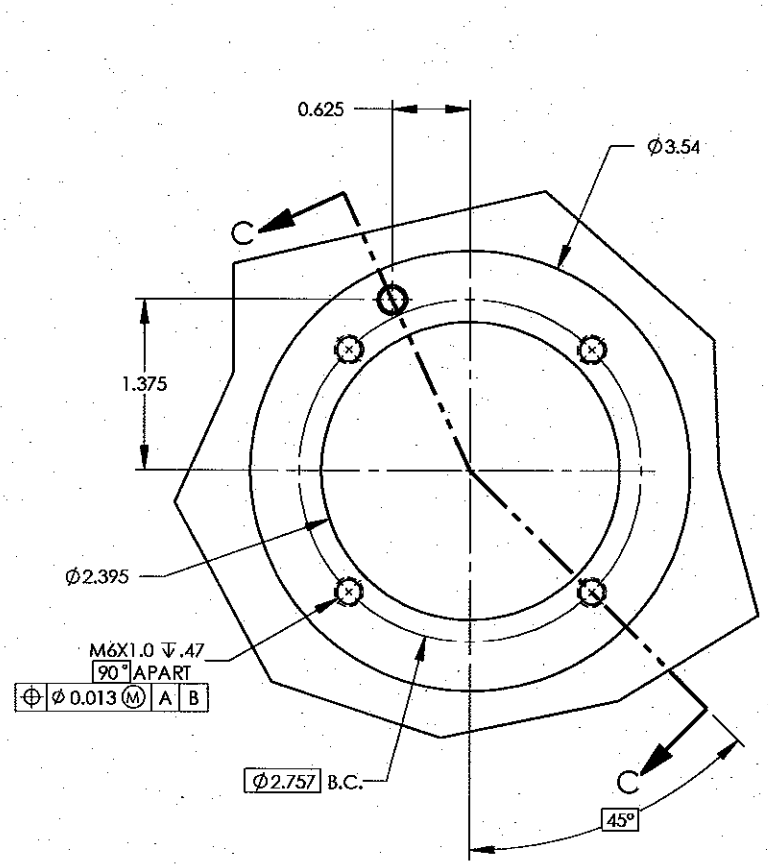

FIXED MOUNTING INTERFACE

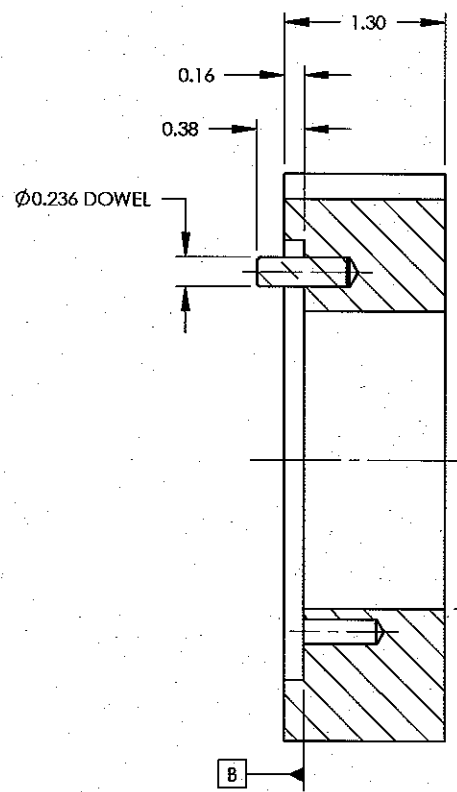

SECTION C-C

- Issued for Approval
- ☐ A. Approved without comments, Proceed with manufacture.
 - ☒ B. Approved with comments, Incorporate and proceed with manufacture.
 - ☐ C. Revise and resubmit for approval.

Signature: *[Signature]* Date: *1/24/12*

8	1000366	2-028-N674-70	2-028 NITRILE 70	O-RING	2
7	1013314	PRC1547	POTTING COMPOUND, POLY. (AMBER)	COMPOUND, POTTING	1
6	1001120	832S02H05	8-32 UNC-2A X 5/16, 316 SST	SET SCR HEX SKT CUP PT	4
5	1050055	WOD-097-04-2	POTTING SLEEVE, DELRIN	SLEEVE, POTTING	1
4	1025207	M6S08H20	M6 X 1 X 20MM, 316 SST	CAP SCR HEX SKT HD	4
3	1027444	ROV-162-04-4	INSULATION BUSHING, 316L SST	BUSHING	4
2	1005865	DNAUT/3-7	7-WAY DUMMY RCPT MODULE S/A	MODULE, RECEPTACLE	1
1	1049625	KSC-047-04-1	7W STAB RCPT SHELL, 316L SST	SHELL, RECEPTACLE	1
ITEM	PART #	REF #	DESCRIPTION	STANDARD NAME	QTY.

ALL DATA AND INFORMATION CONTAINED OR DISCLOSED BY THIS DOCUMENT IS PROPRIETARY INFORMATION OF TELEDYNE ODI, INC. AND ALL RIGHTS THEREIN ARE EXPRESSLY RESERVED. BY ACCEPTING THIS MATERIAL THE RECIPIENT AGREES THAT THE MATERIAL AND THE INFORMATION CONTAINED THEREIN IS HELD IN CONFIDENCE AND IN TRUST AND WILL NOT BE USED, COPIED, REPRODUCED IN WHOLE OR IN PART, NOR ITS CONTENTS REVEALED IN ANY MANNER TO OTHERS, EXCEPT TO MEET THE SPECIFIC PURPOSE FOR WHICH IT WAS DELIVERED.

UNLESS OTHERWISE SPECIFIED DIMENSIONS ARE IN INCHES.

ENGINEERING DRAWING PRACTICES IN ACCORDANCE WITH ASME Y14.100-2004

THIRD ANGLE PROJECTION

TELEDYNE ODI
A Teledyne Technologies Company

7W STAB FLTG DUMMY RCPT NO TERM
GA DRAWING W/ PARTS LIST

APPROVALS	DATE
DRAWN PP	12-02-2011
CHECKED	
ENGR	
DESIGN	

SIZE B	CAGE CODE 0VV88	DOC. NO. 353755	REV A
SCALE 1:1.5	PART NO. 1067654	REF. NO. COS-261-01	SHEET 1 OF 1 SW