


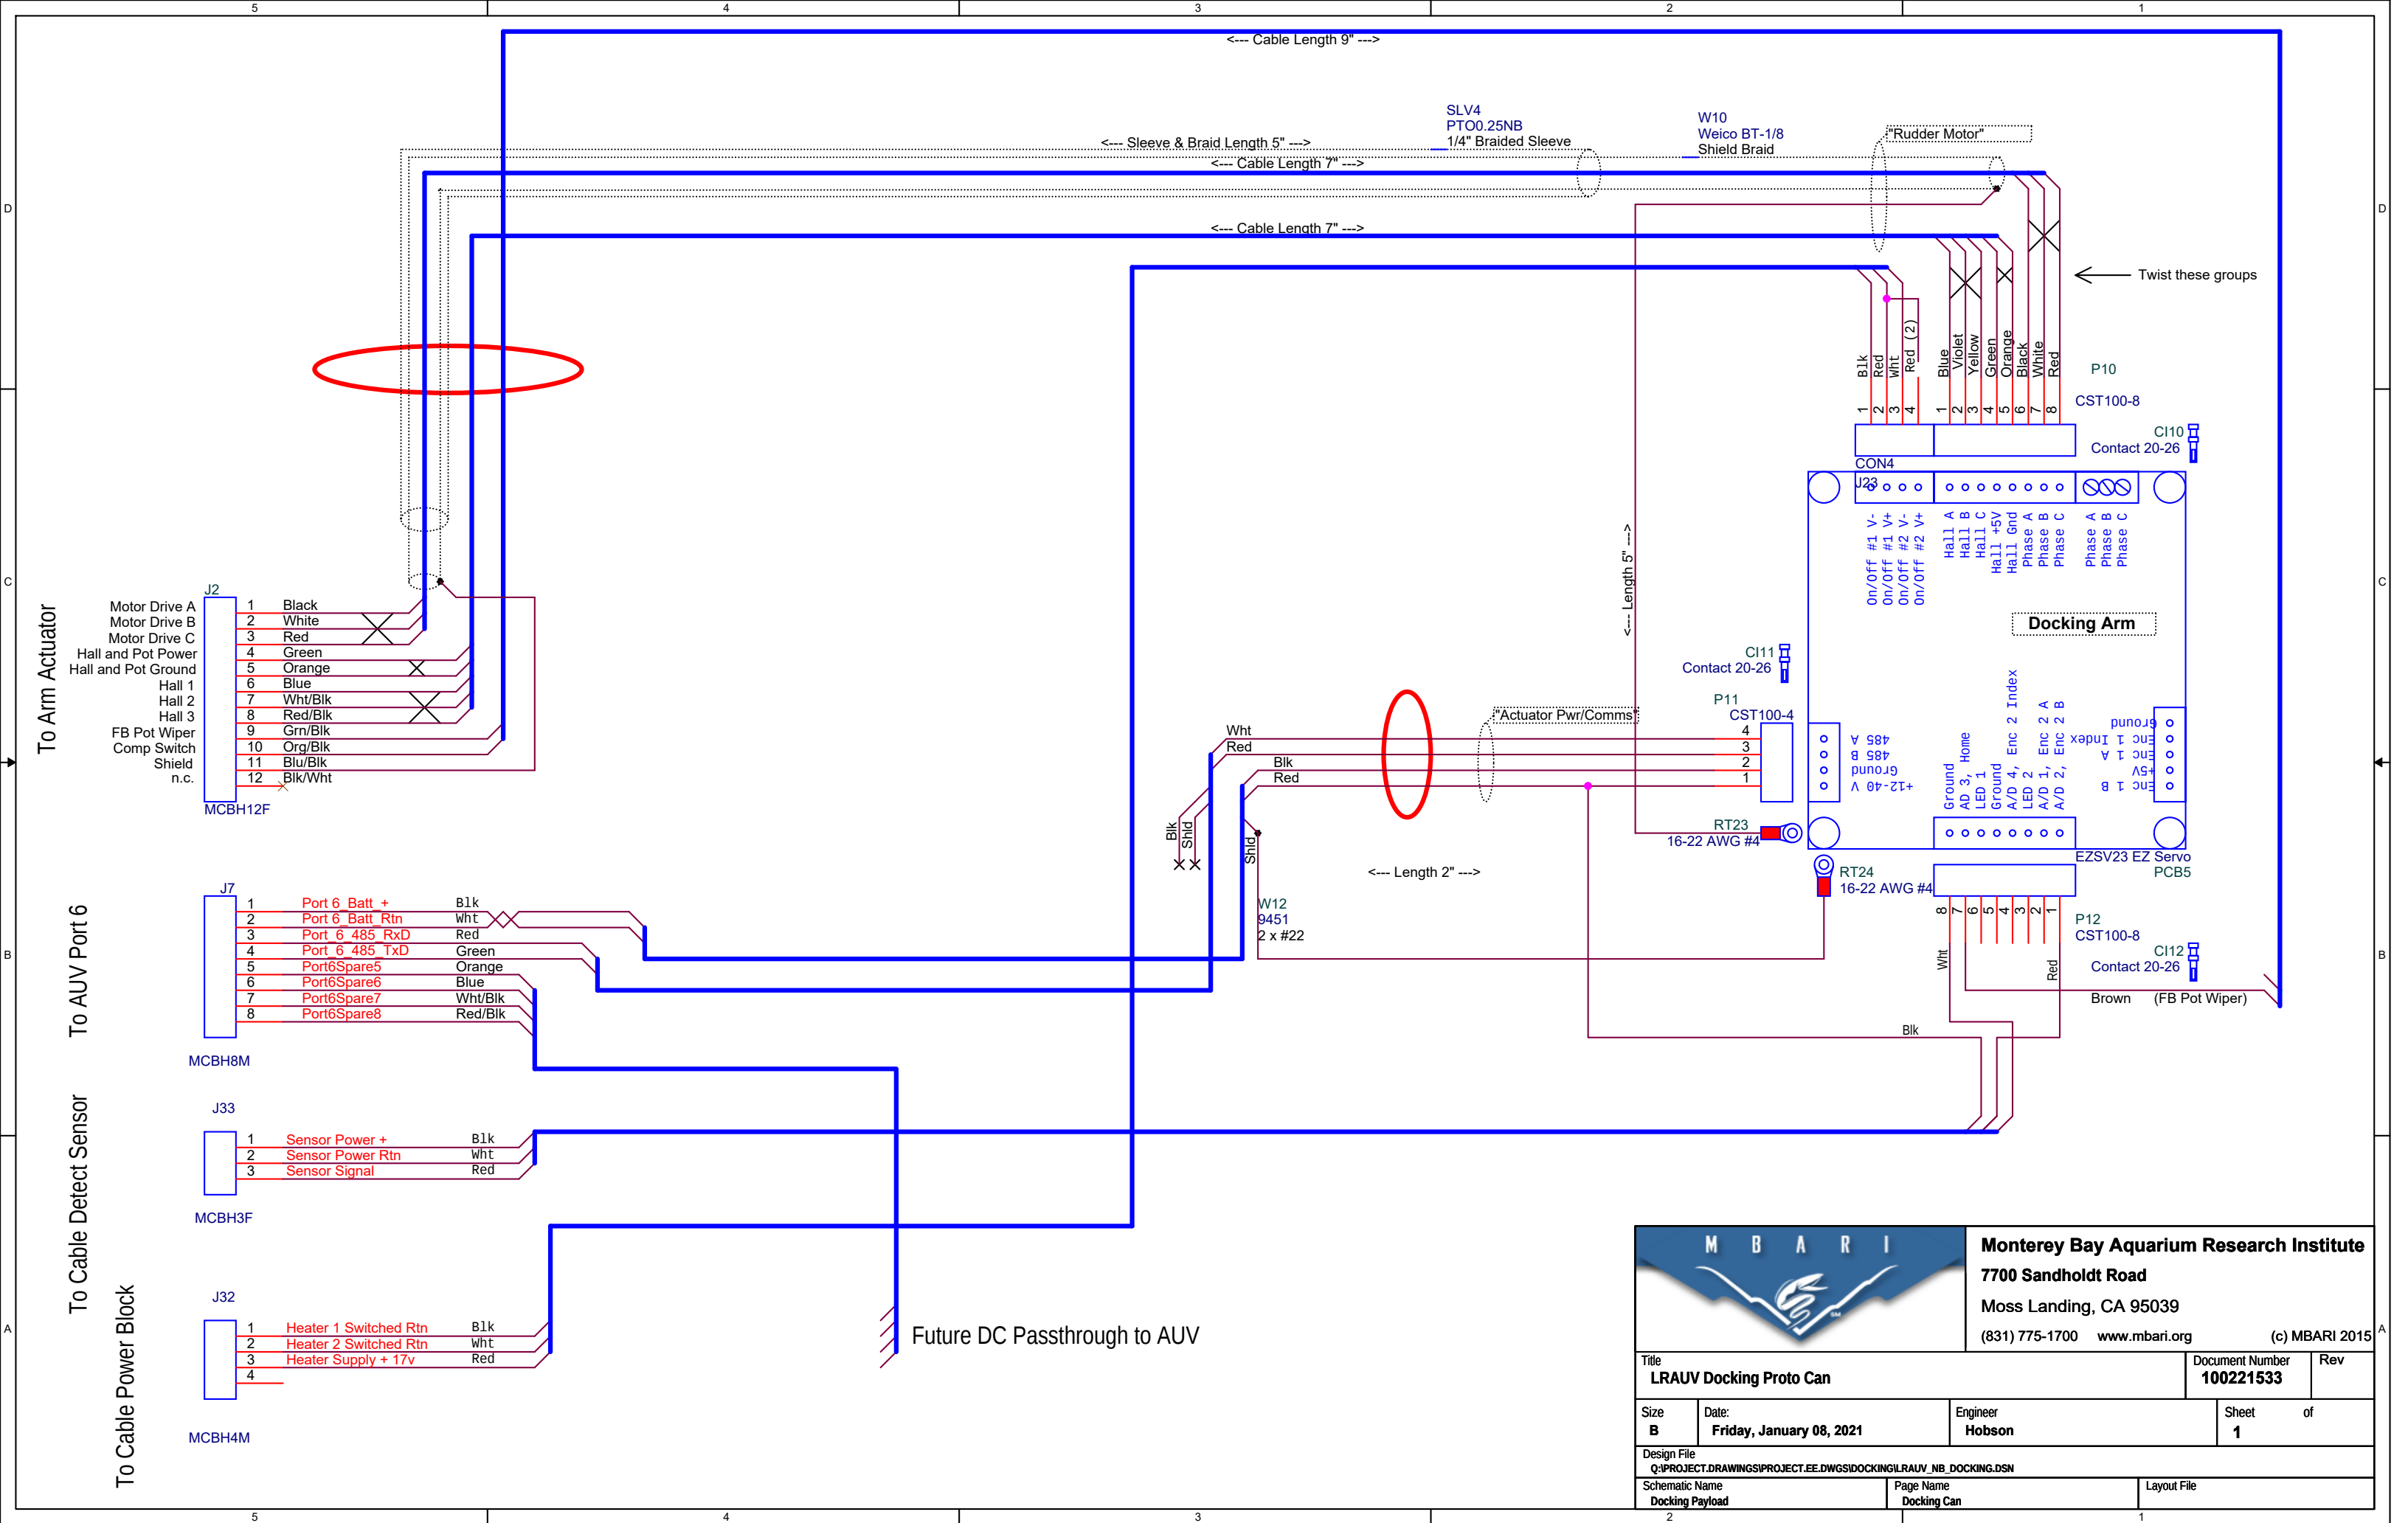



Monterey Bay Aquarium Research Institute
7700 Sandholdt Road
Moss Landing, CA 95039
(831) 775-1700 www.mbari.org (c) MBARI 2015

Title LRAUV Docking Proto Can		Document Number 100221533	Rev
Size B	Date: Friday, January 08, 2021	Engineer Hobson	Sheet 1 of
Design File Q:\PROJECT.DRAWINGS\PROJECT.EE.DWGS\DOCKING\LRAUV_NB.DOCKING.DSN			
Schematic Name Docking Payload		Page Name Docking Can	Layout File