

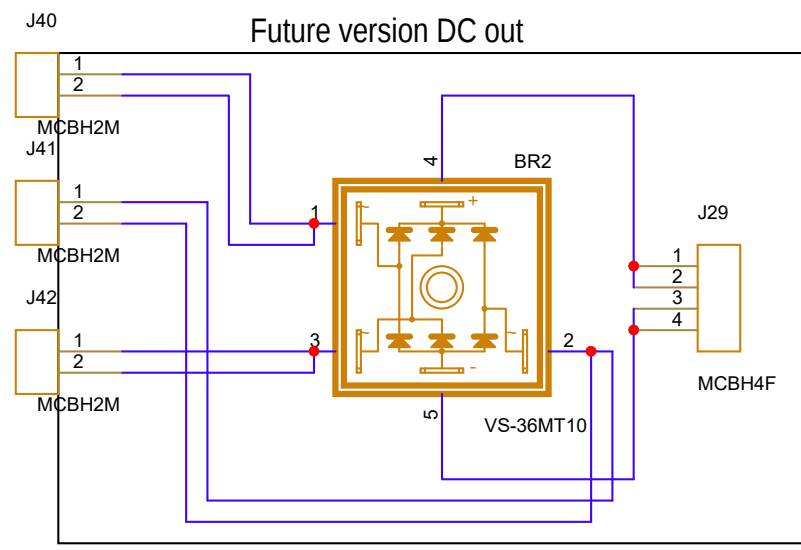


Charge Cable
Present
Switch

3 NB Brushes

Added 2nd brush on each bus 10/24/22

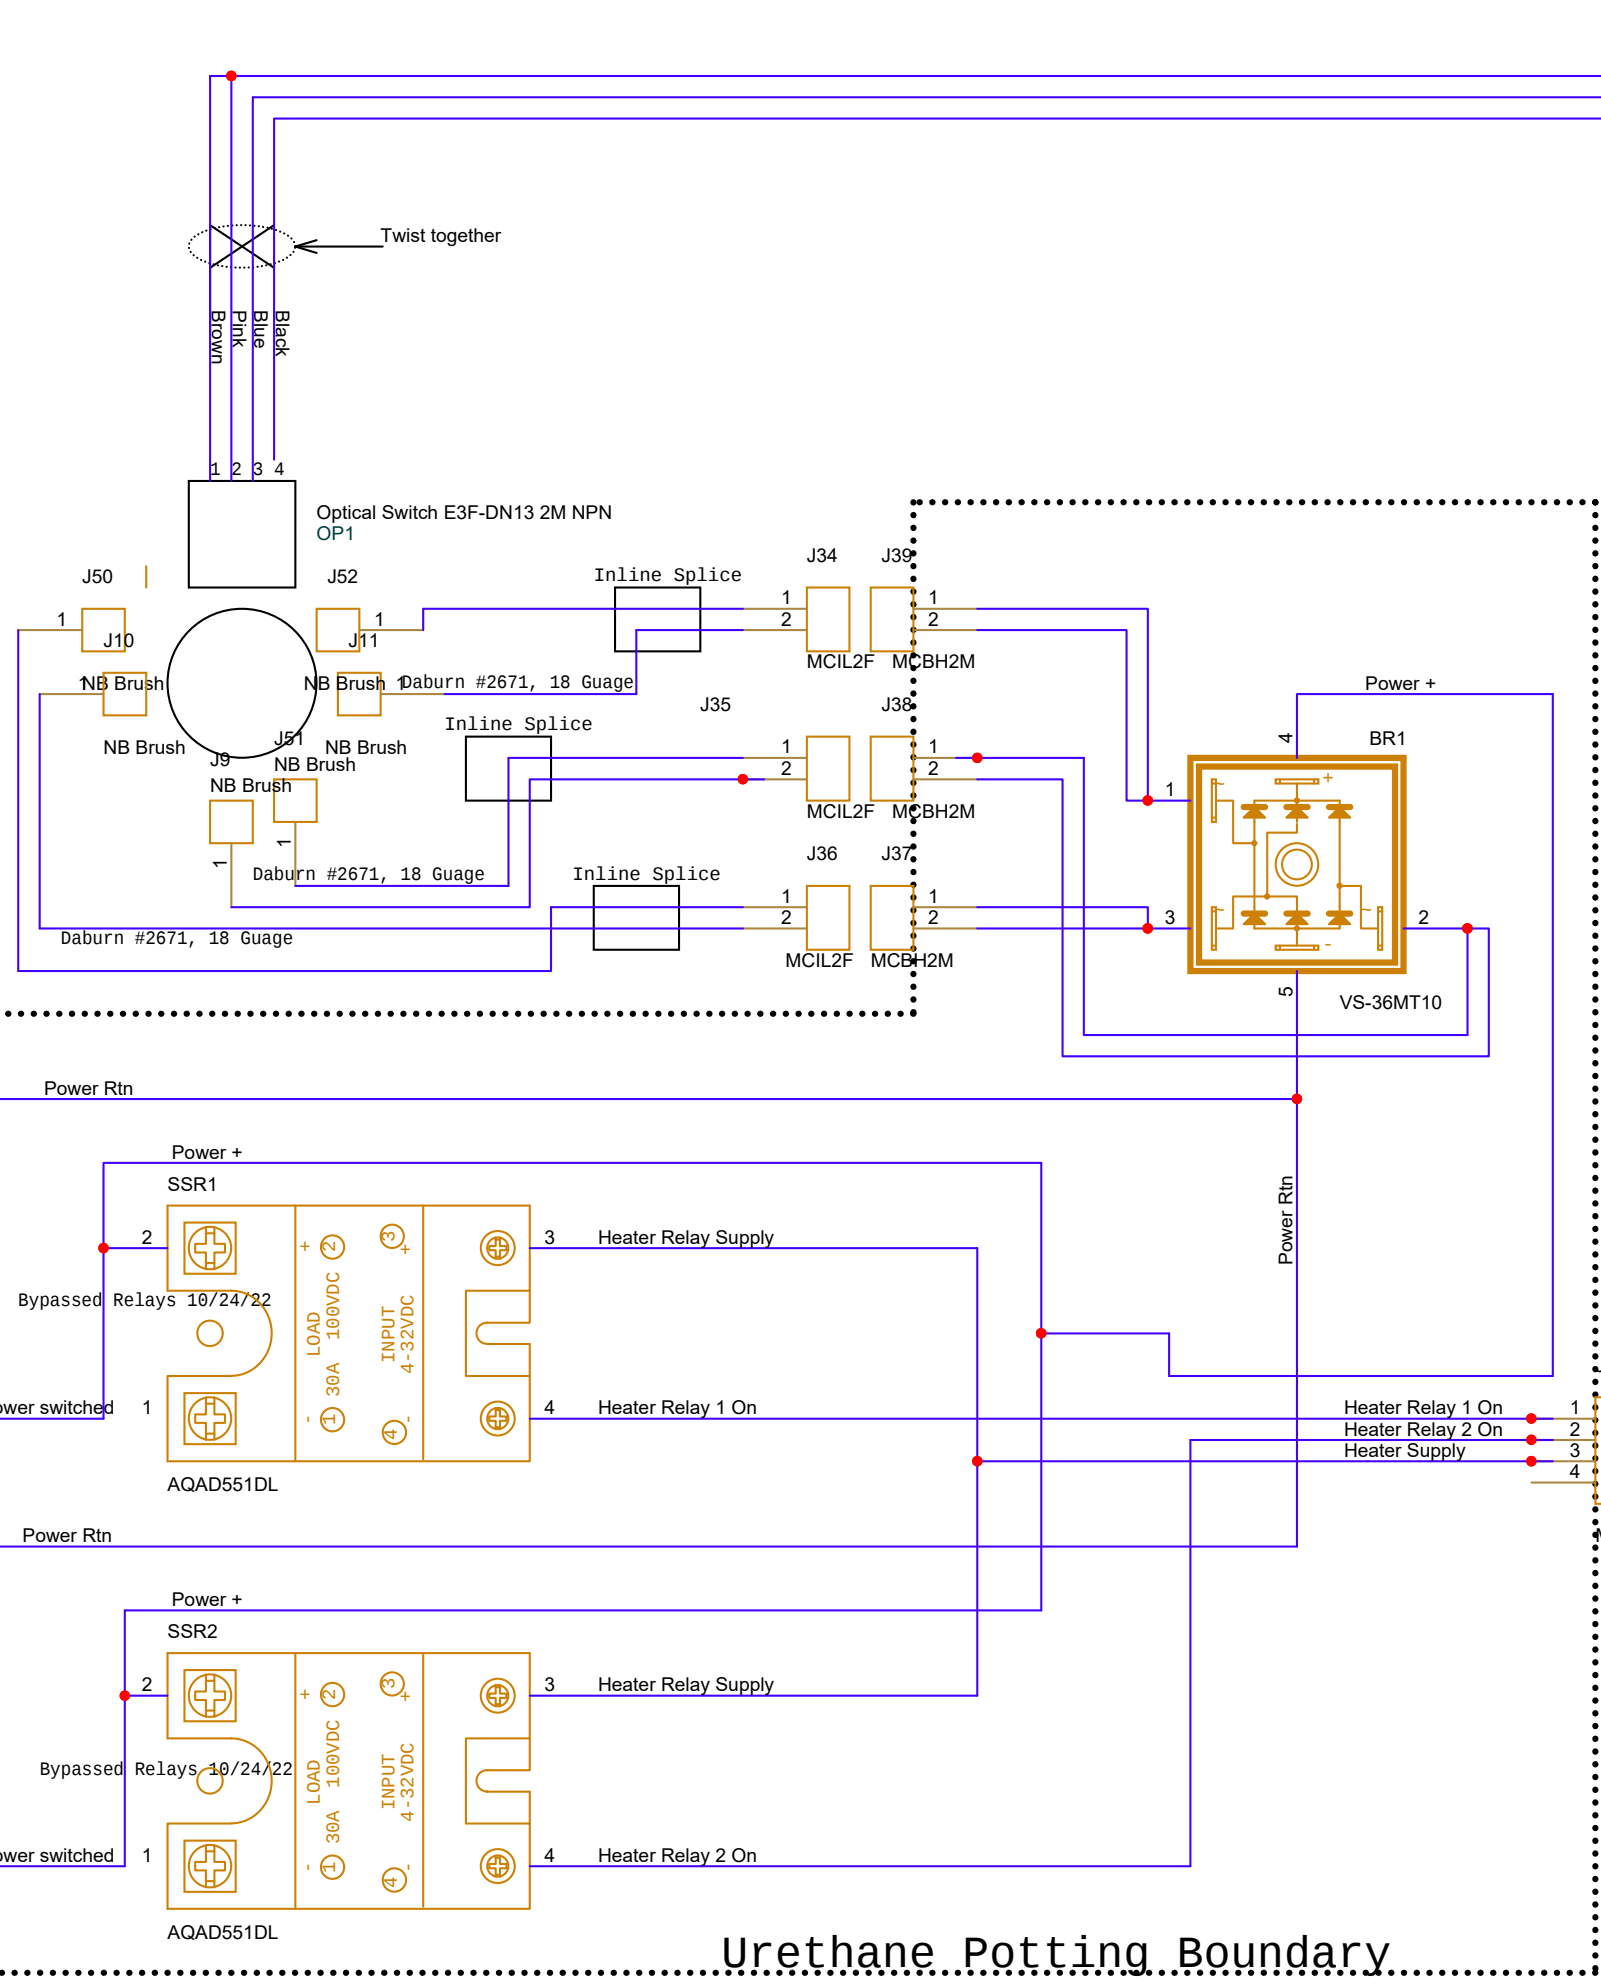

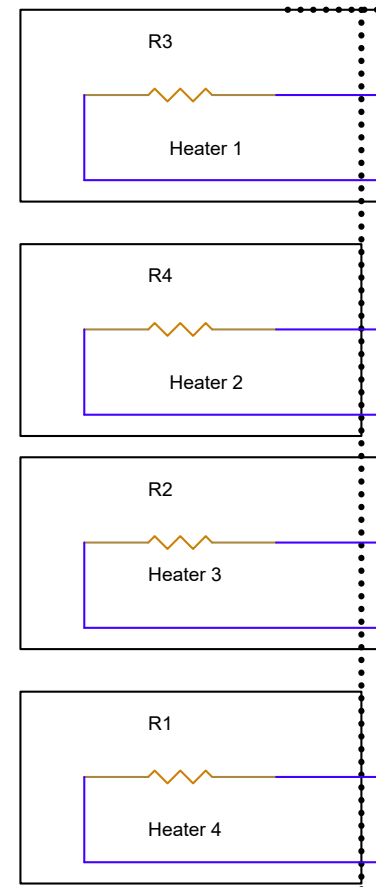

Monterey Bay Aquarium Research Institute
7700 Sandholdt Road
Moss Landing, CA 95039
(831) 775-1700 www.mbari.org (c) MBARI 2015

Title LRAUV Docking Overview		Document Number 100221534		Rev
Size B	Date: Monday, October 24, 2022	Engineer Hobson	Sheet 1	of
Design File R:\PROJECT.DRAWINGS\PROJECT.EE.DWG\SDOCKING 2022\2022AUV DOCK.DSN				
Schematic Name Docking Payload		Page Name Docking Component Overview Rev2		Layout File

Urethane Potting Boundary